


THE STAR COAL MINE.

11382 M 10 ac. County Devon.

New Bed. Vicinity Railton.

Scale 1 inch = 40 ft.

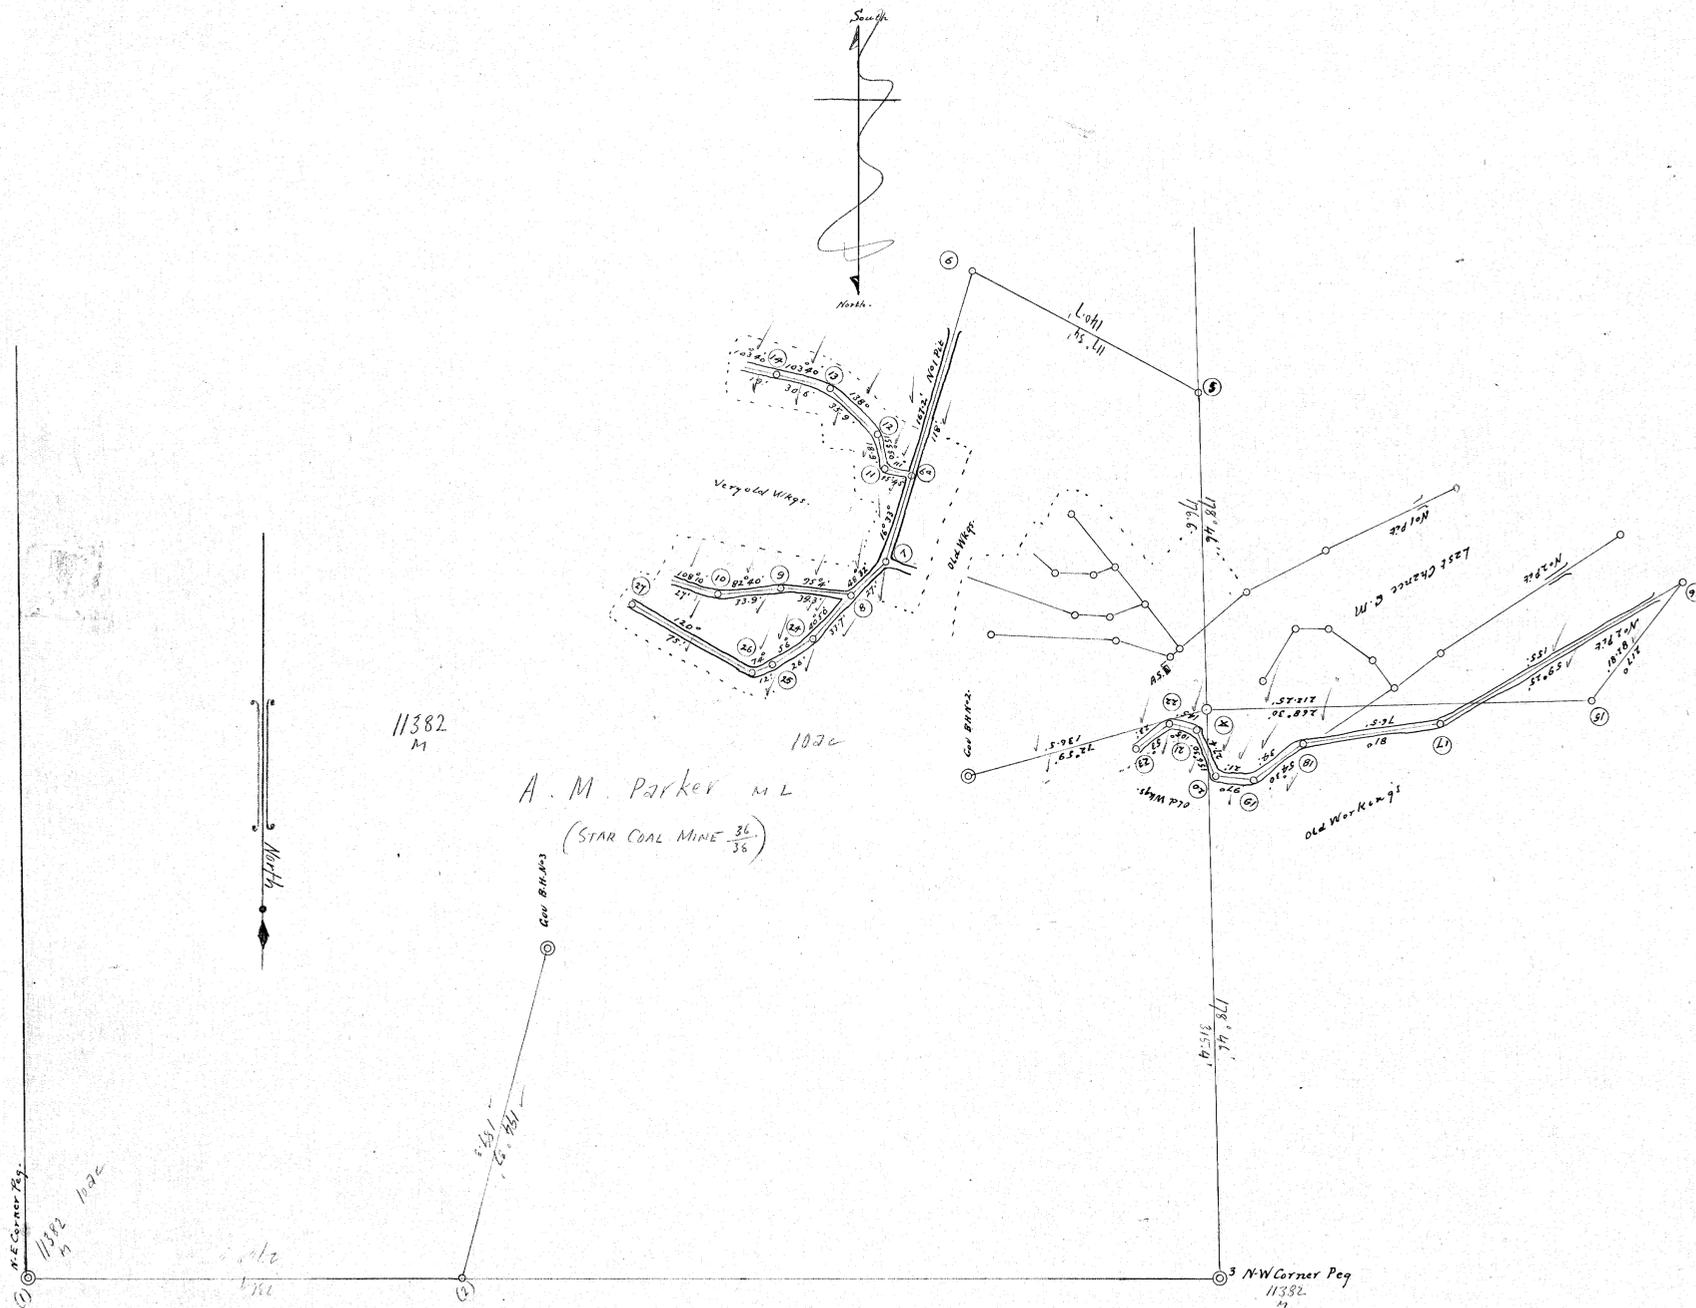

Date Surveyed	Office Examination
Mar. 25	9 2 37
Aug. 26	

*R. A. Vanhook
Surveyor General
24/1/17
R. D. 1912*

2-01