



TASMAN AND CROWN LYELL EXTENDED MINES NO LIA

EXTENSIONS FOR YEAR 1912.13.14

UNDERGROUND WORKINGS CONNECTED WITH SHAFT

SCALE AN INCH = 30 FEET

*Edward Carter
mine manager
18/3/15*

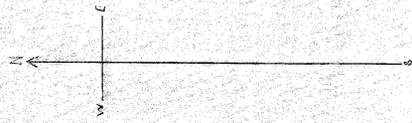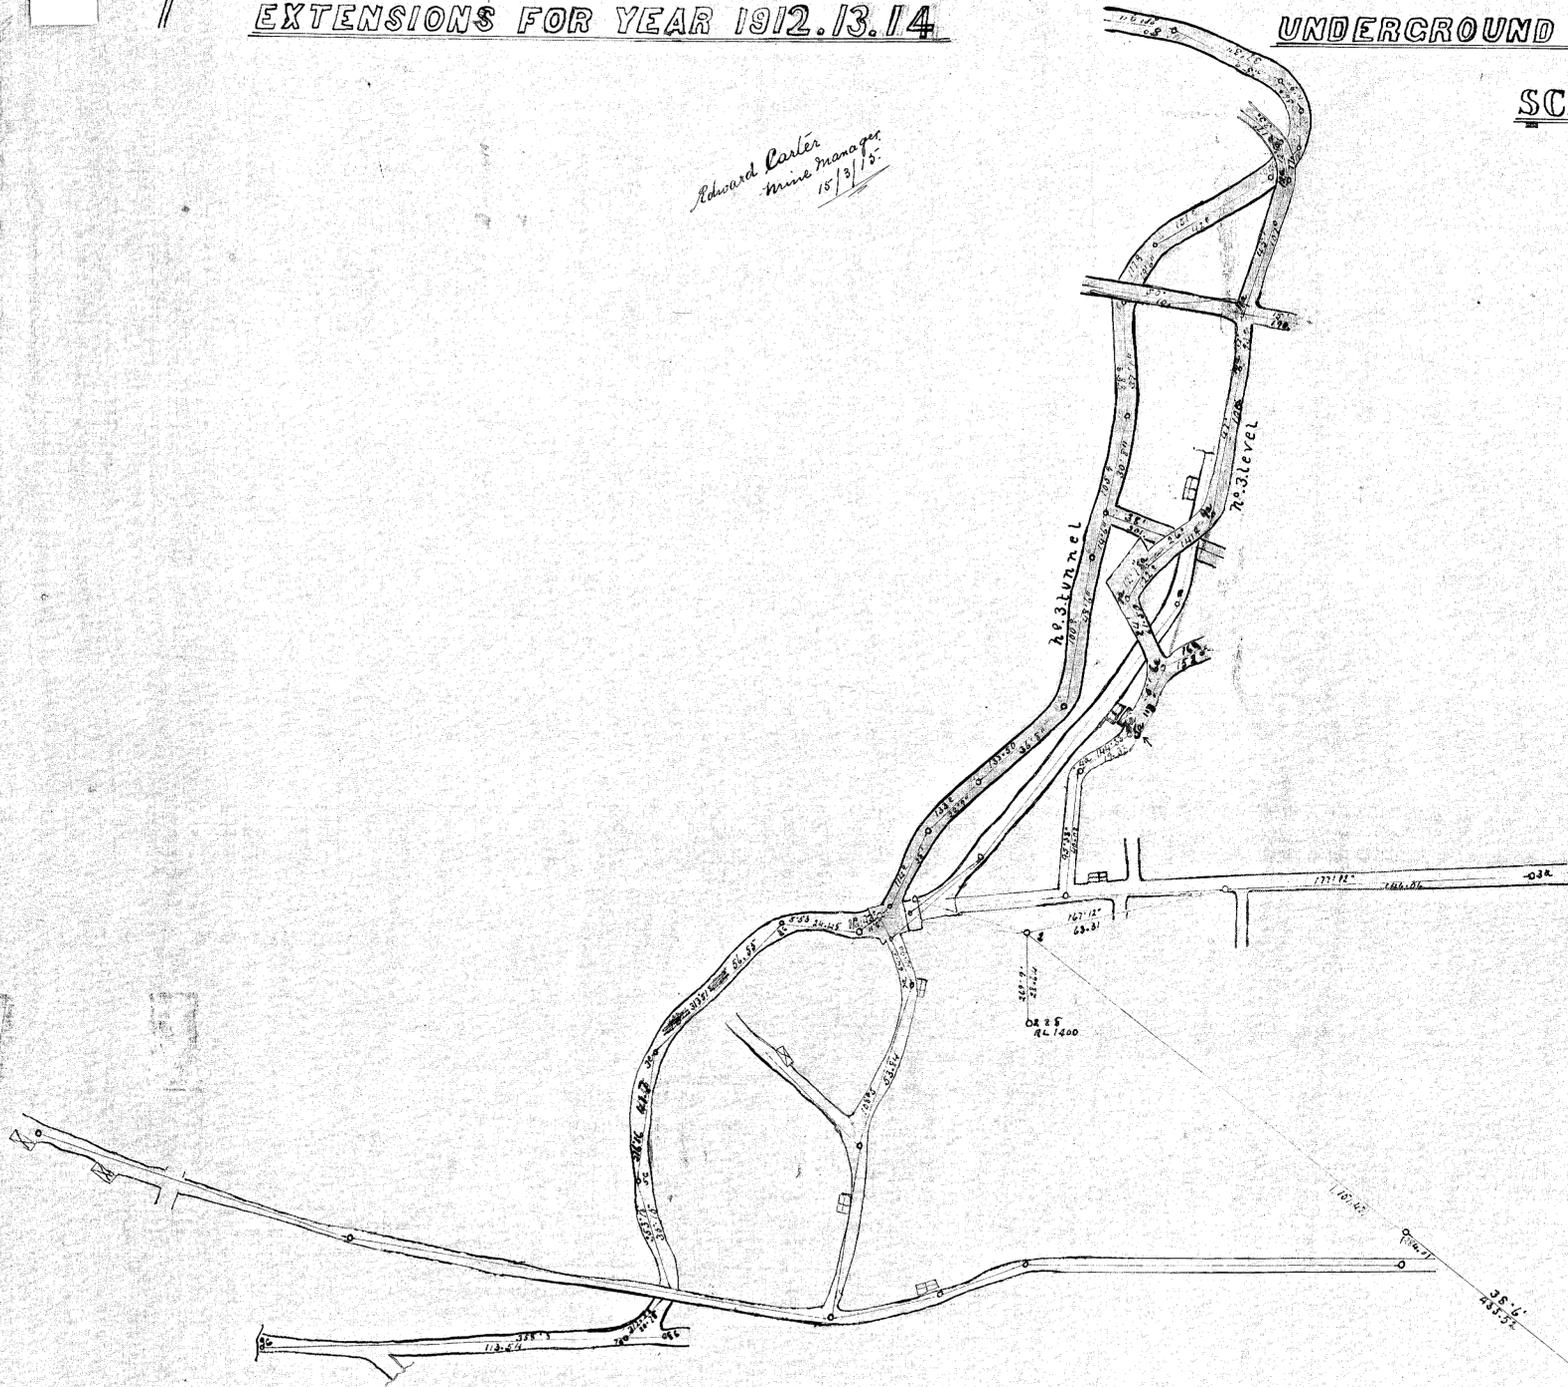

4-01

MOUNT LYELL COMSTOCK

CO

2135
91 M

2136
91 M

118