
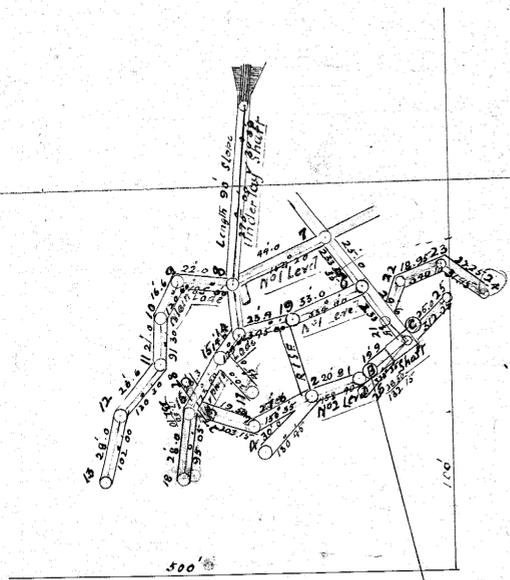


8218
M

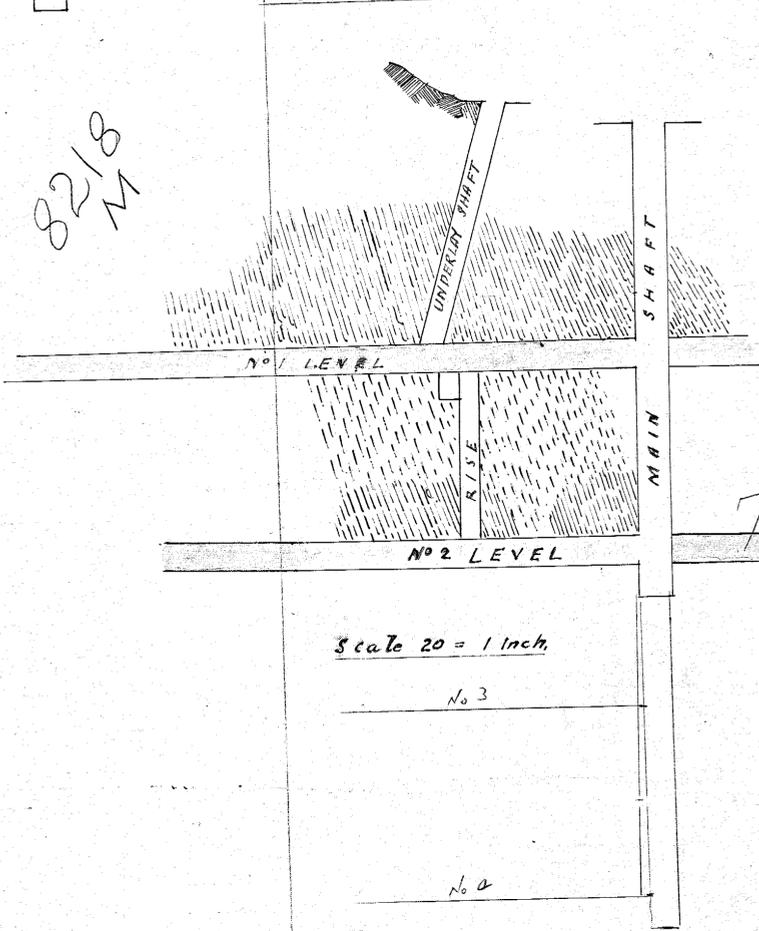

SWANSEA SYN^D

SECTION N^o 7351.

Scale 40' = 1 Inch **M.**
 Theodolite Survey
 A. Dalton
 24/1/22

Exd.
 31-10-22.
 Extended
 30/1/23
 AB

5-01

1000ths

180°00'

1000ths

599.6

257.60

270.00

5
11