



5 cm

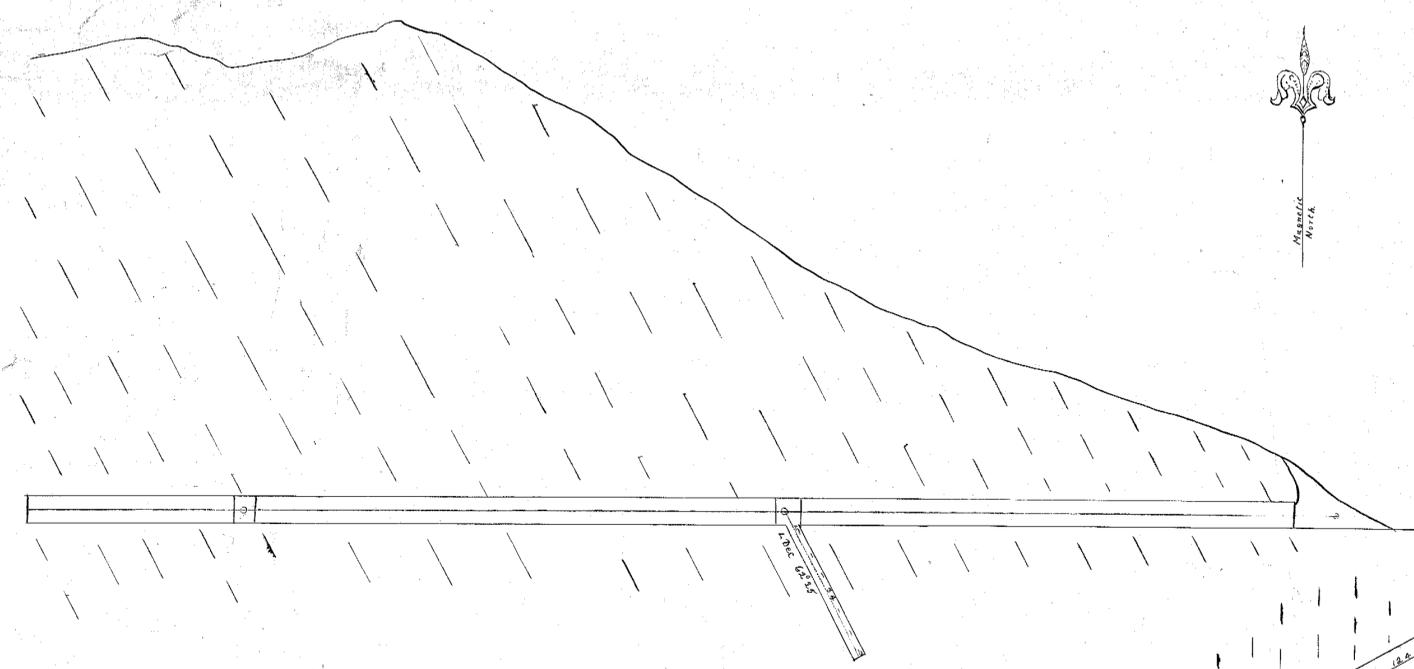

LONGITUDINAL SECTION

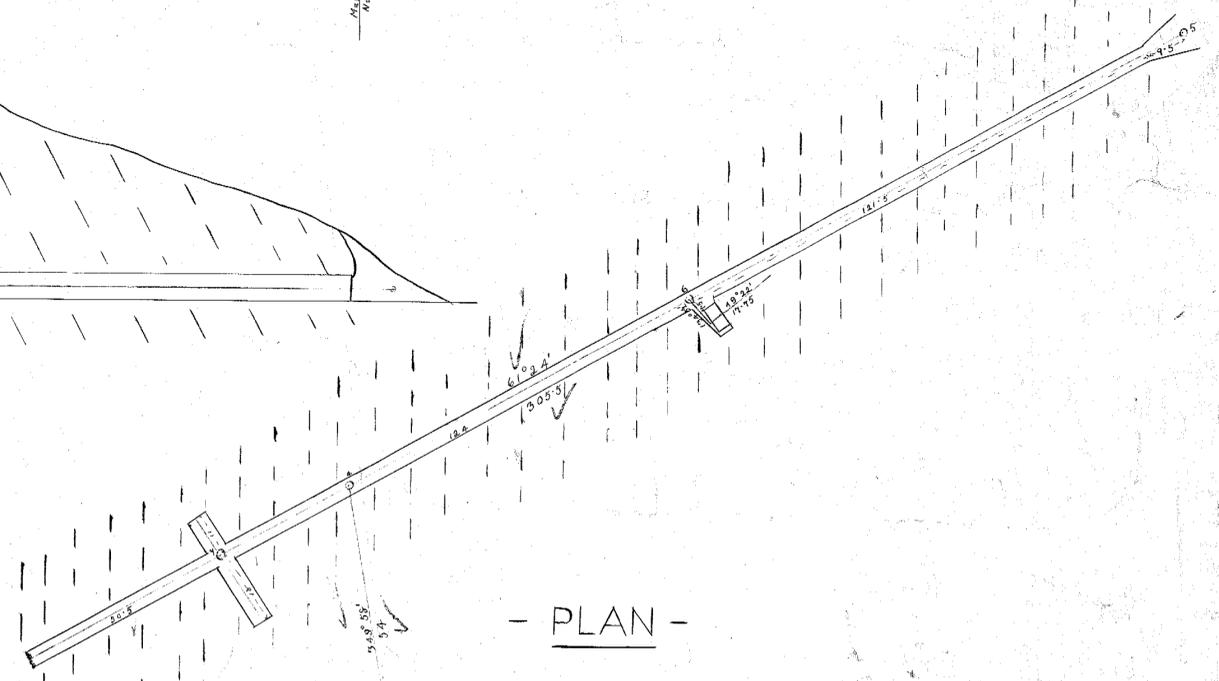

PLAN


Measurements in Feet

JUPITER MINING CO. N.L.

409
93 M 40 Acres

Scale - 25 Feet to 1 Inch

Instrument used - Y Theodolite

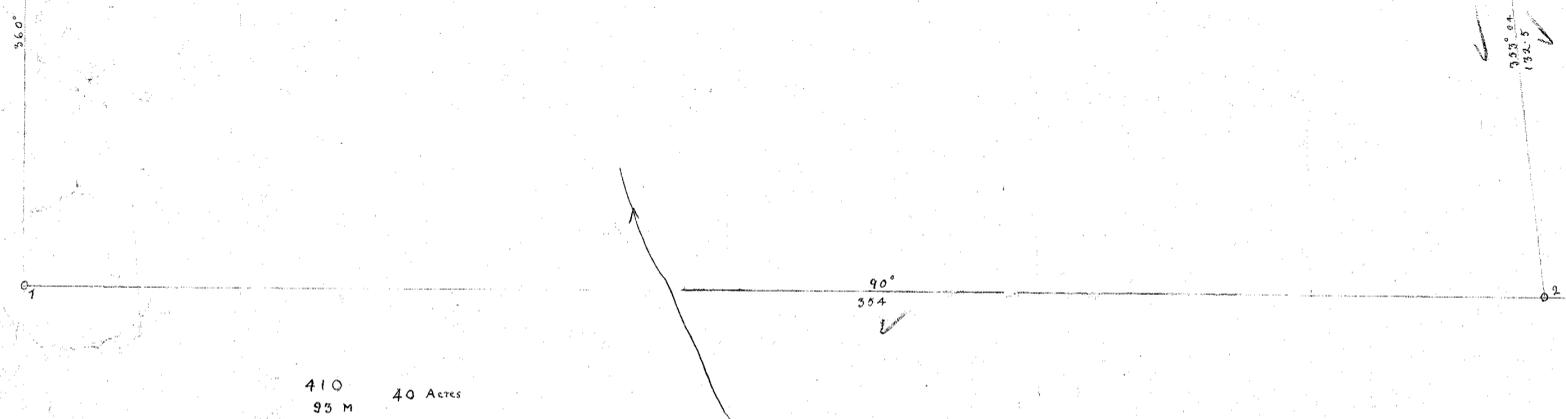

410
95 M 40 Acres

H. G. Buckhill S. M. B.

Dec 31st 1898

Mine Manager.

6-01

6