



70-6

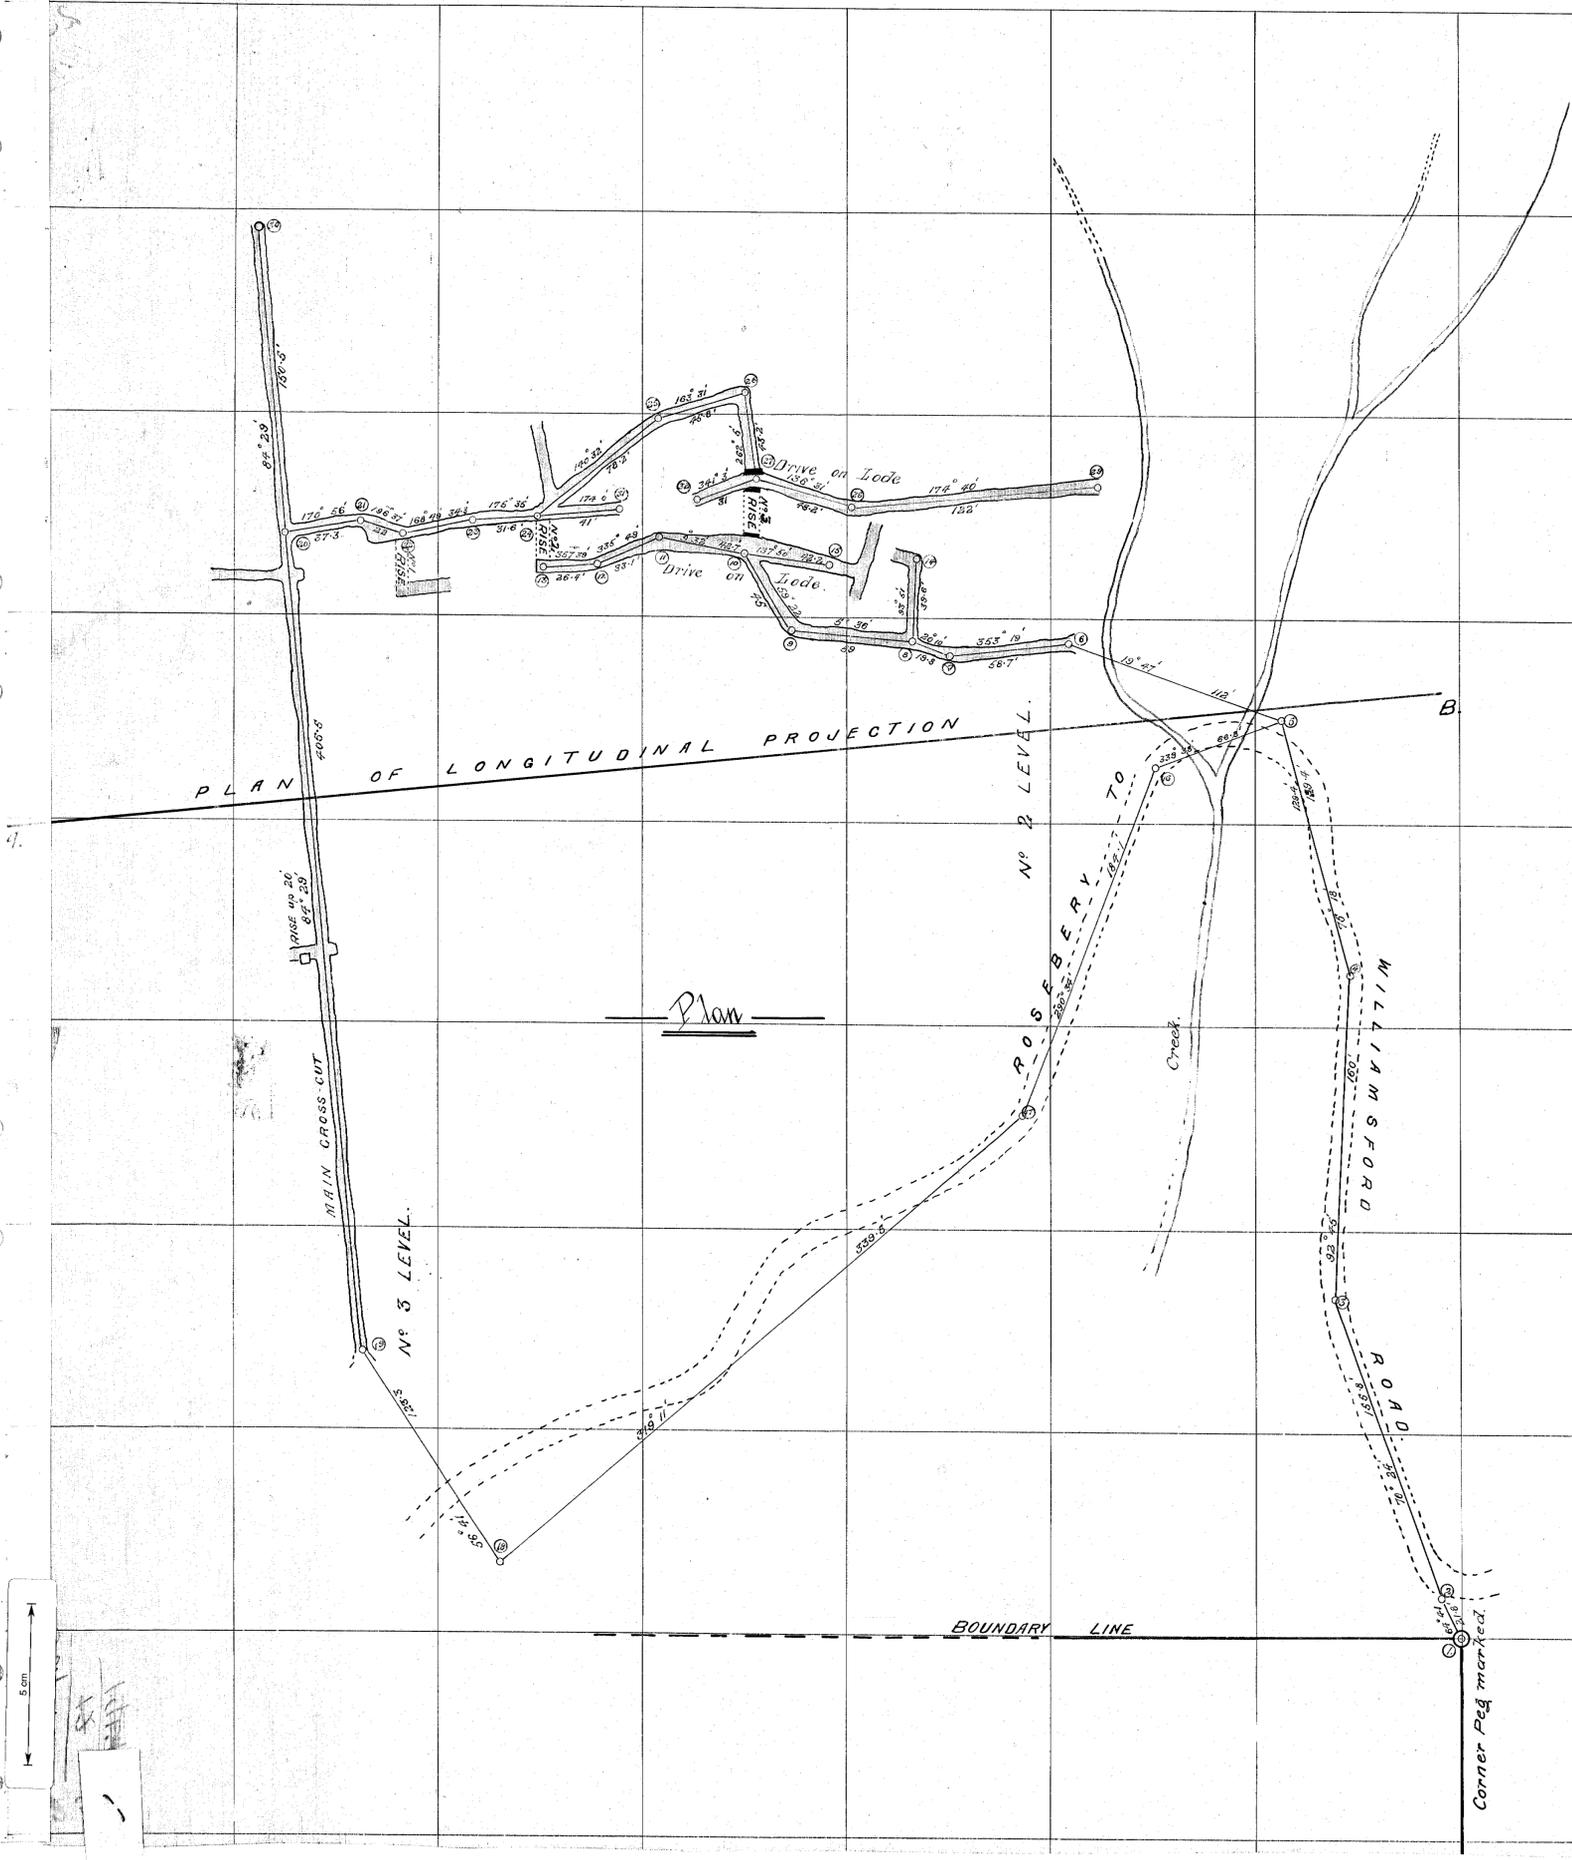


Plan

Jupiter Mine  
 Underground workings - Plan and Section  
 Scale 40' - one inch

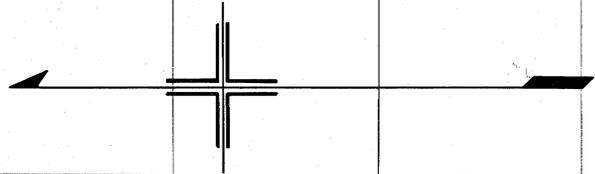

Section

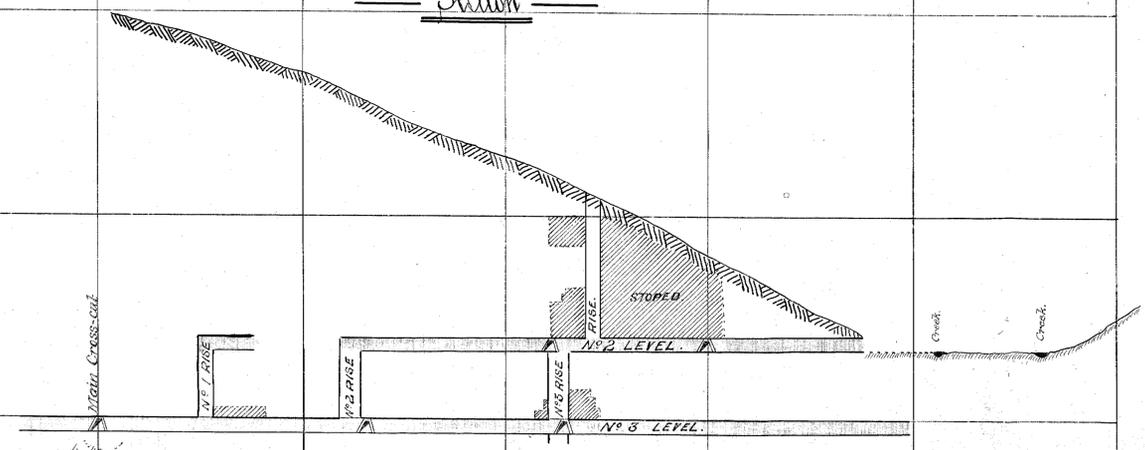

50m

W. Judson  
 Ad. Mine Mgr. 1918  
 JUPITER MINE NO. 1018  
 "Old survey re-checked & new work added"  
 5" Transit & steel tape.

6-02

H. B. Schell, Mine Surveyor  
 July 16, 1918.