


Date of Survey	Office examination
23-4-33	3-7-1933 M
26-3-35	16-4-1934 "
	12-2-1937 "

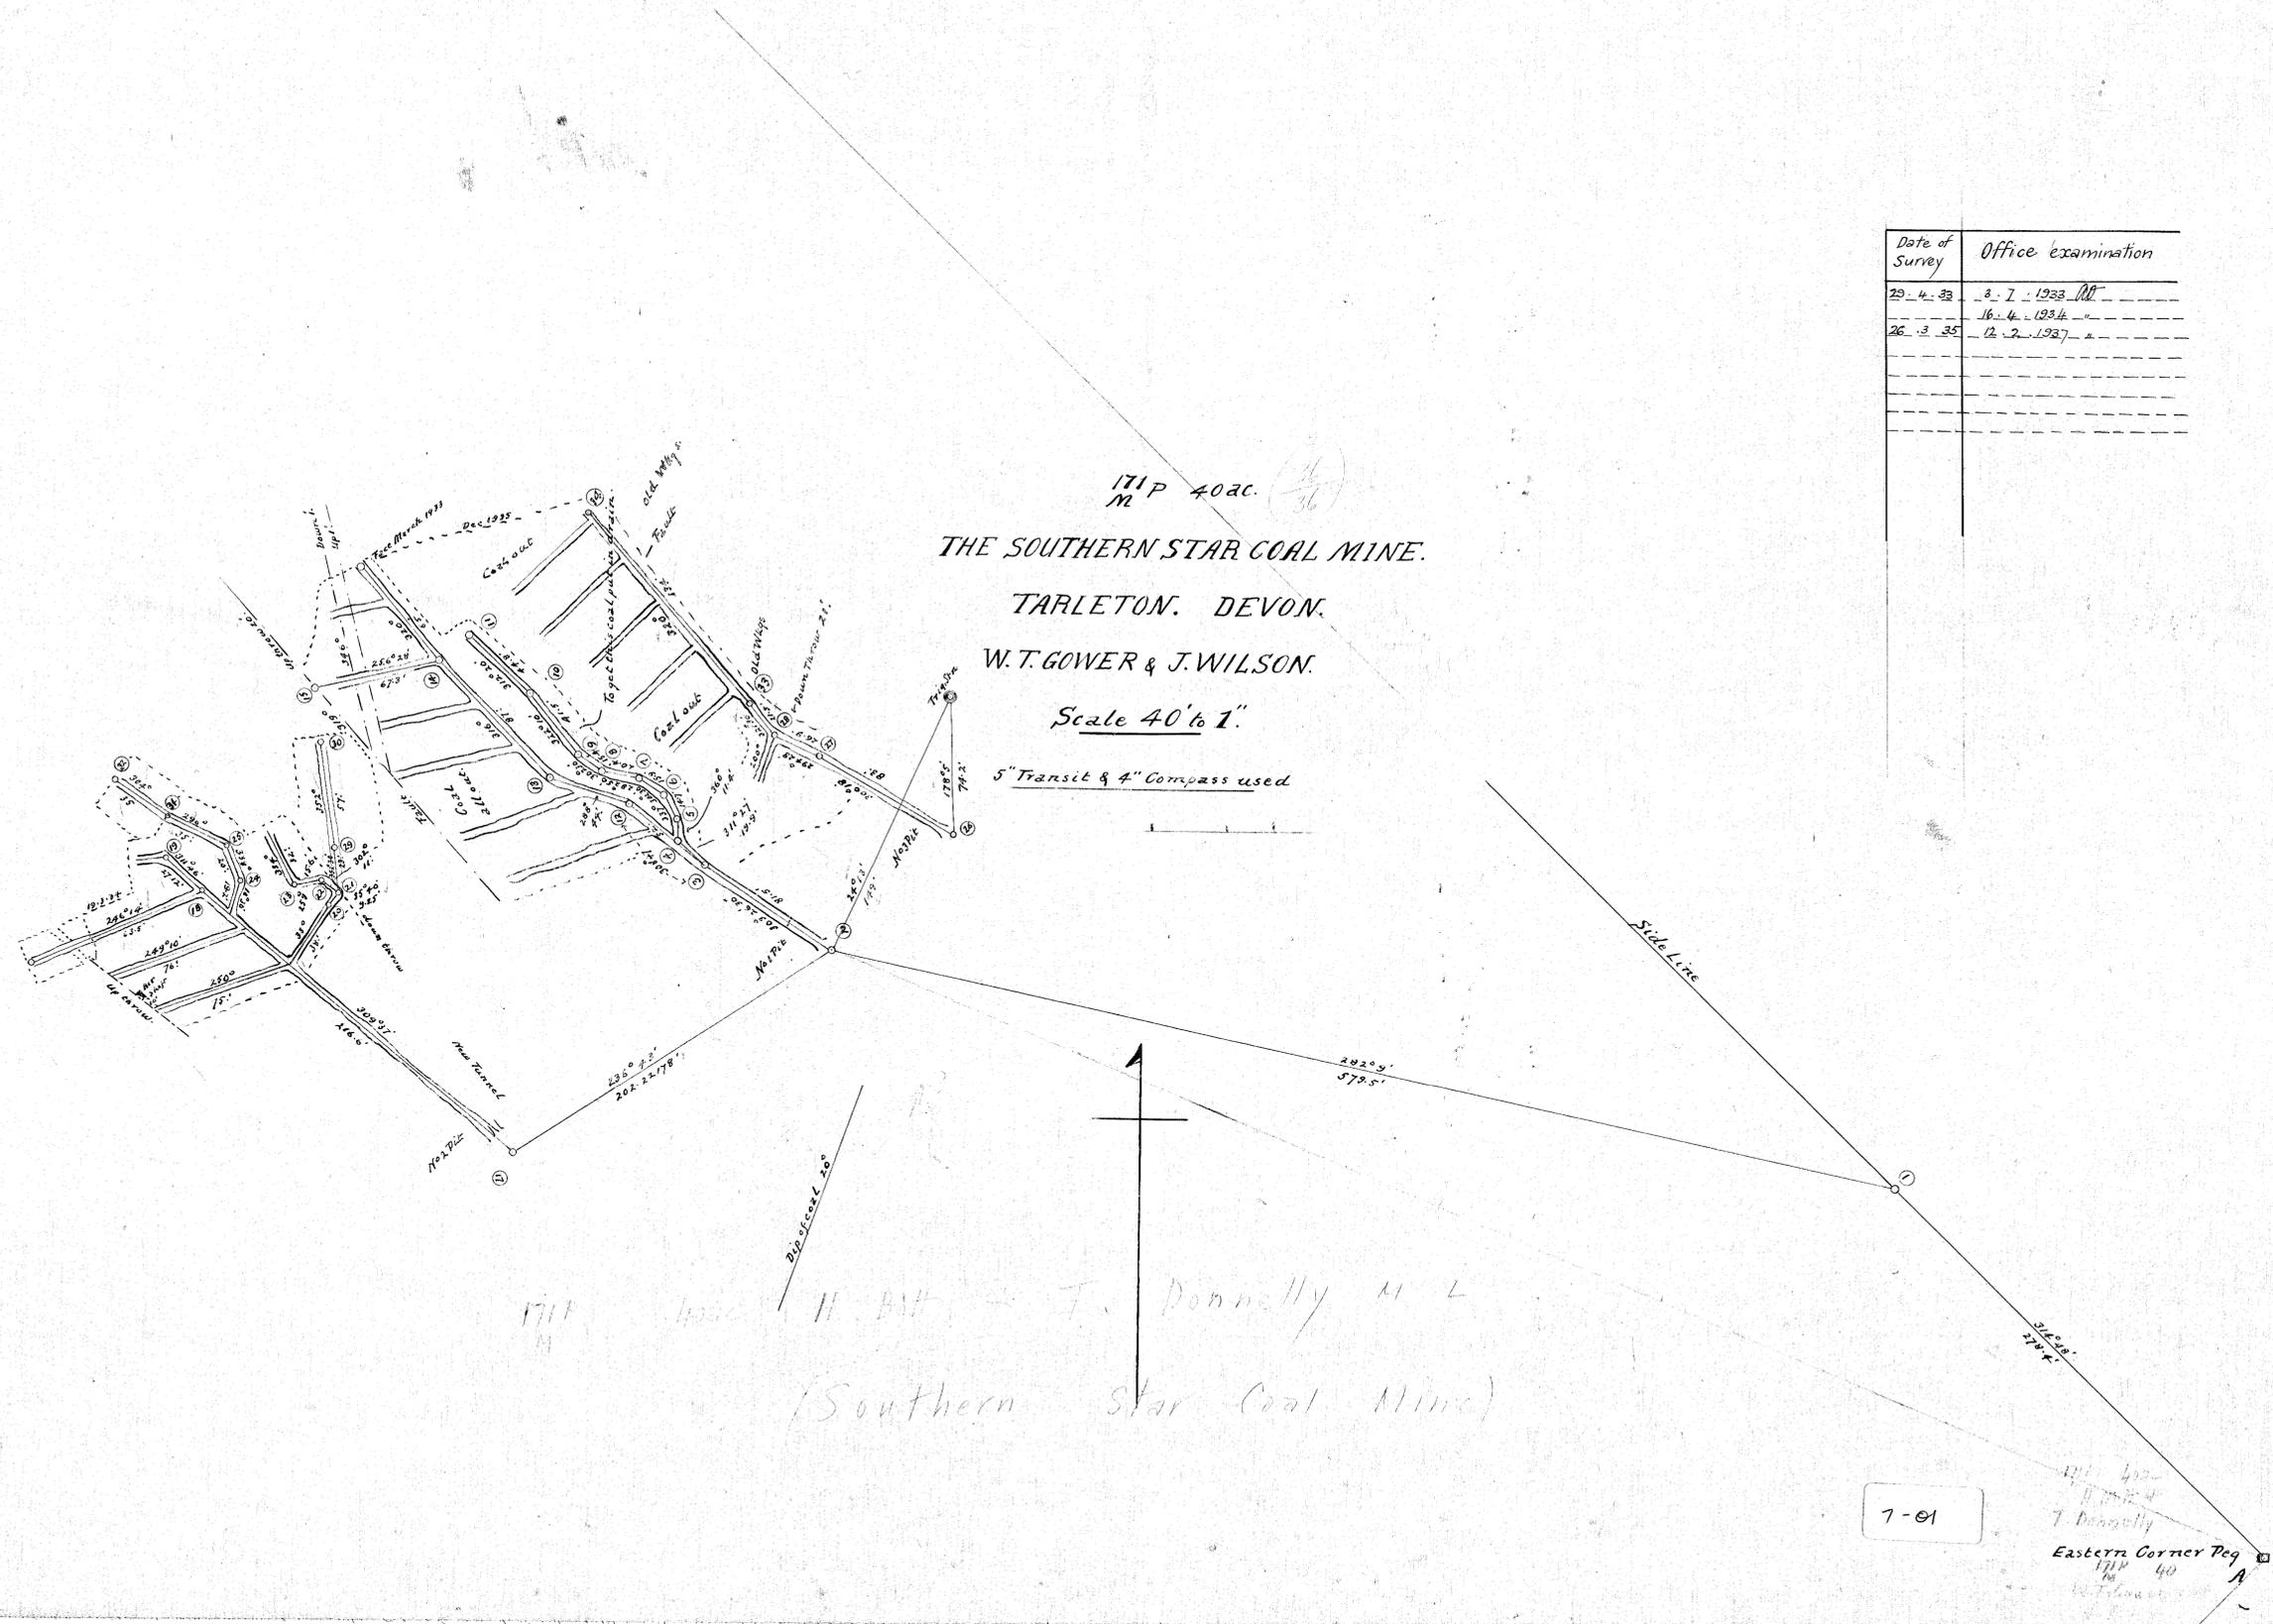

171P 40ac. (36)
M
THE SOUTHERN STAR COAL MINE.
TARLETON. DEVON.
W. T. GOWER & J. WILSON.
Scale 40' to 1".
5" Transit & 4" Compass used

171P 40ac. H. Bitt. & T. Donnelly M L
(Southern Star Coal Mine)

7-01
171P 40ac.
H. Bitt. & T. Donnelly
Eastern Corner Peg
171P 40
W. T. Gower & J. Wilson

