




5 cm

1567  
936

**FIELD NOTES**

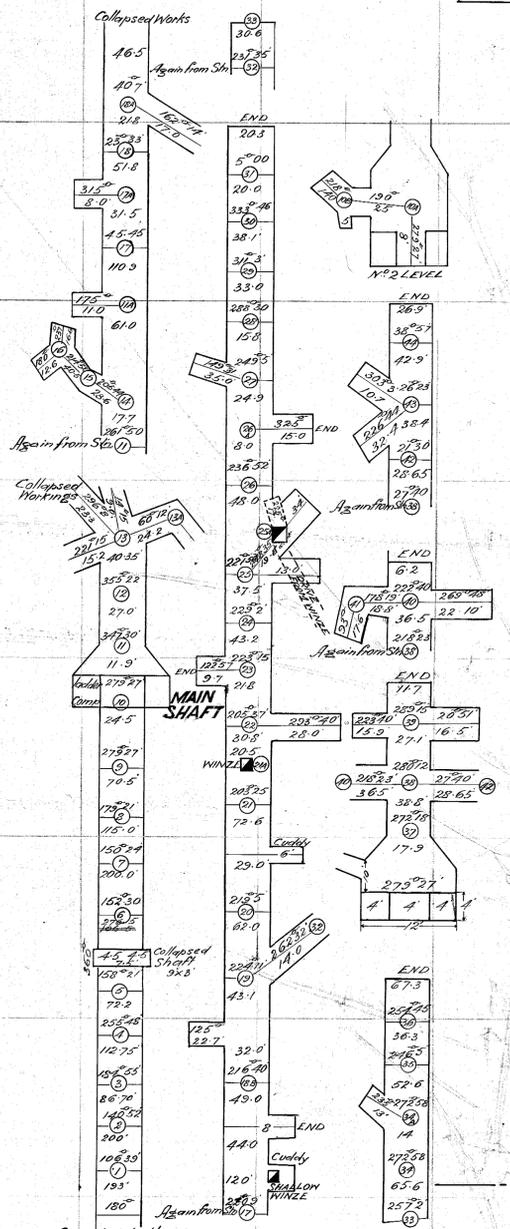

120P  
G

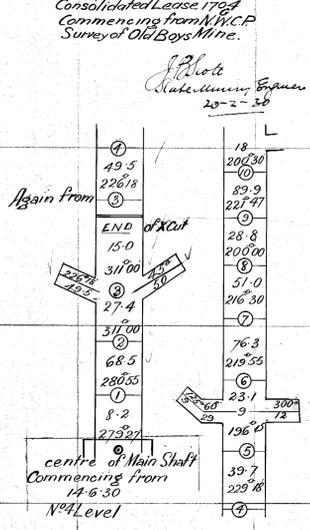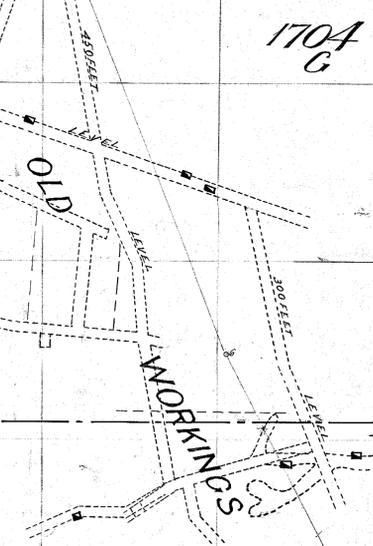

**UNDERGROUND WORKINGS  
OLD BOYS MINE**

Scale  
1 Inch = 40 Feet

Instrument used - 4" theodolite

