


THE BRISEIS TIN AND GENERAL MINING COY LTD

PLAN OF UNDERGROUND WORKINGS YEAR ENDING 31ST DEC 1918




SCALE - 1 INCH = 40 FEET.

INSTRUMENT USED 5 INCH THEODOLITE.


W. A. Karnik
Geophysical Manager.
 2/7/19.

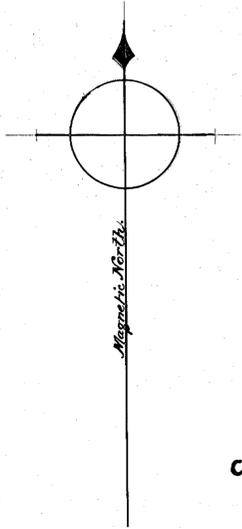

CONSOLIDATED LEASE N^o 6953
 M.

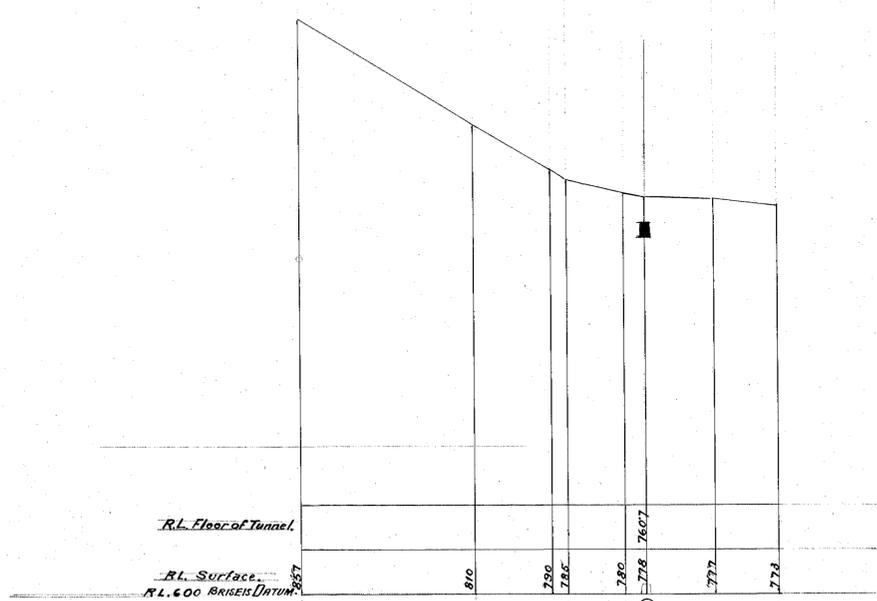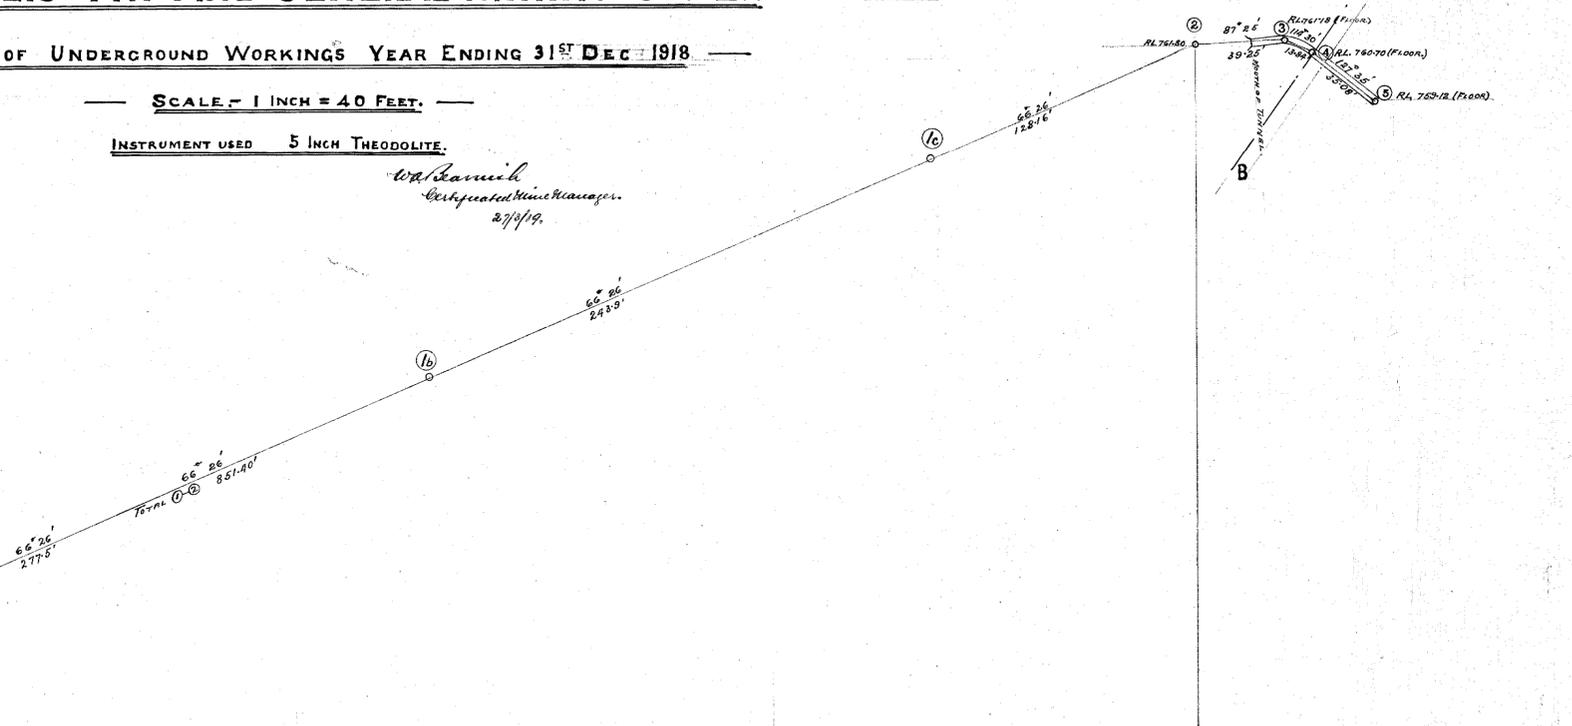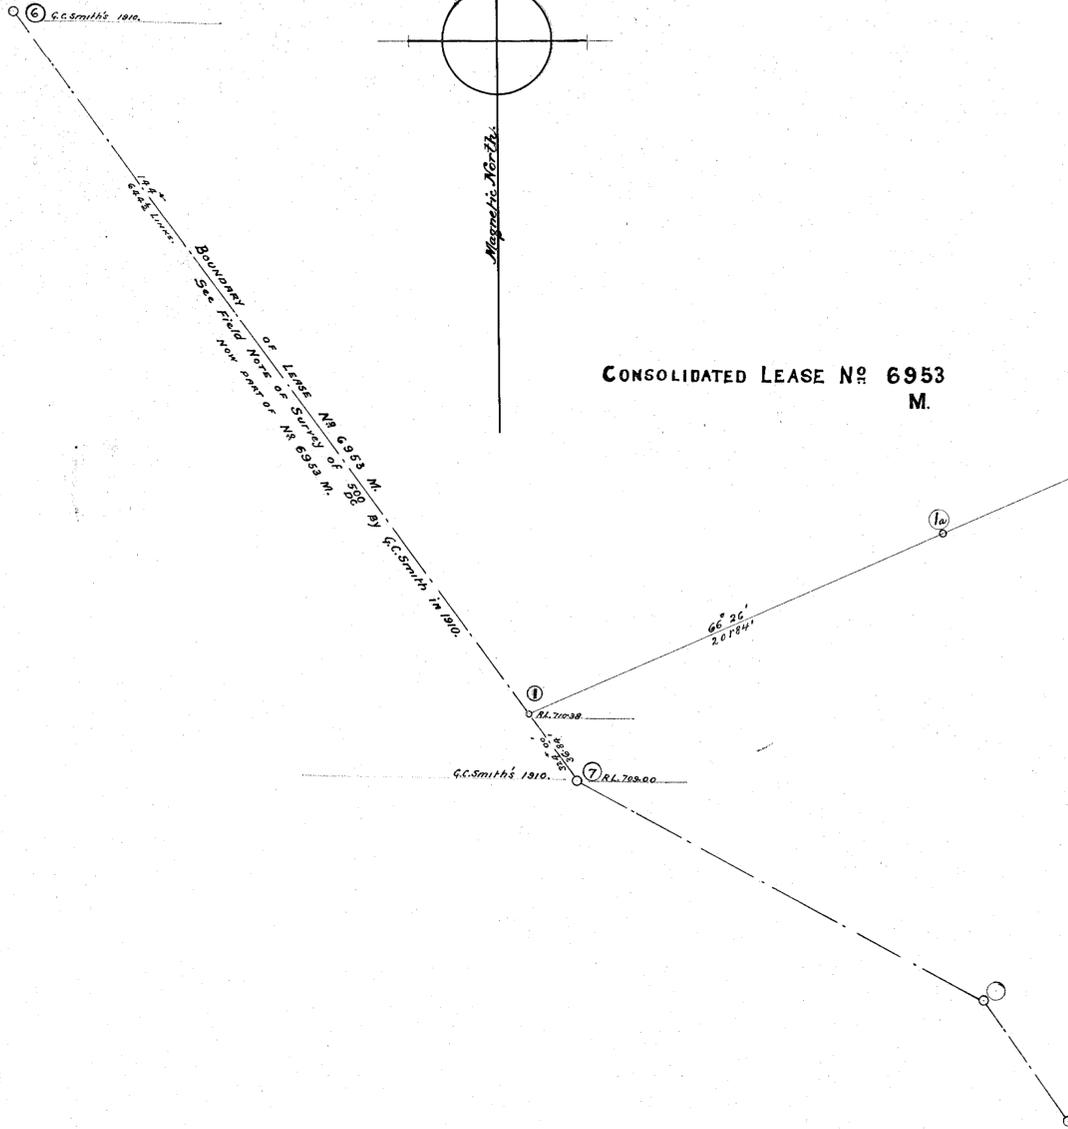

CROSS SECTION A. B.
 Looking S.E.

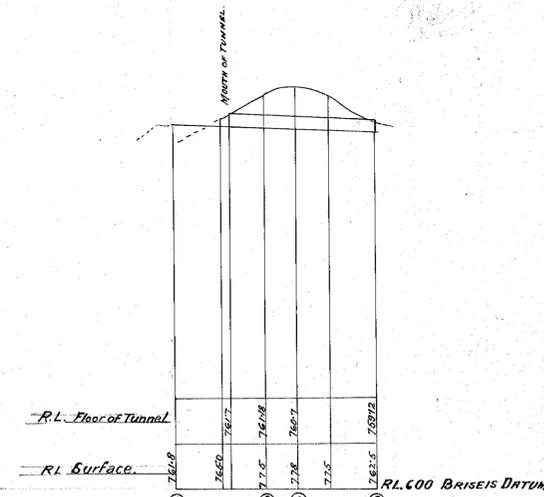

LONGITUDINAL SECTION
 Looking N.E.

5 cm