


UG 12

LANGLOH COAL MINE

SHEET 2

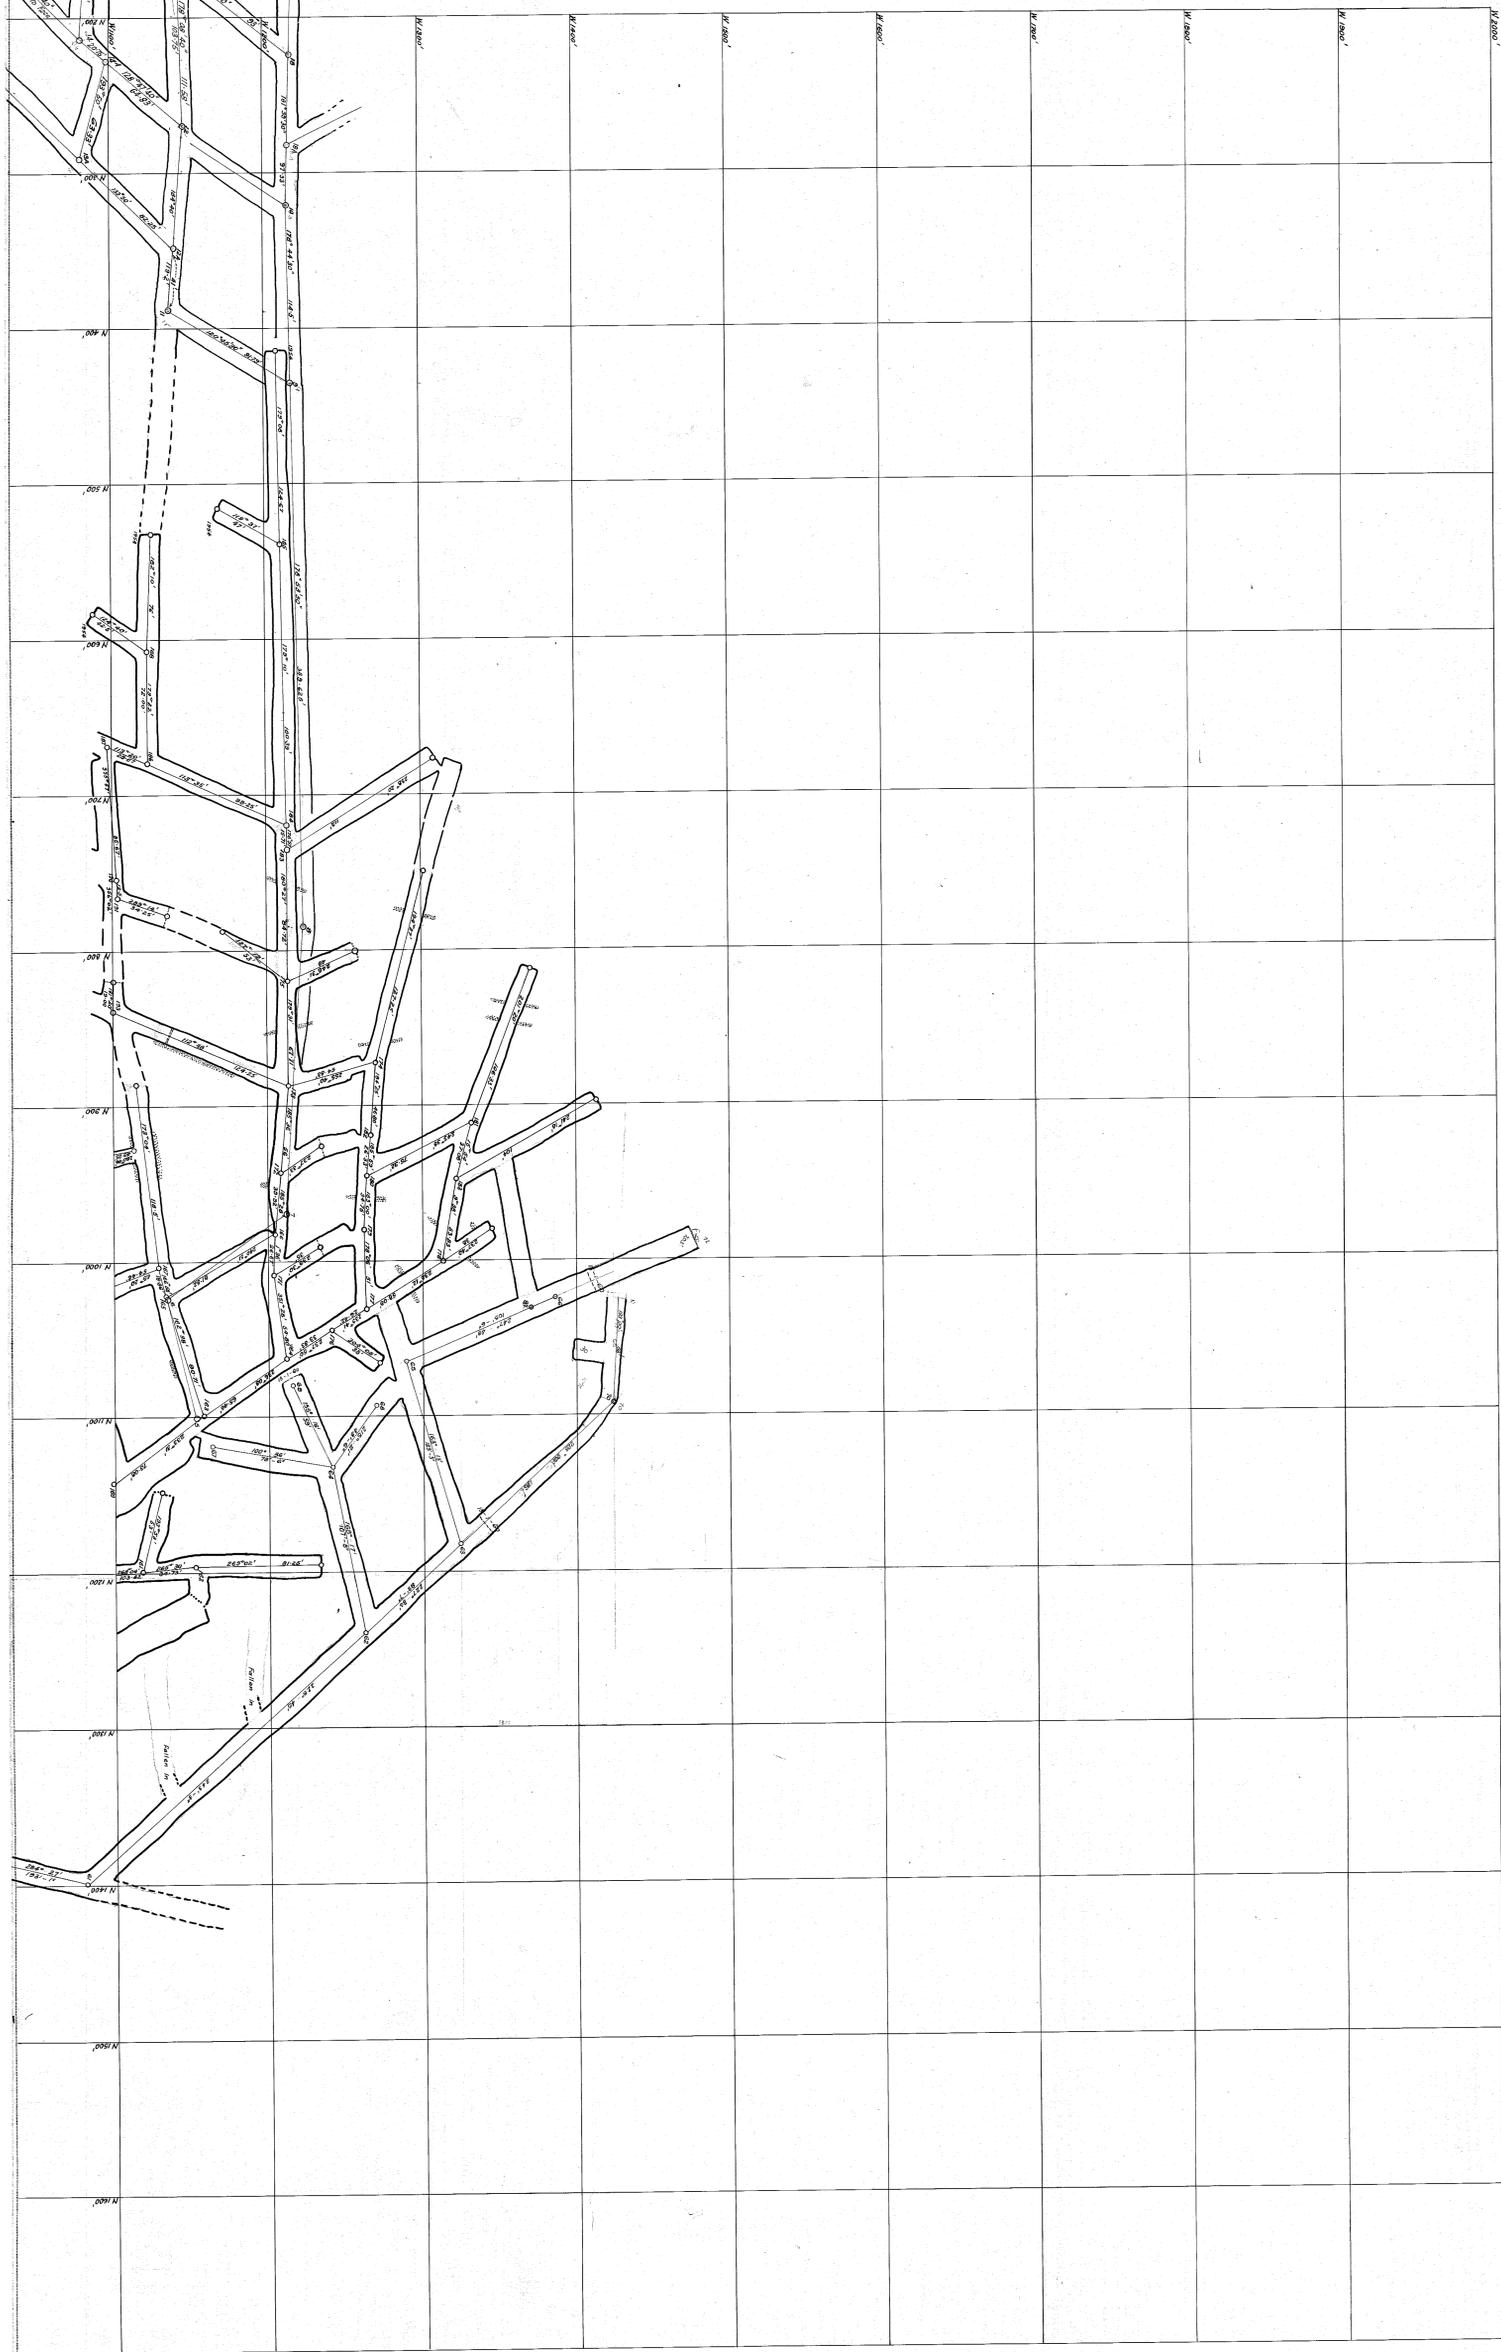

12-01

revised