
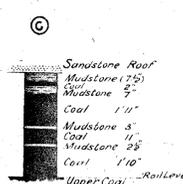
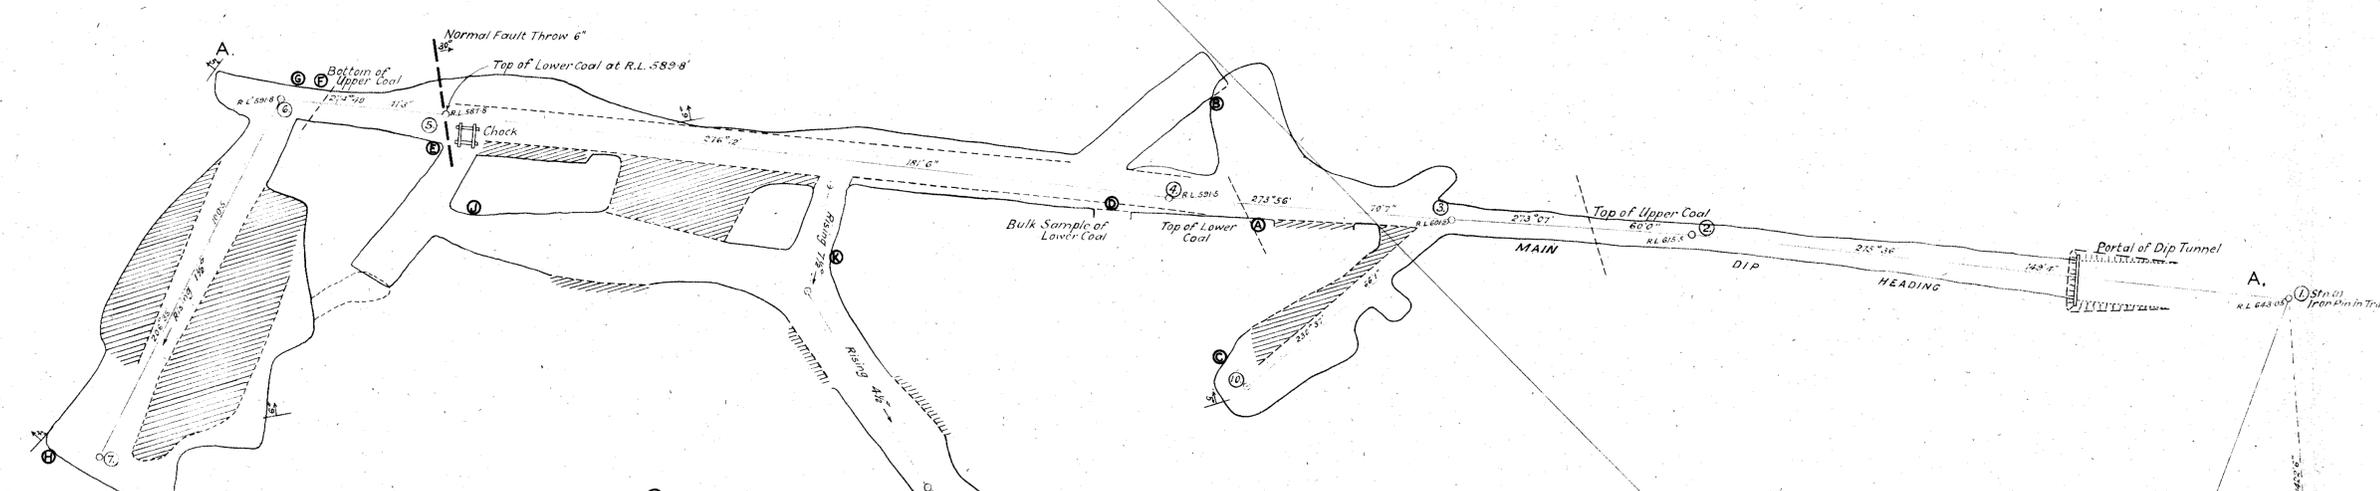



PLAN OF LANGLOH COAL MINE SHOWING WORKINGS, SECTIONS, AND ASSAYS.

SCALES: PLAN & SECTIONS 20 FEET = 1 INCH
FACE SECTIONS 5 FEET = 1 INCH
WORKINGS SHOWN THUS

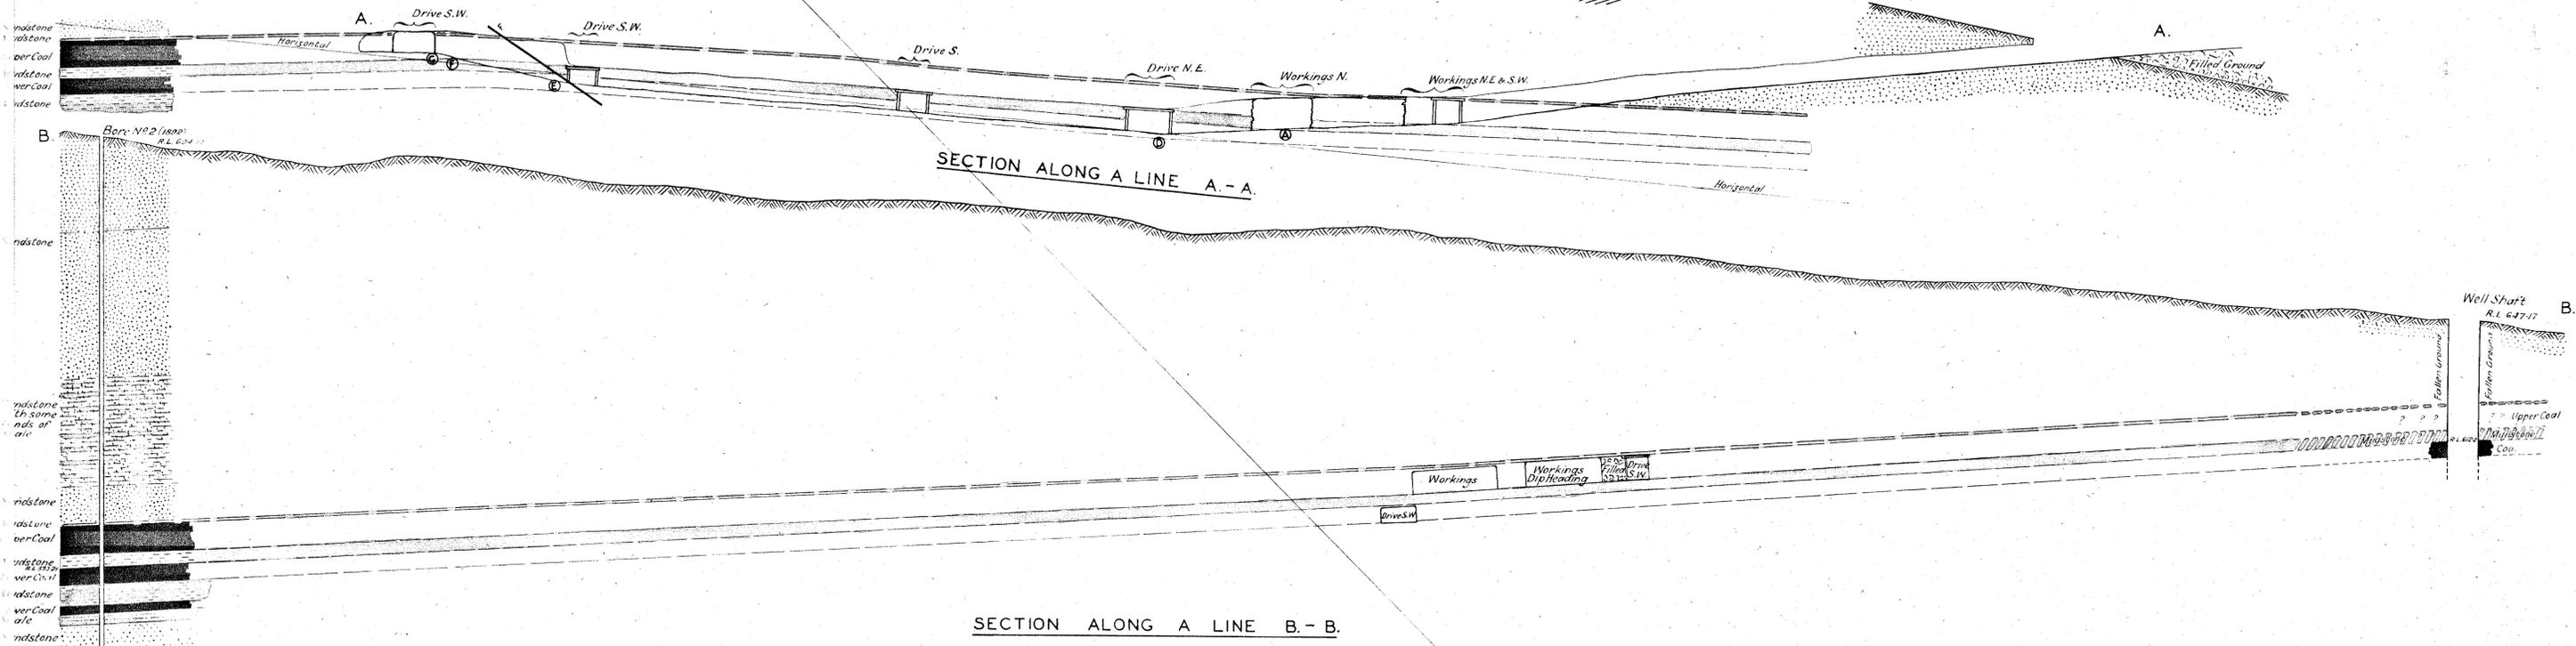


ANALYSIS

Sample No.	L1.	L2.
Moisture	2.28	2.50
Volatile C.M.	23.68	22.10
Fixed Carbon	54.74	52.42
Ash	19.30	22.98
Sulphur	0.37	0.42
B.T.U's	11050	10650

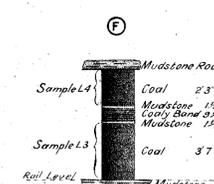


ANALYSIS

Sample No.	L3.	L4.
Moisture	2.11	2.94
Volatile C.M.	24.32	24.36
Fixed Carbon	54.51	42.10
Ash	19.06	30.60
Sulphur	0.38	0.35
B.T.U's	11180	9230

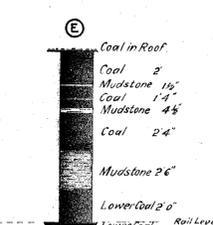

ANALYSIS

Sample No.	L5.
Moisture	2.04
Volatile C.M.	24.90
Fixed Carbon	54.92
Ash	18.14
Sulphur	0.35
B.T.U's	11450

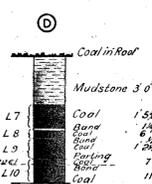

ANALYSIS

Sample No.	L7.	L8.	L9.	L10.
Moisture	1.80	1.91	1.96	2.36
Volatile C.M.	26.65	24.86	25.76	24.34
Fixed Carbon	57.73	53.59	54.28	45.04
Ash	13.52	19.64	18.00	27.66
Sulphur	0.35	0.32	0.28	0.33
B.T.U's	12020	11180	11360	9900

