




LANGLOH COAL MINE

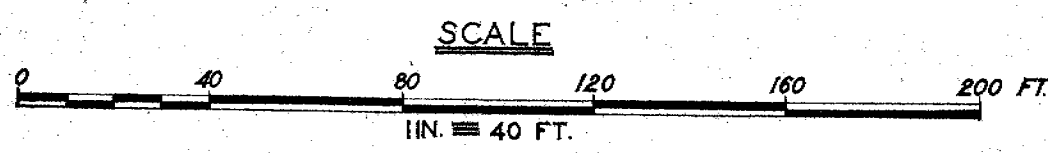

Nath. A. Bacon, A.O.S.M.
TECHNICAL & ADMINISTRATIVE ASST
APR. 1950

- LEGEND—
- BRATTICES
 - DOORMAYS
 - COLLAPSED ROADWAYS

N.B. SURVEY BY THEODOLITE.

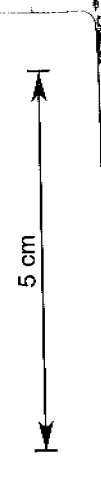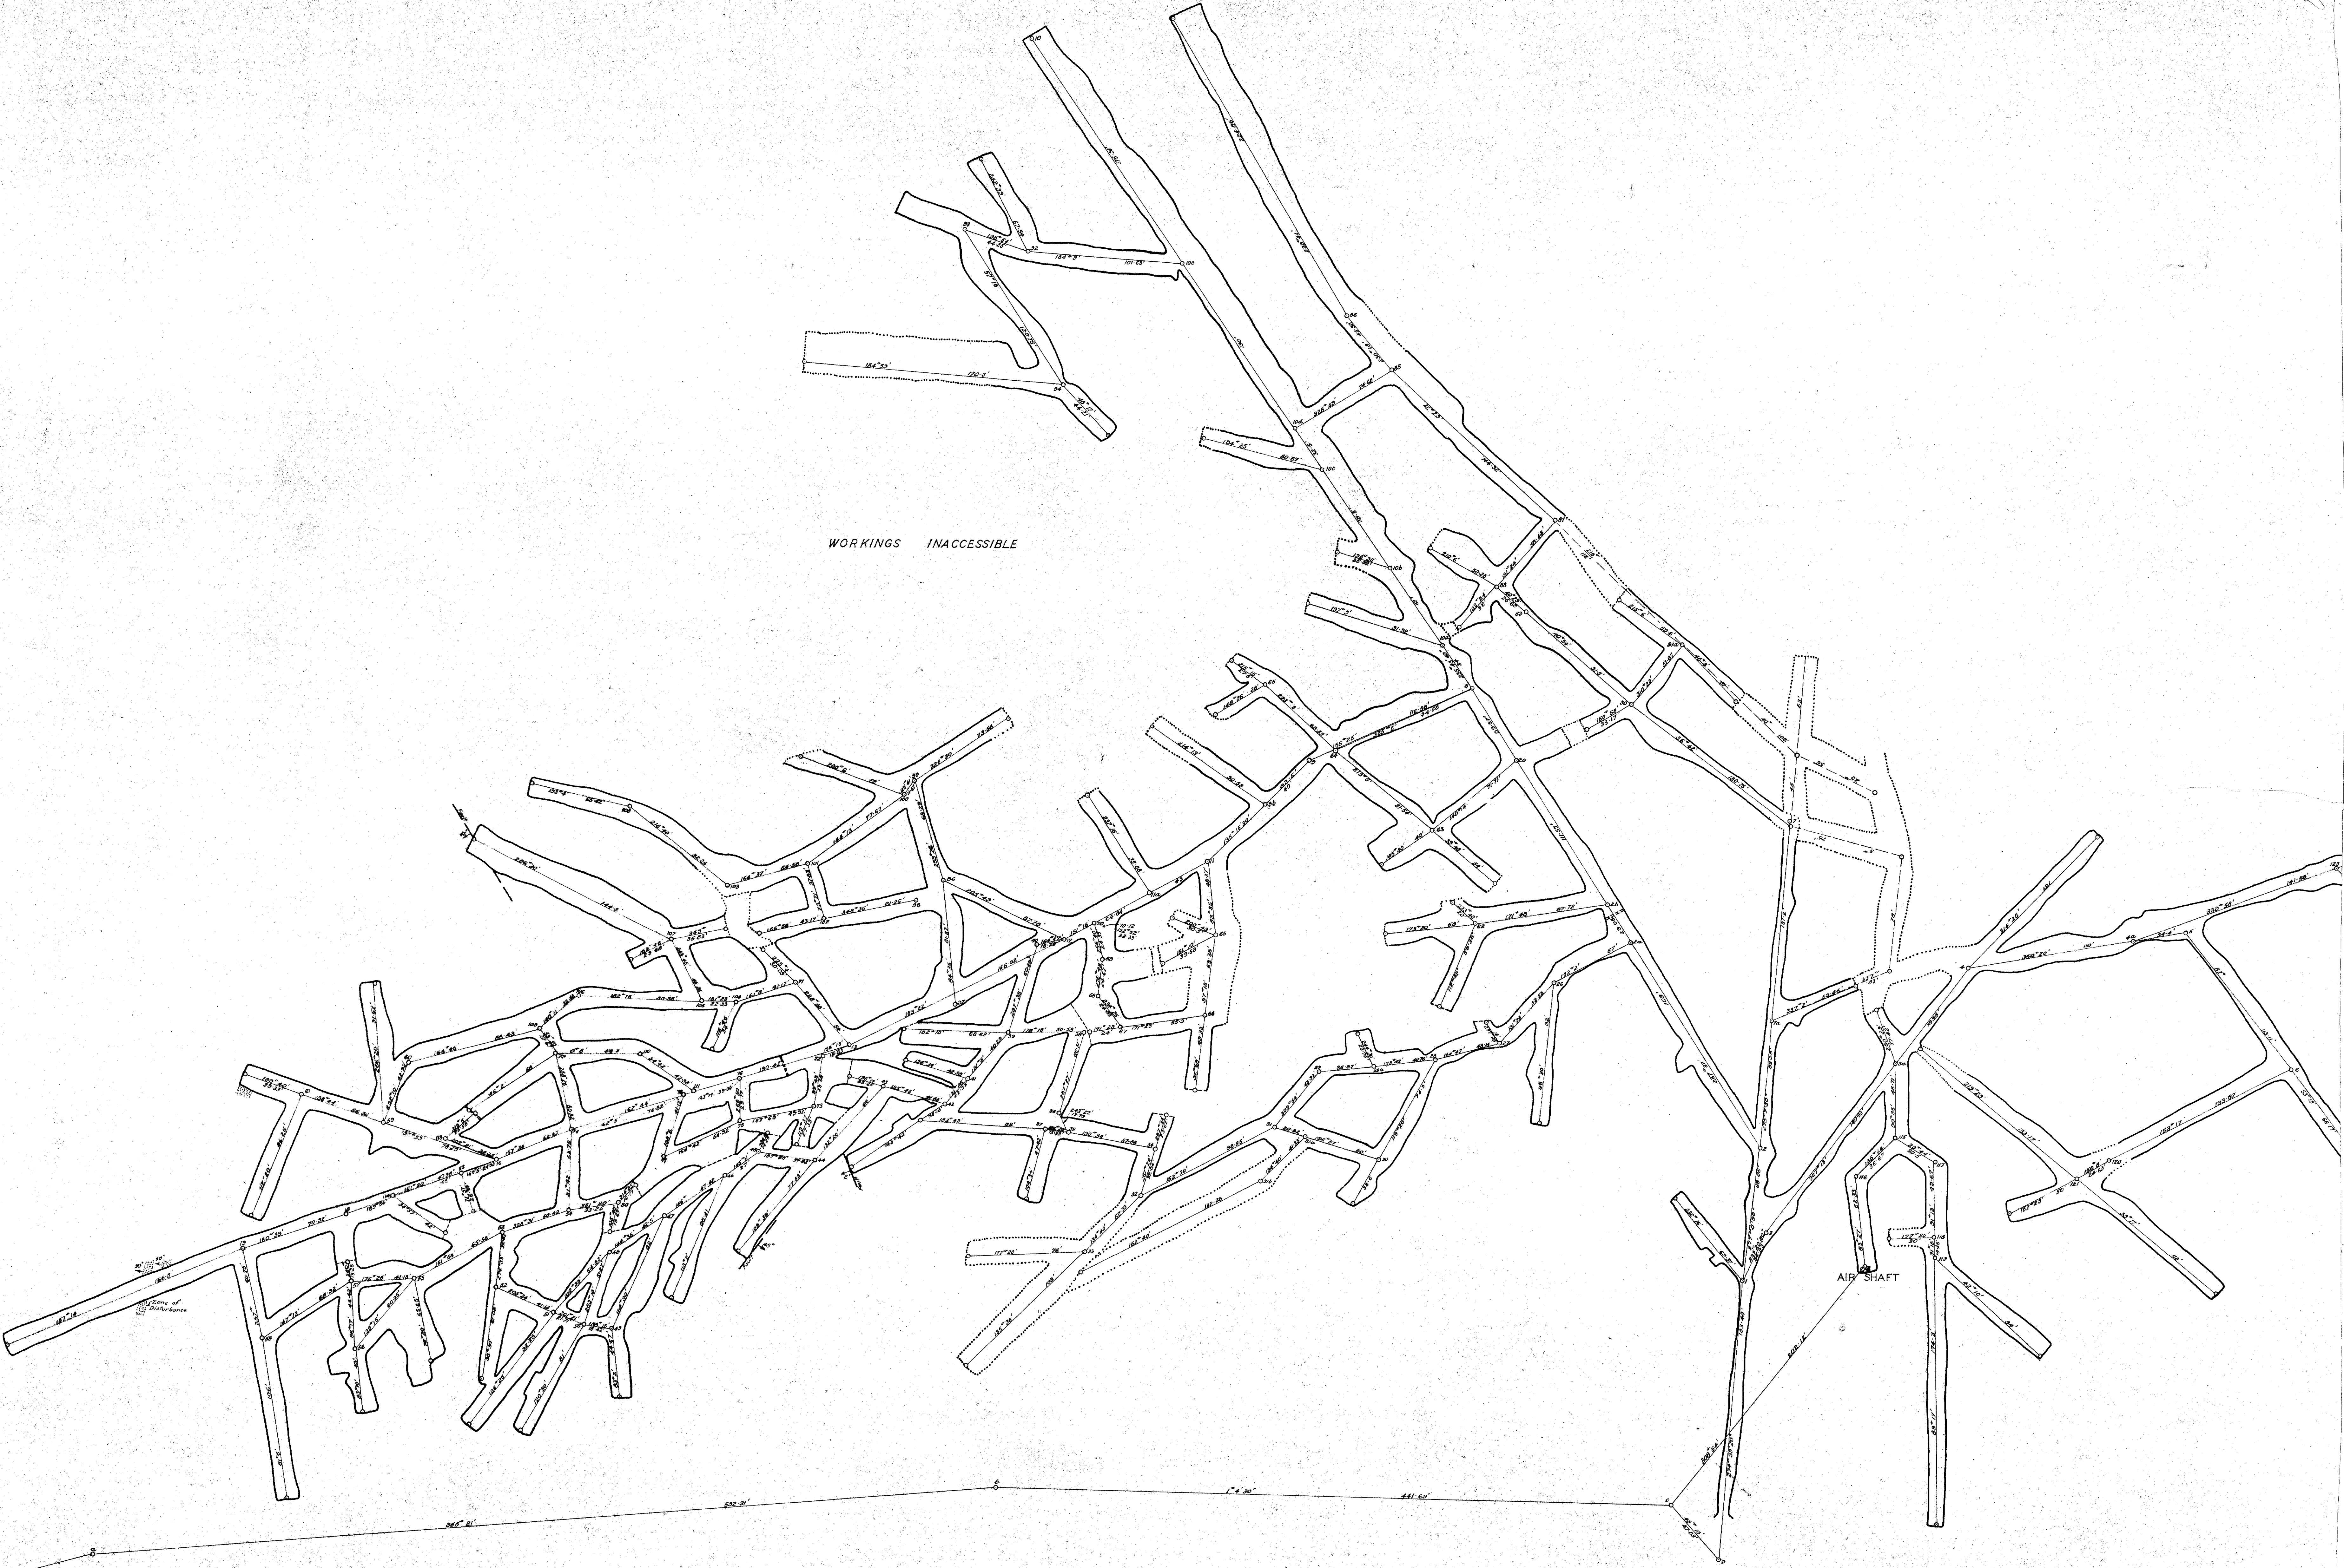

283P
M. E. GORRINGE M.L.