



# LANGLOH COAL MINE

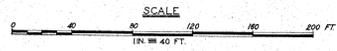

*Walter A. Bacon* A.O.S.M.  
TECHNICAL & ADMINISTRATIVE ASST  
APR 1933  
MAY 1933

- LEGEND—
- BRATTICES
  - DOORWAYS
  - COLLAPSED ROADWAYS
  - ZONES OF DISTURBANCE
- N.B. SURVEY BY THEODOLITE.

WORKINGS INACCESSIBLE

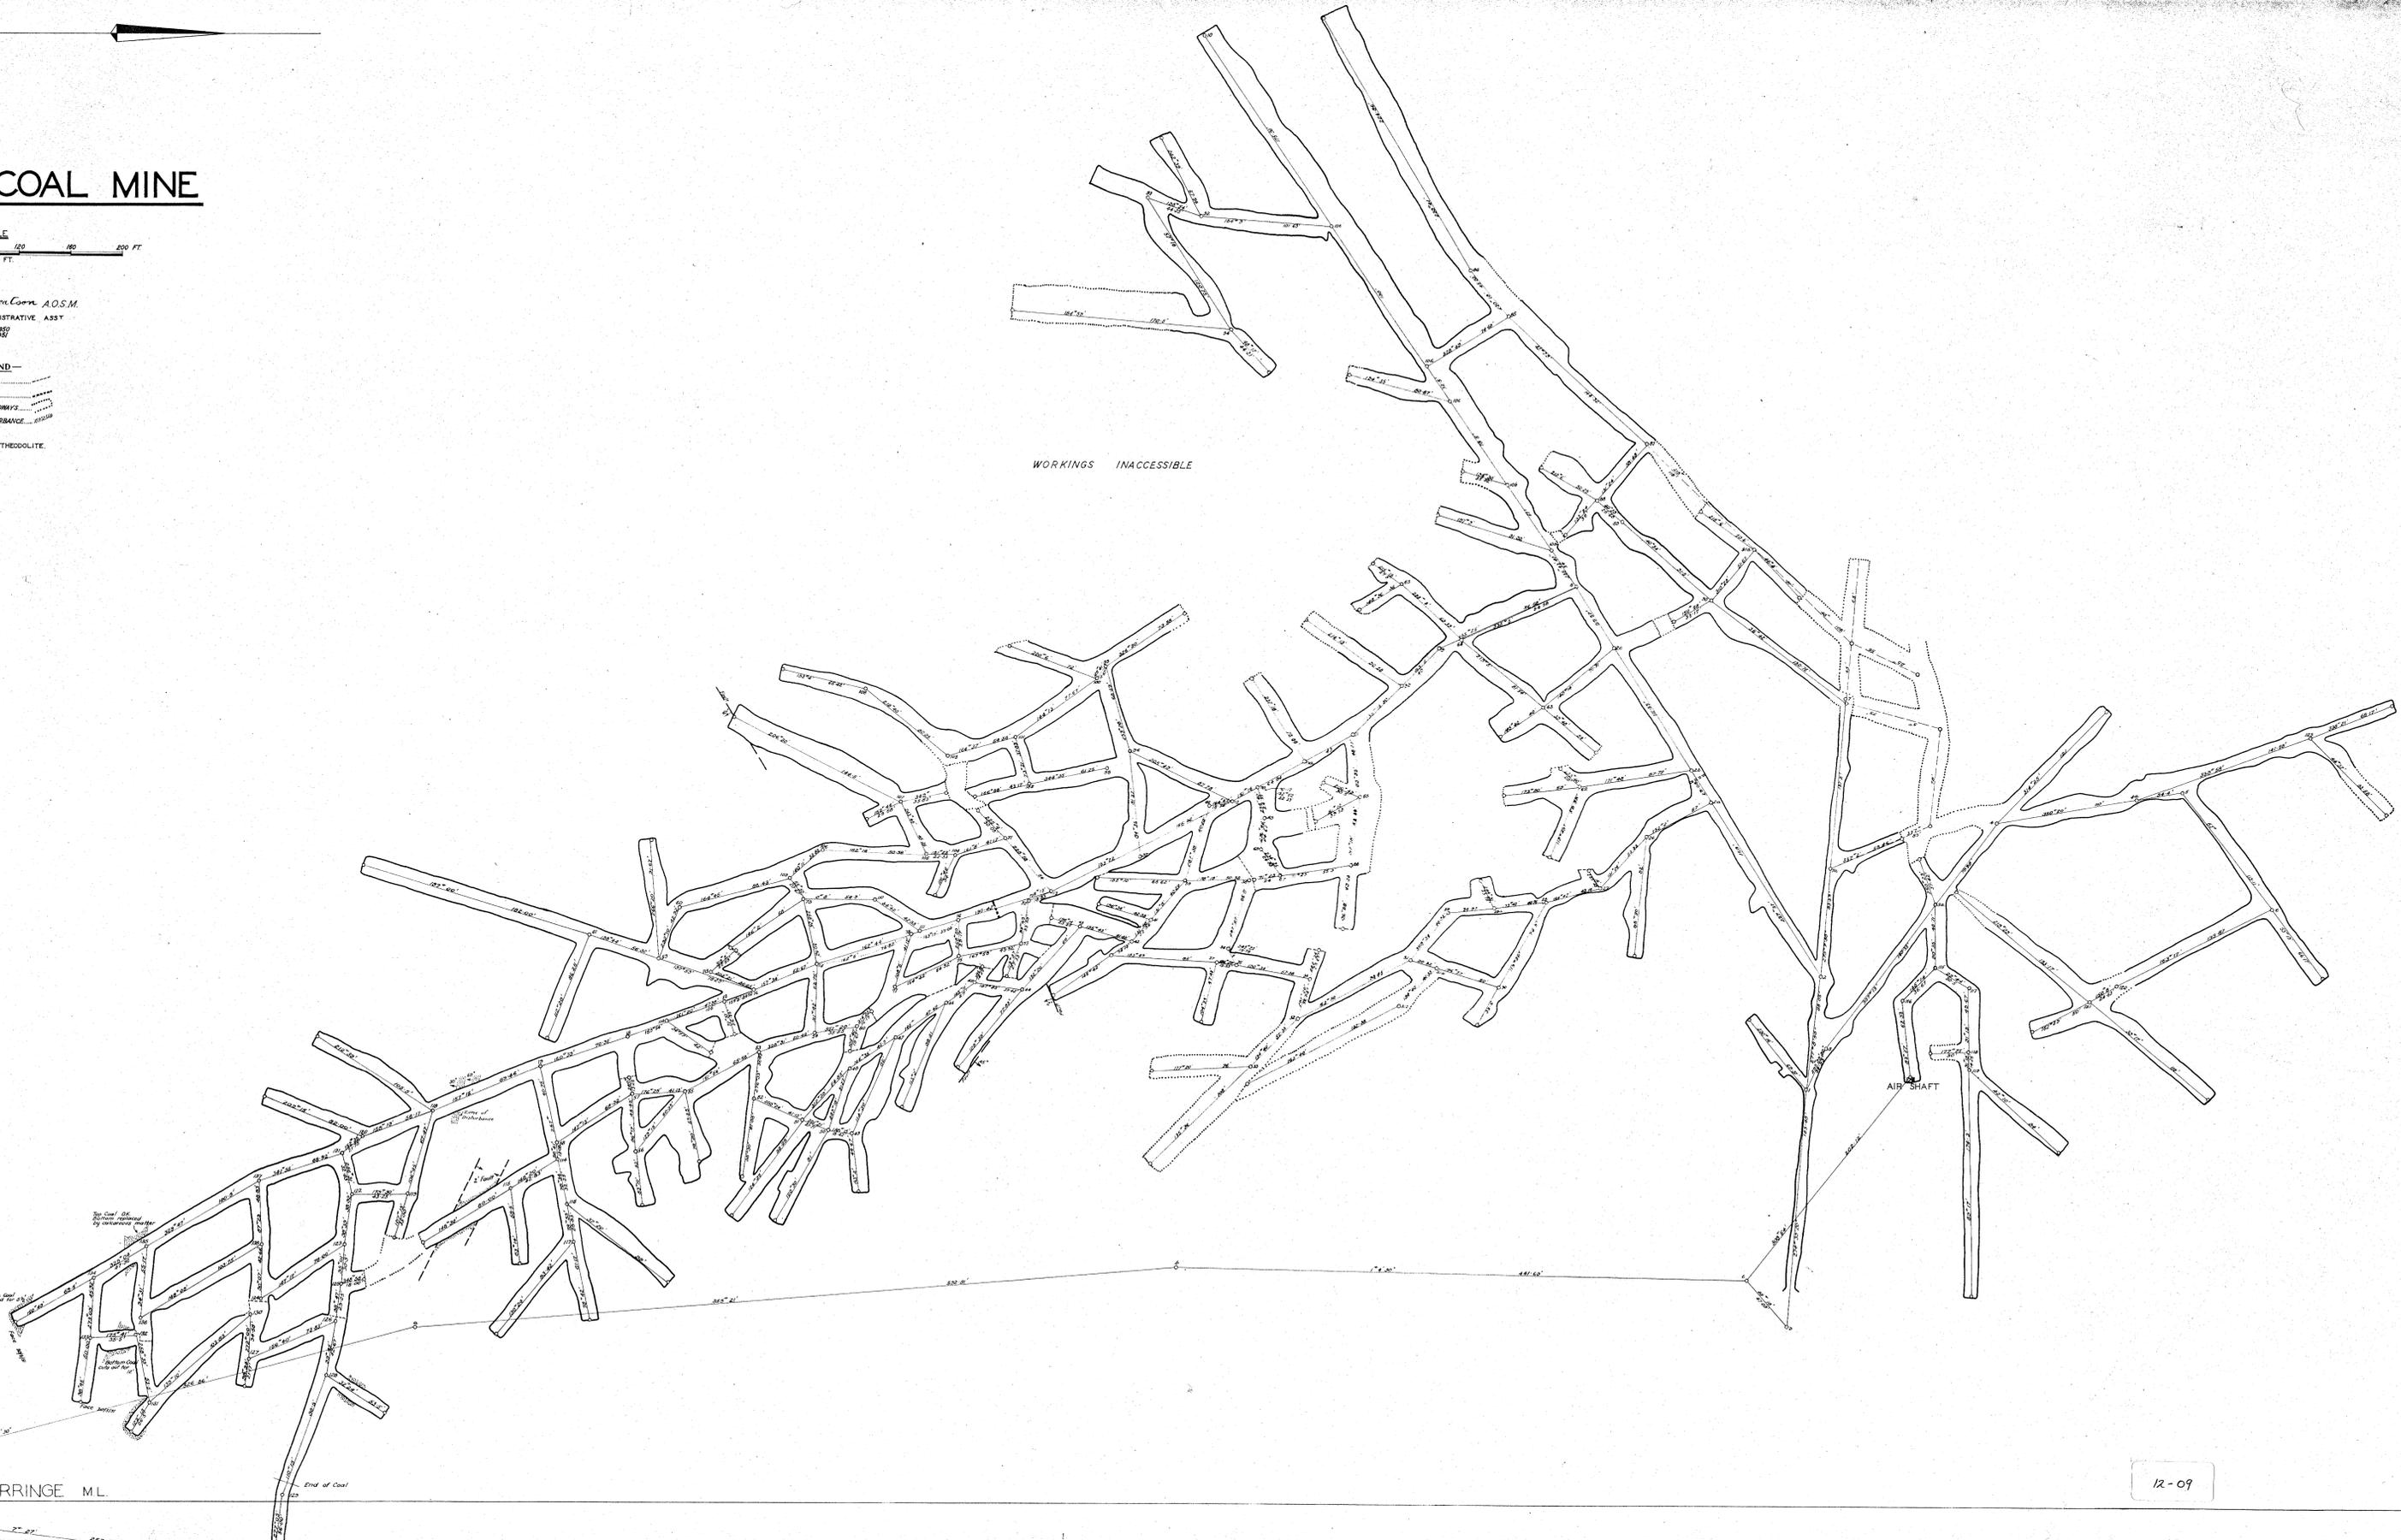

283P  
M. E. GORRINGE M.L.

12-09