


LANGLOH COAL MINE

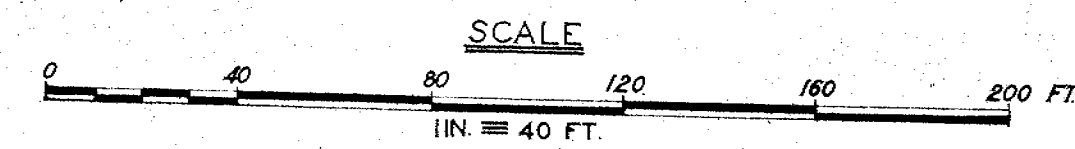

John A. Bacon A.D.S.M.
TECHNICAL & ADMINISTRATIVE ASSIST
APR 1951
MAY 1951

LEGEND

BRATTICES
DOORWAYS
COLLAPSED ROADWAYS
ZONES OF DISTURBANCE

N.B. SURVEY BY THEODOLITE.

WORKINGS INACCESSIBLE

AIR SHAFT