



1 IN = 40 FT
Hall & Benton A.O.S.M.
TECHNICAL & ADMINISTRATIVE ASST
NOV. 1949

LANGLOH COAL MINE

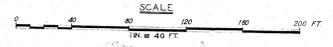

LEGEND
BRATTICES
DOORWAYS
COLLAPSED ROADWAYS

N.B. PRINCIPAL TRAVERSES BY THEODOLITE.
MINOR TRAVERSES BY MAGNETIC COMPASS (not marked on plan).

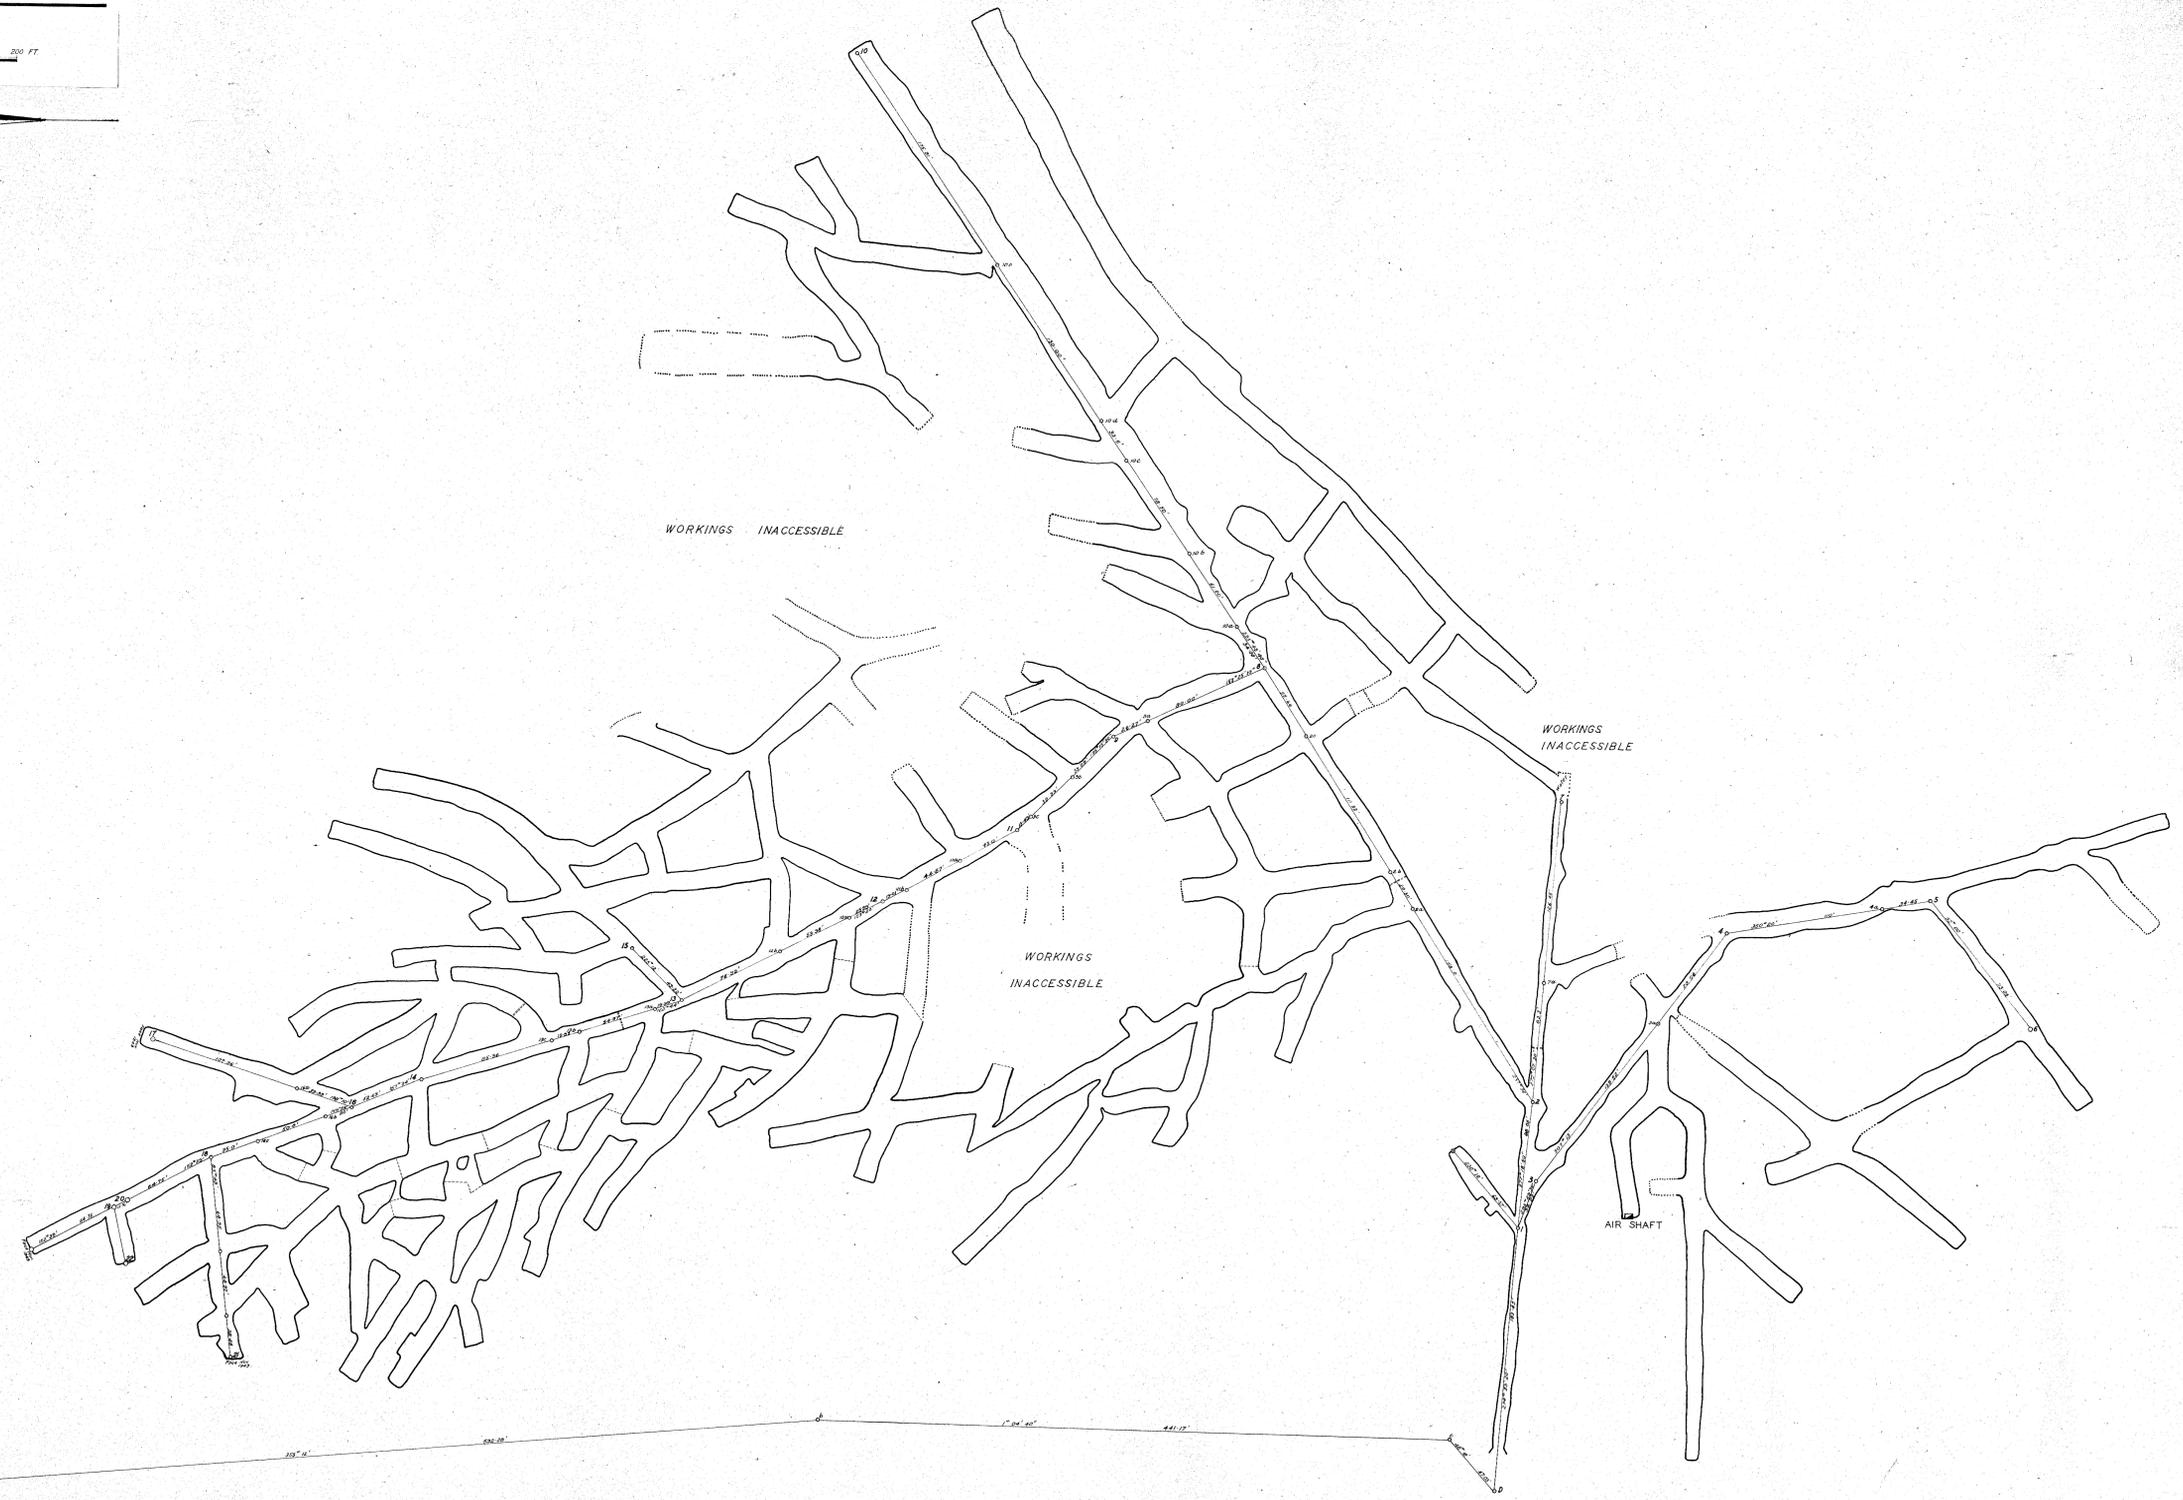

12-11

283 P
M E. GORRINGE M.L.