


LANGLOH COAL MINE

Walter A. Beaton A.O.S.M.
TECHNICAL & ADMINISTRATIVE ASST
NOV. 1942

—LEGEND—
BRATTICES
DOORWAYS
COLLAPSED ROADWAYS



N.B. PRINCIPAL TRAVERSES BY THEODOLITE.
MINOR TRAVERSES BY MAGNETIC COMPASS (not marked on plan).

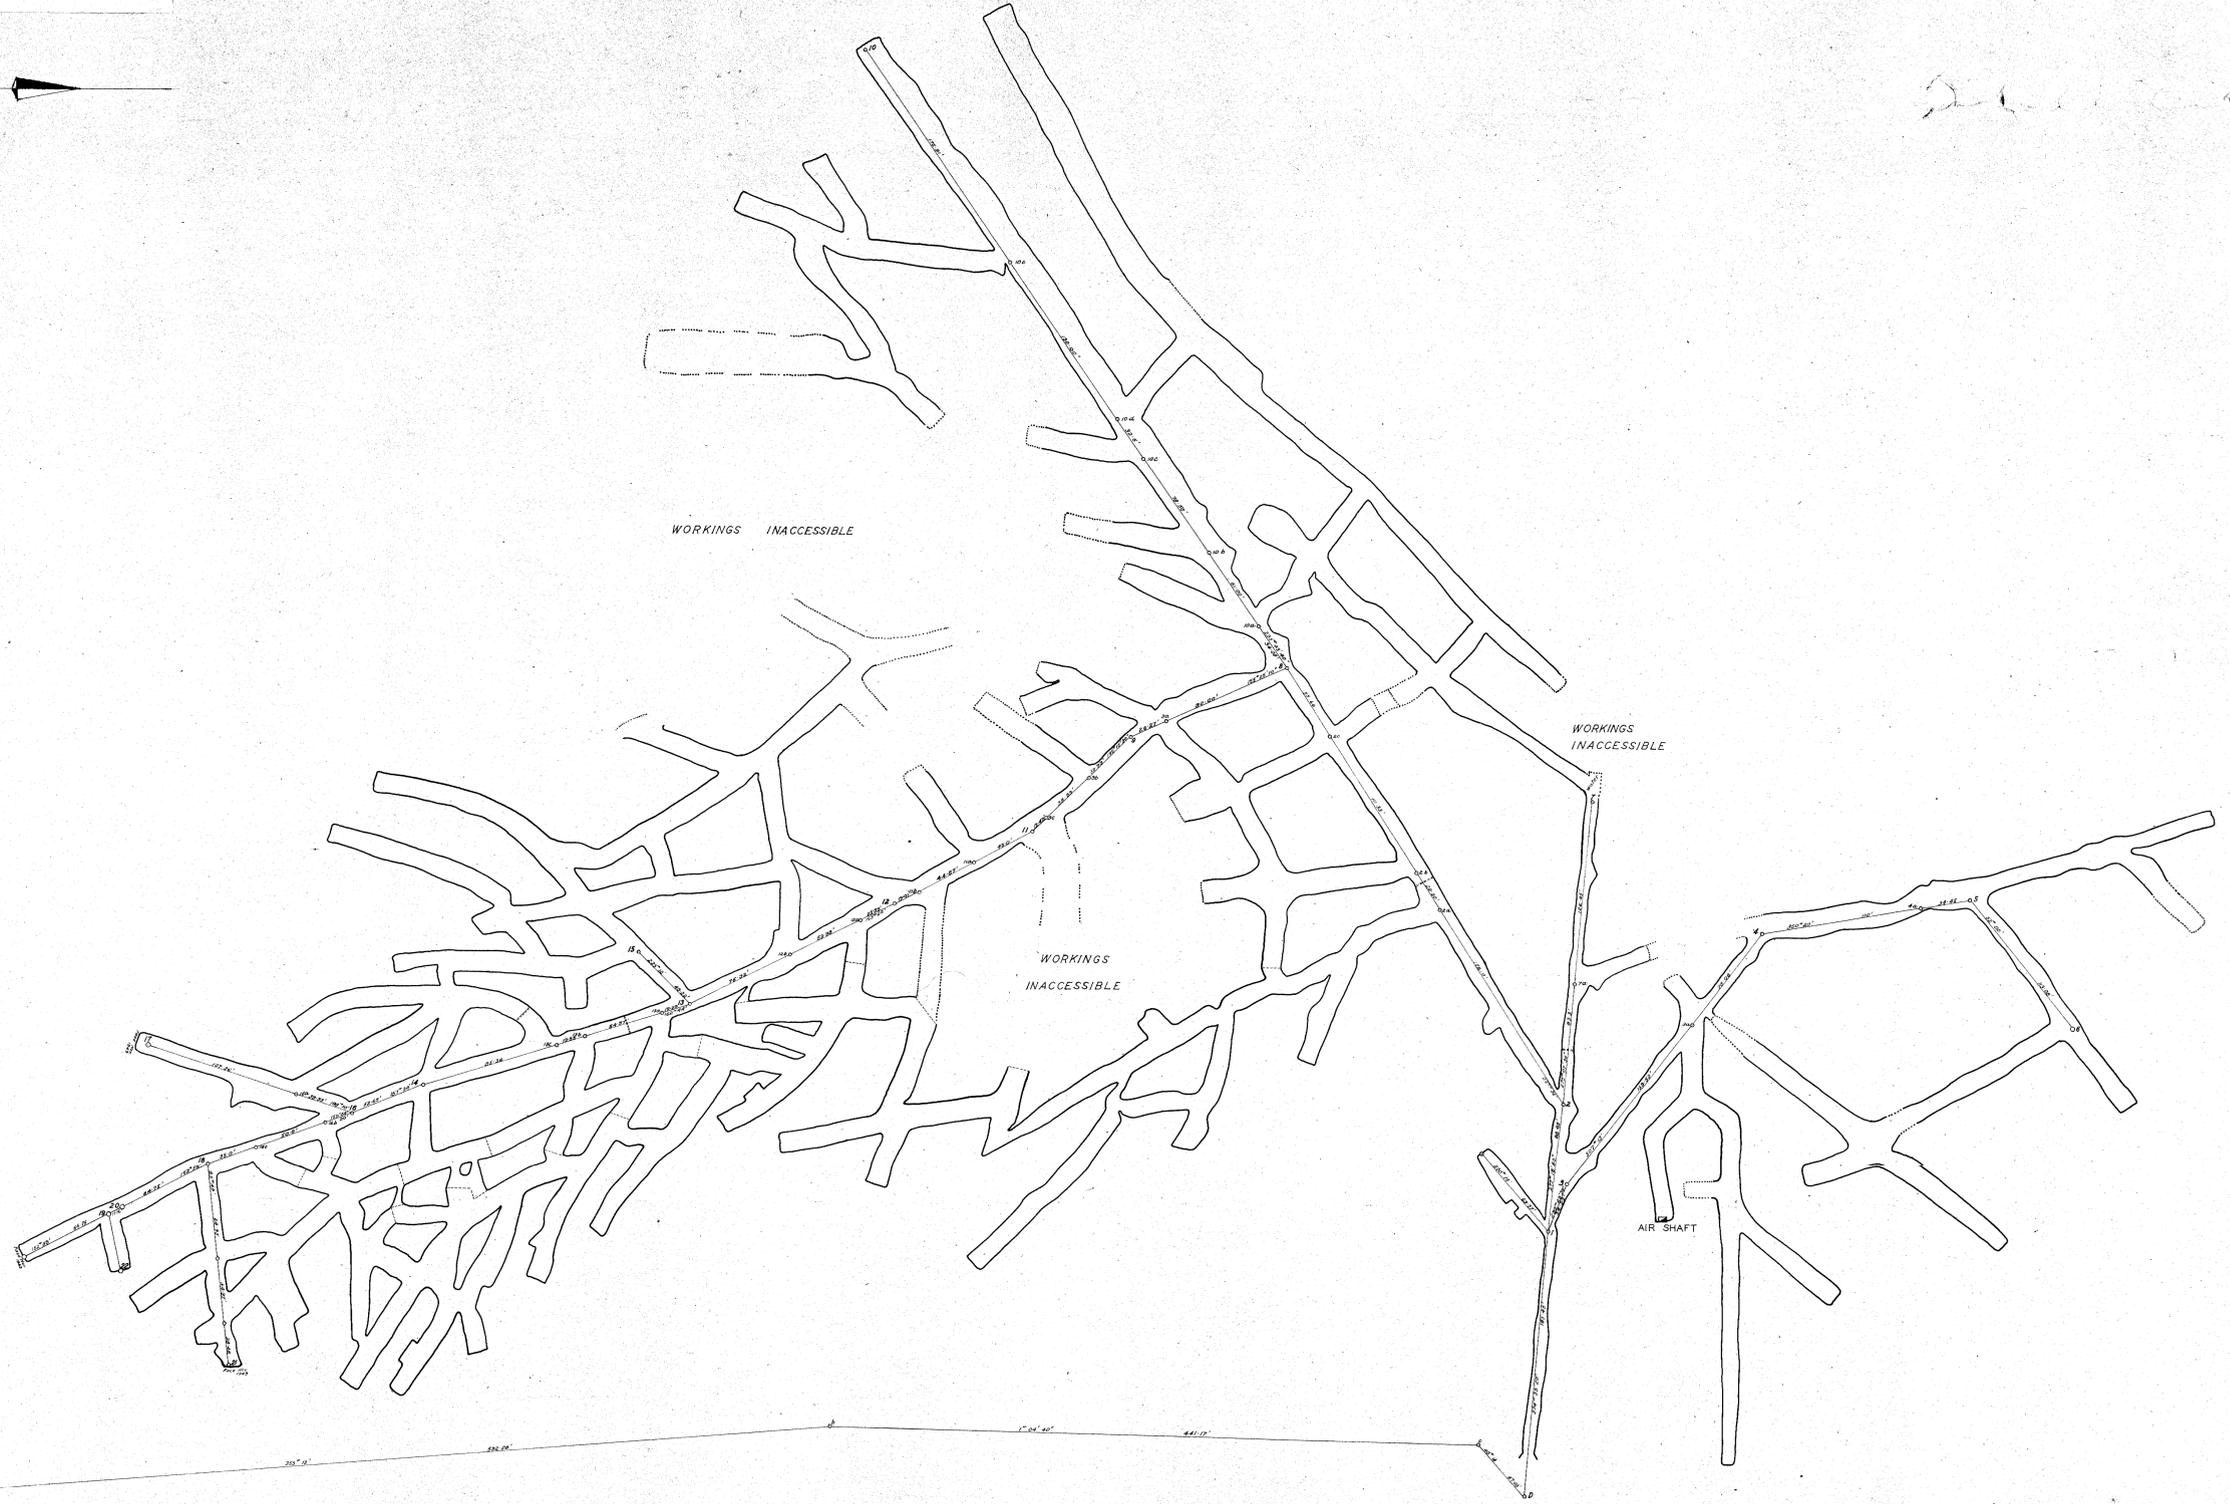

283P
M. E. GORRINGE M.L.

12-12