


0012-014

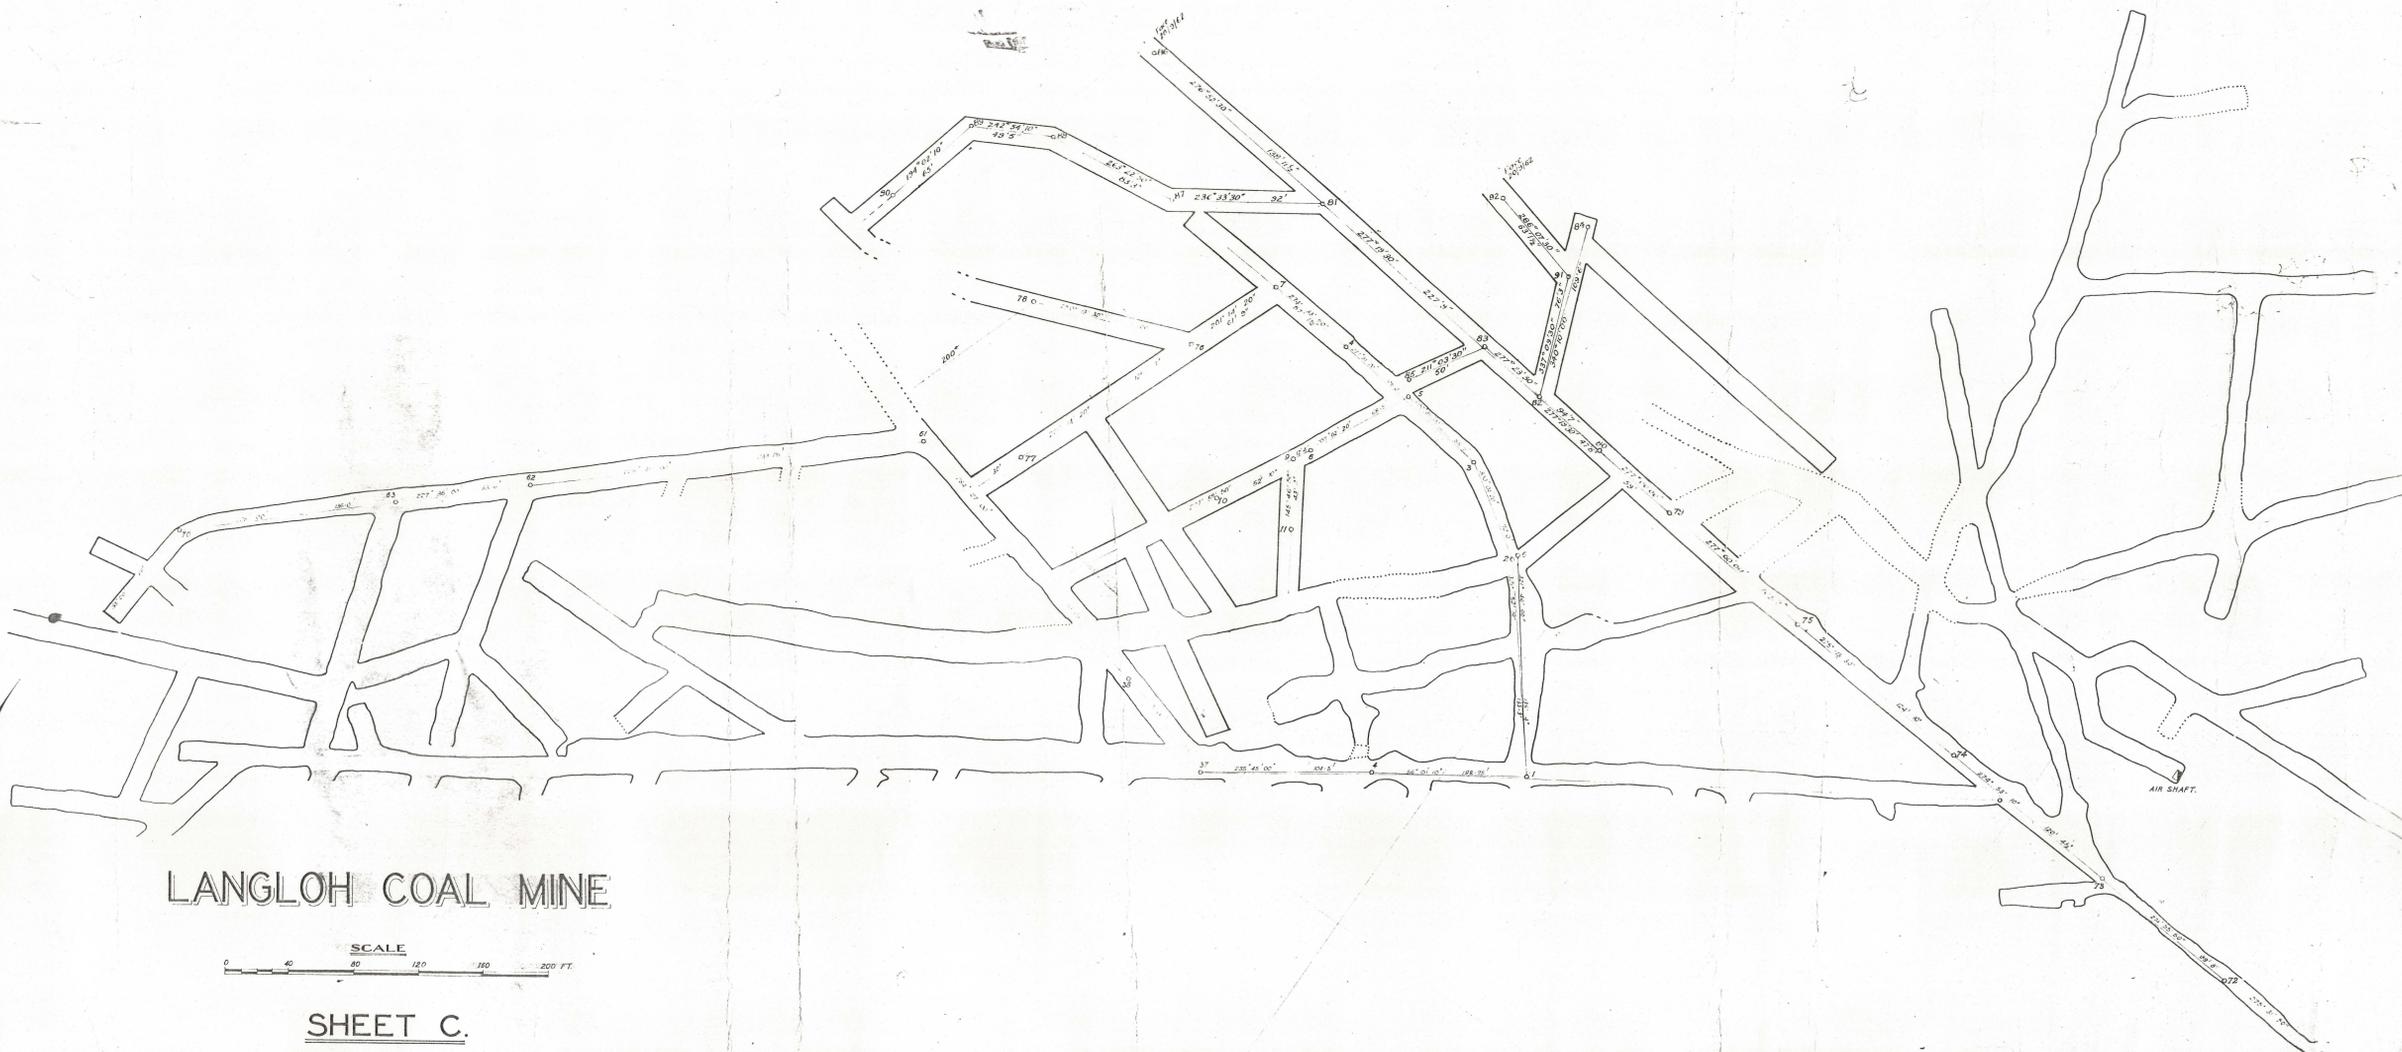


LANGLOH COAL MINE



SHEET C.

Additions surveyed by D.Bestford 20-3-62

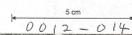

AIR SHAFT