


12-15

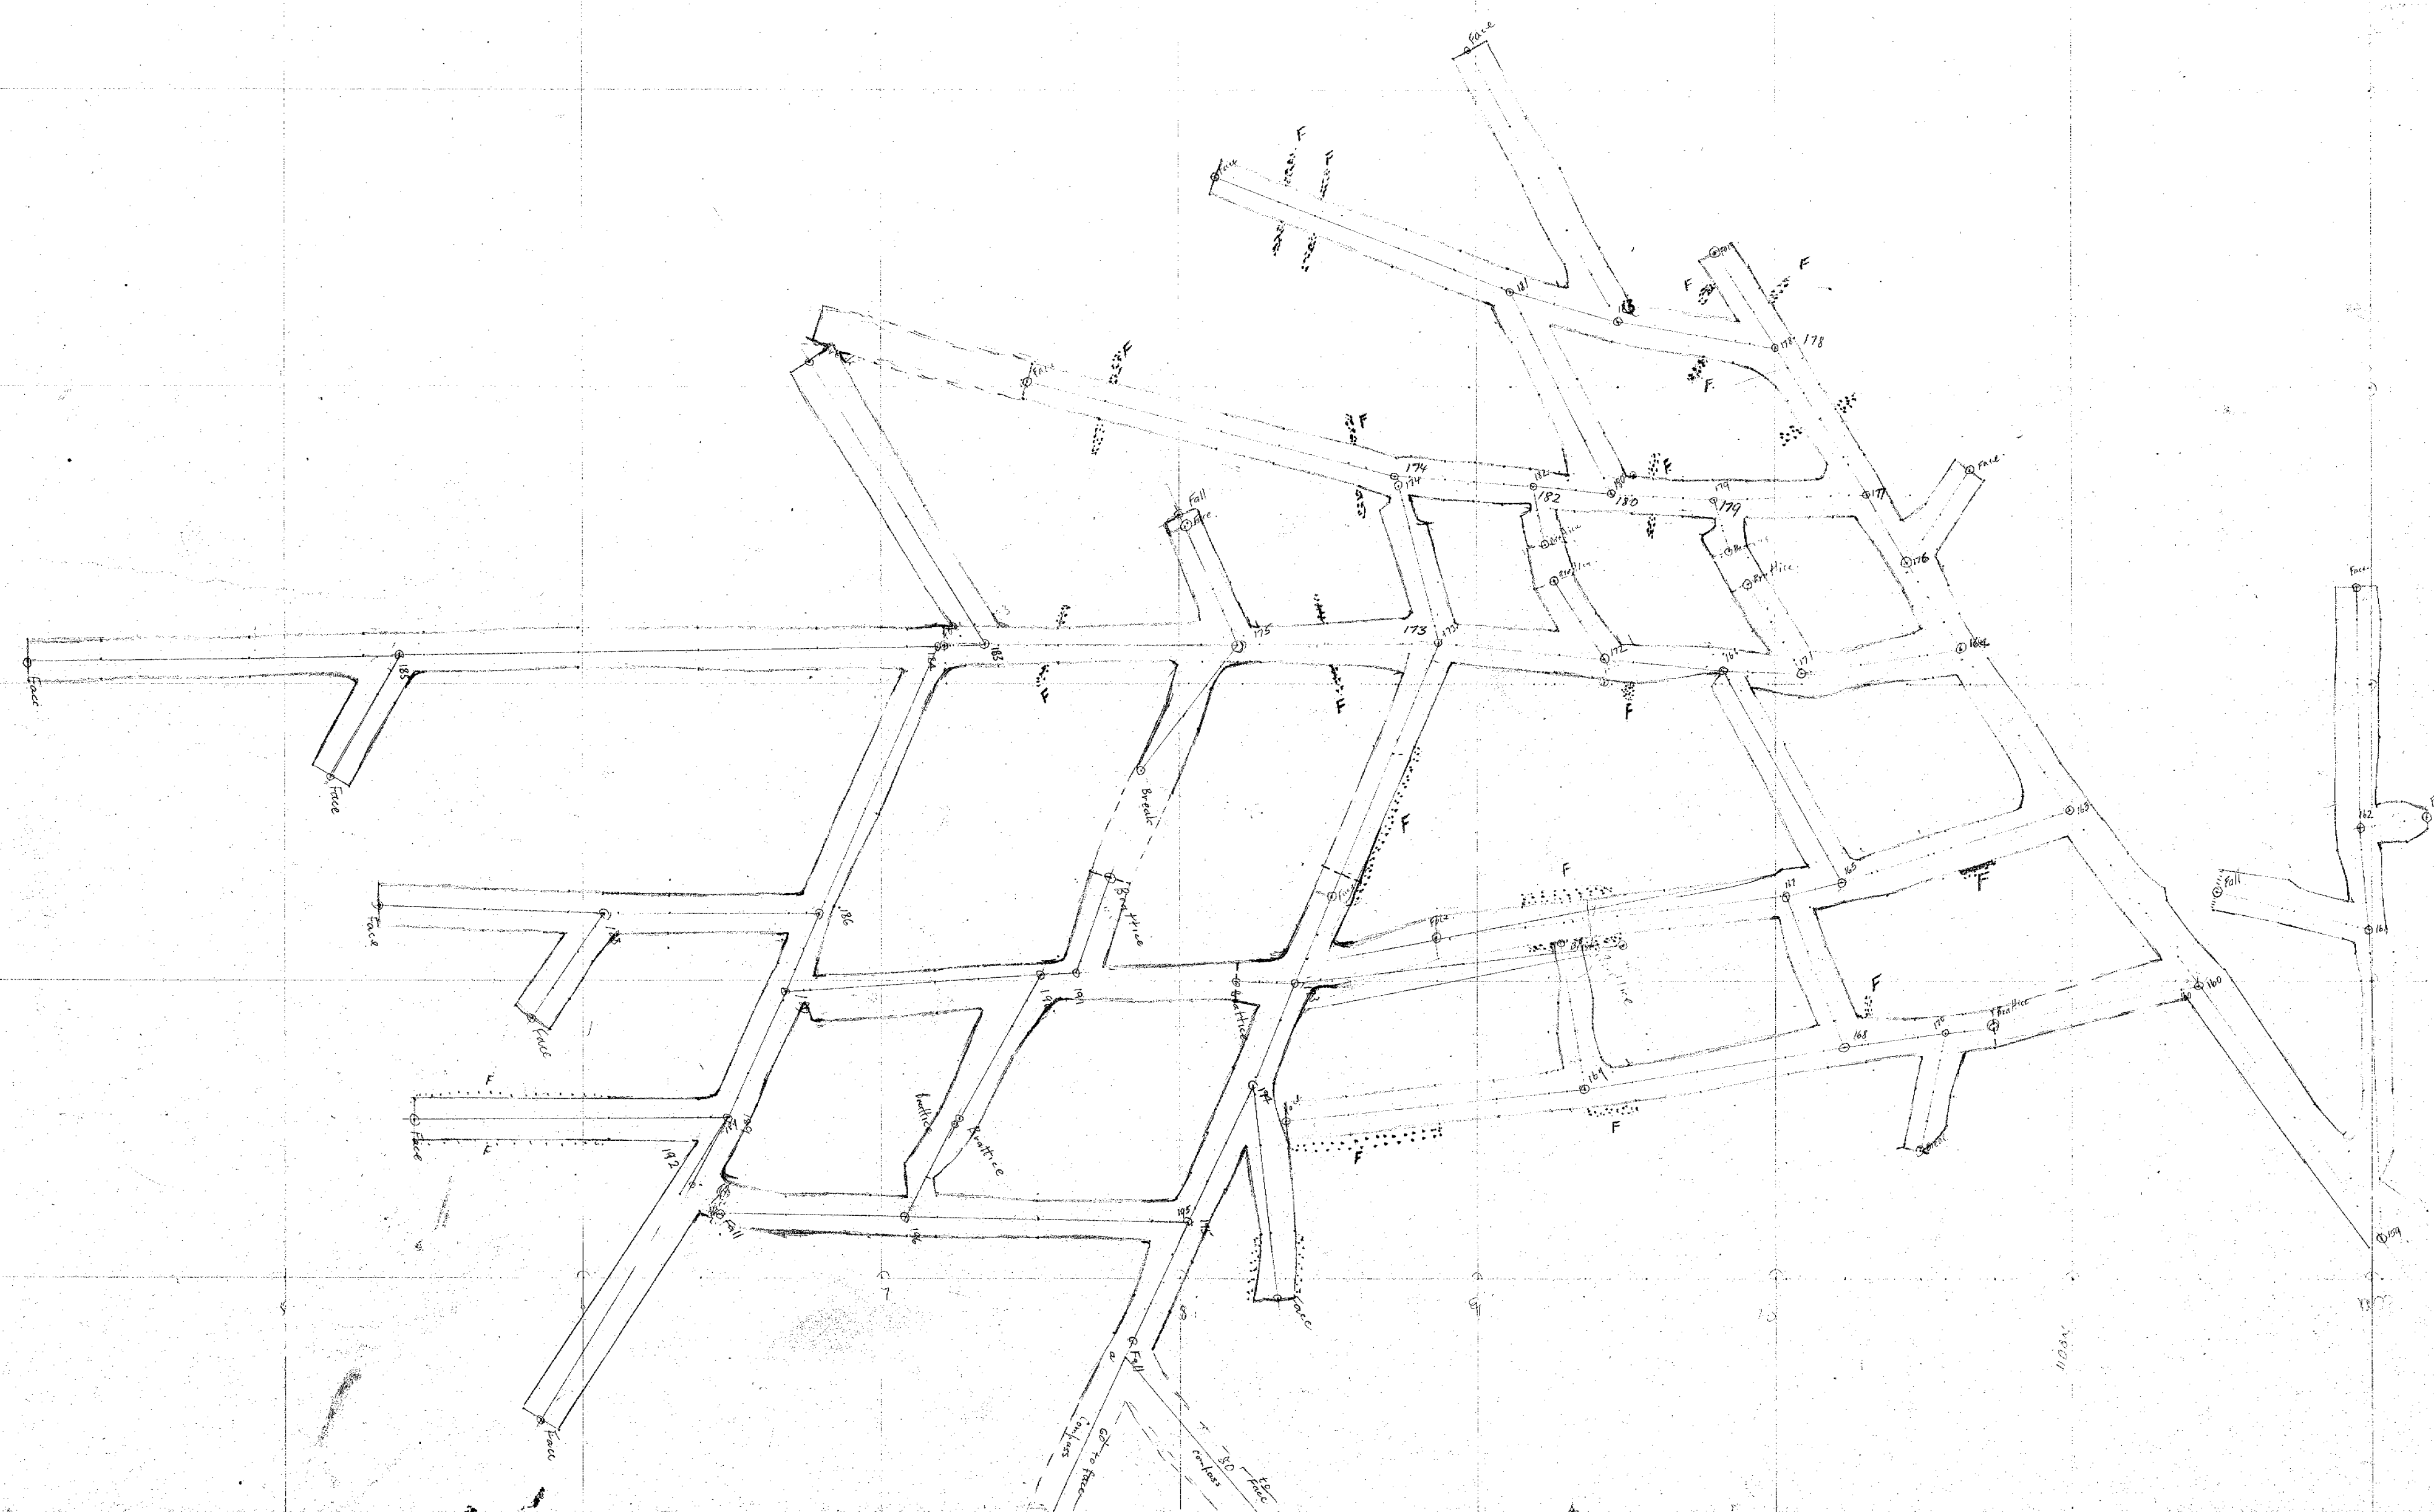

12-15