


THE BLACK BEAUTY C.M.

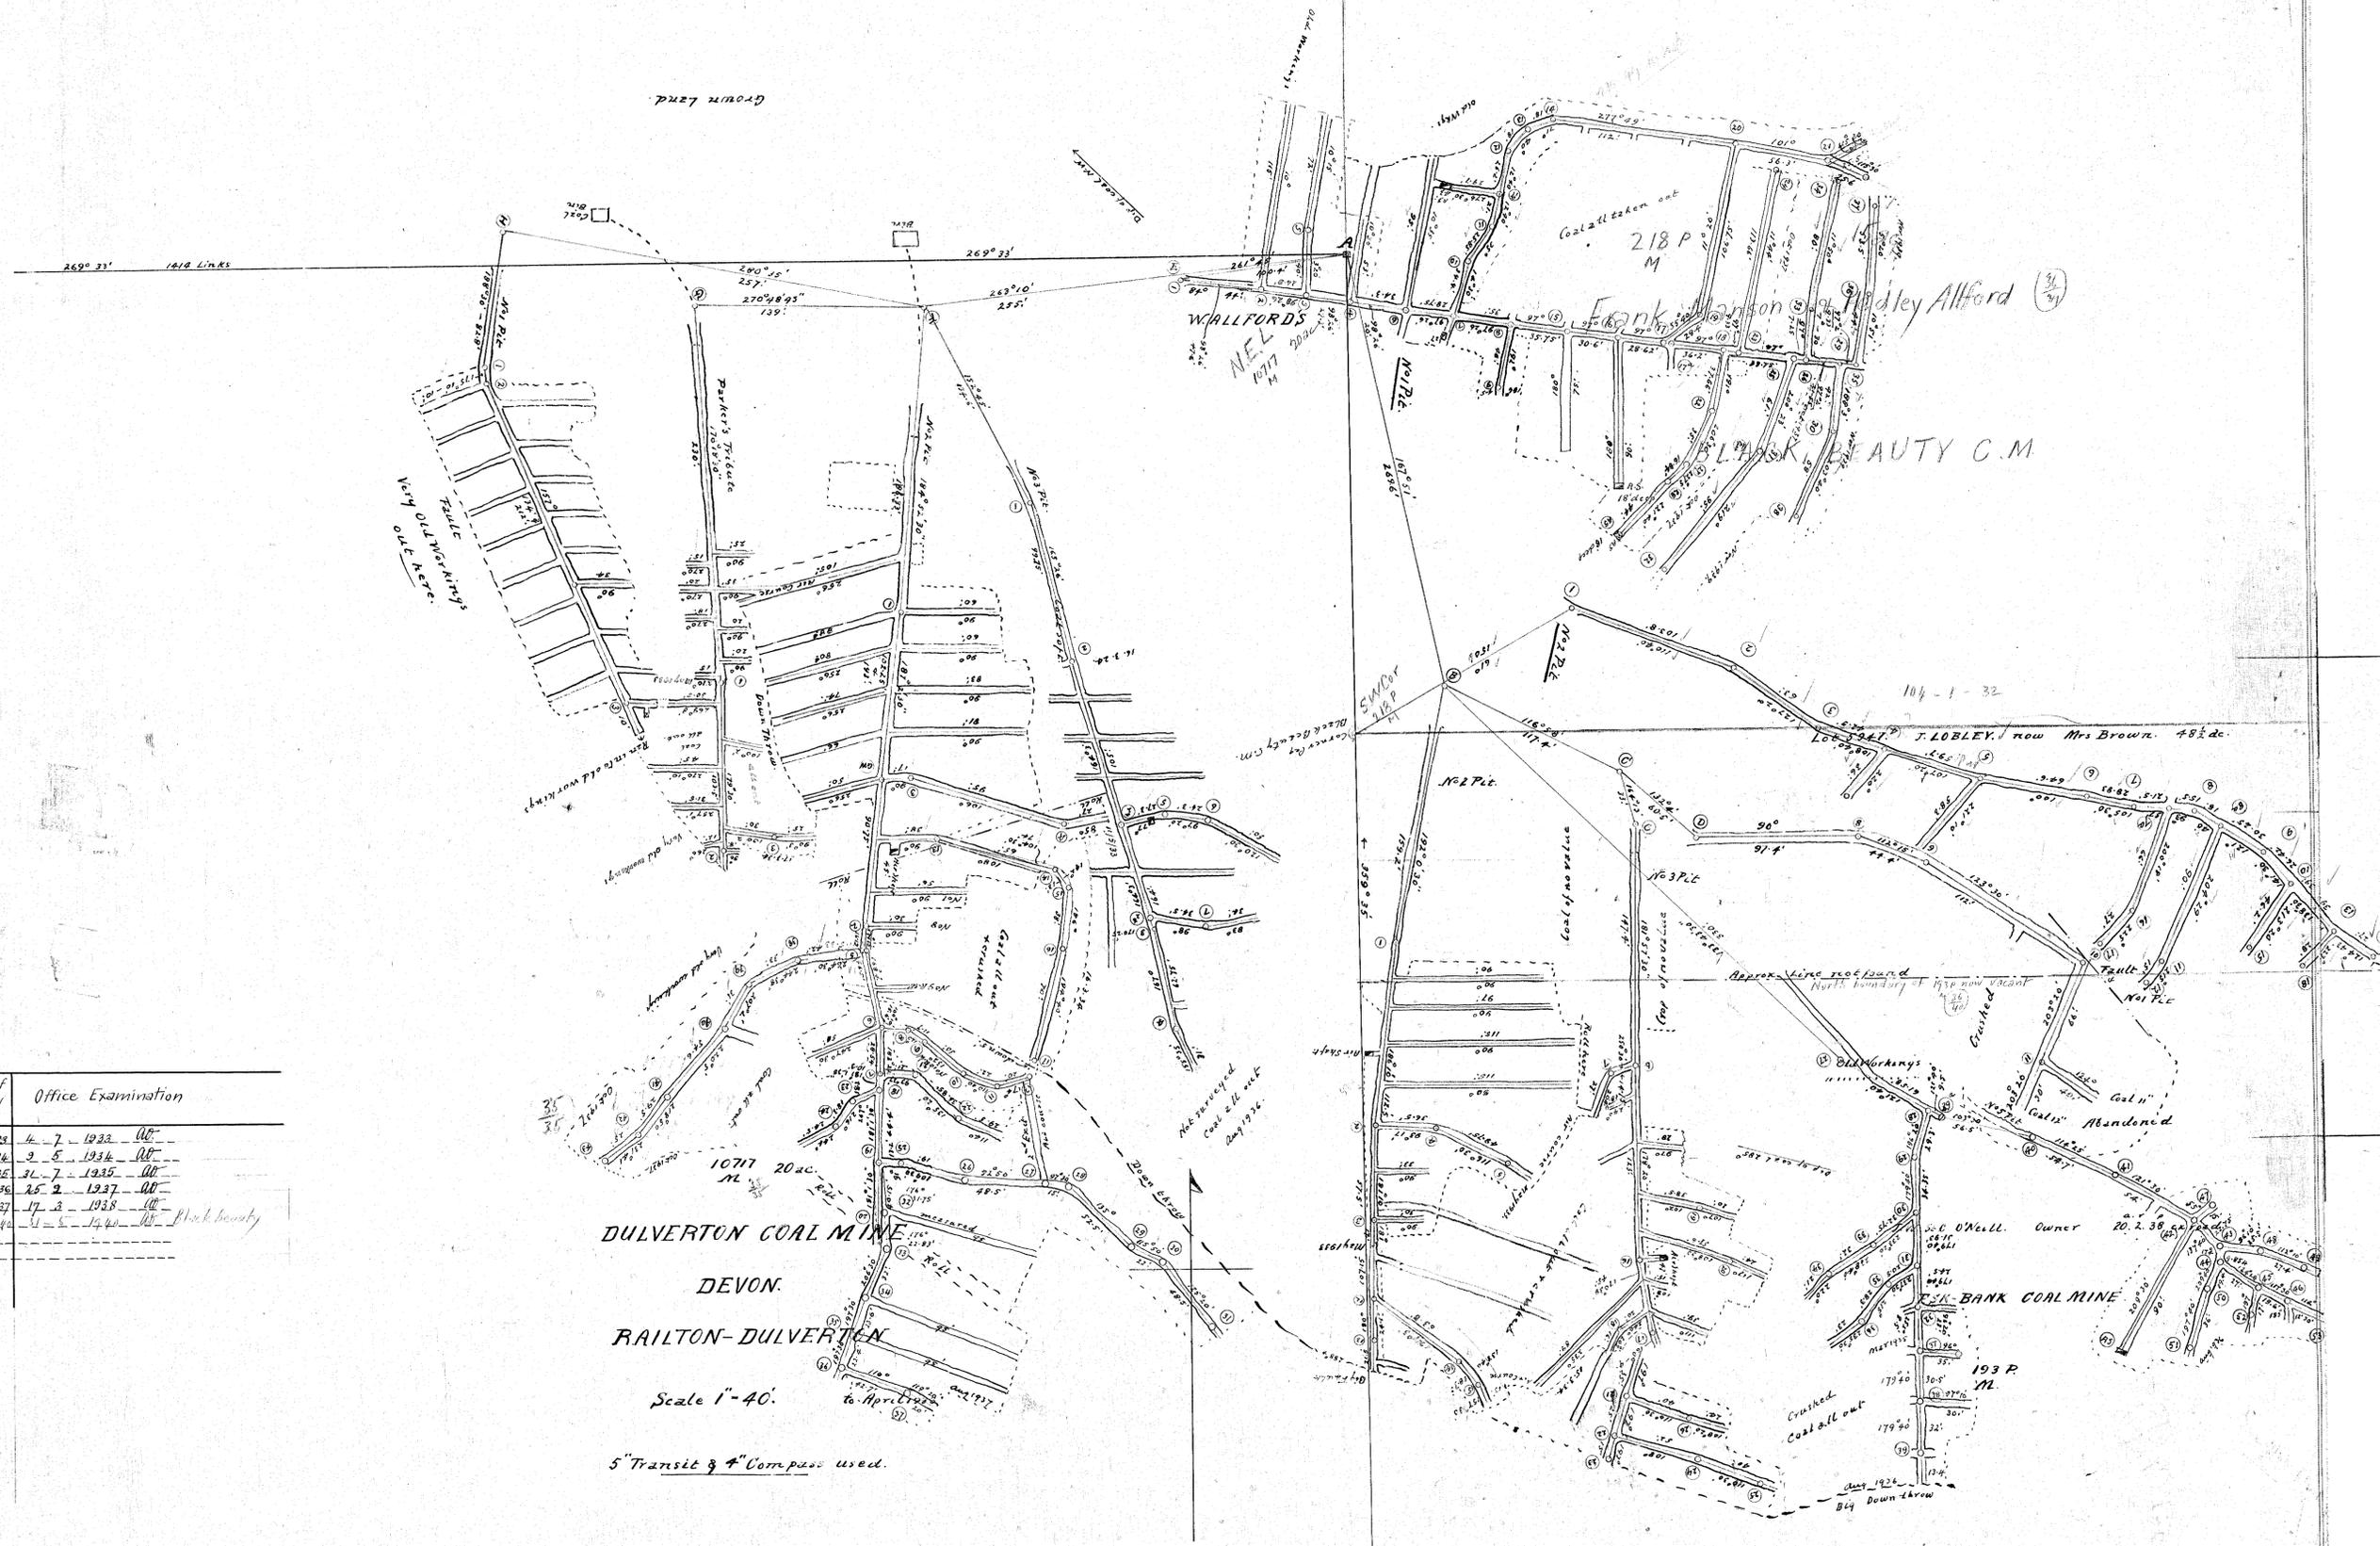

Date of Survey	Office Examination
June 1933	4-7-1933 <i>OK</i>
Mar 1934	2-5-1934 <i>OK</i>
" 1935	31-7-1935 <i>OK</i>
Aug 1936	25-2-1937 <i>OK</i>
Oct 1937	17-3-1938 <i>OK</i>
Mar 1940	4-5-1940 <i>OK</i> Black Beauty

DULVERTON COAL MINE

DEVON

RAILTON-DULVERTON

Scale 1"=40'

5" Transit & 4" Compass used.

Surveyed by W. A. Mansfield up to Nov 1939  
 Surveyed by W. A. Mansfield  
 from 1933  
 March 1940  
 1936