


15-51

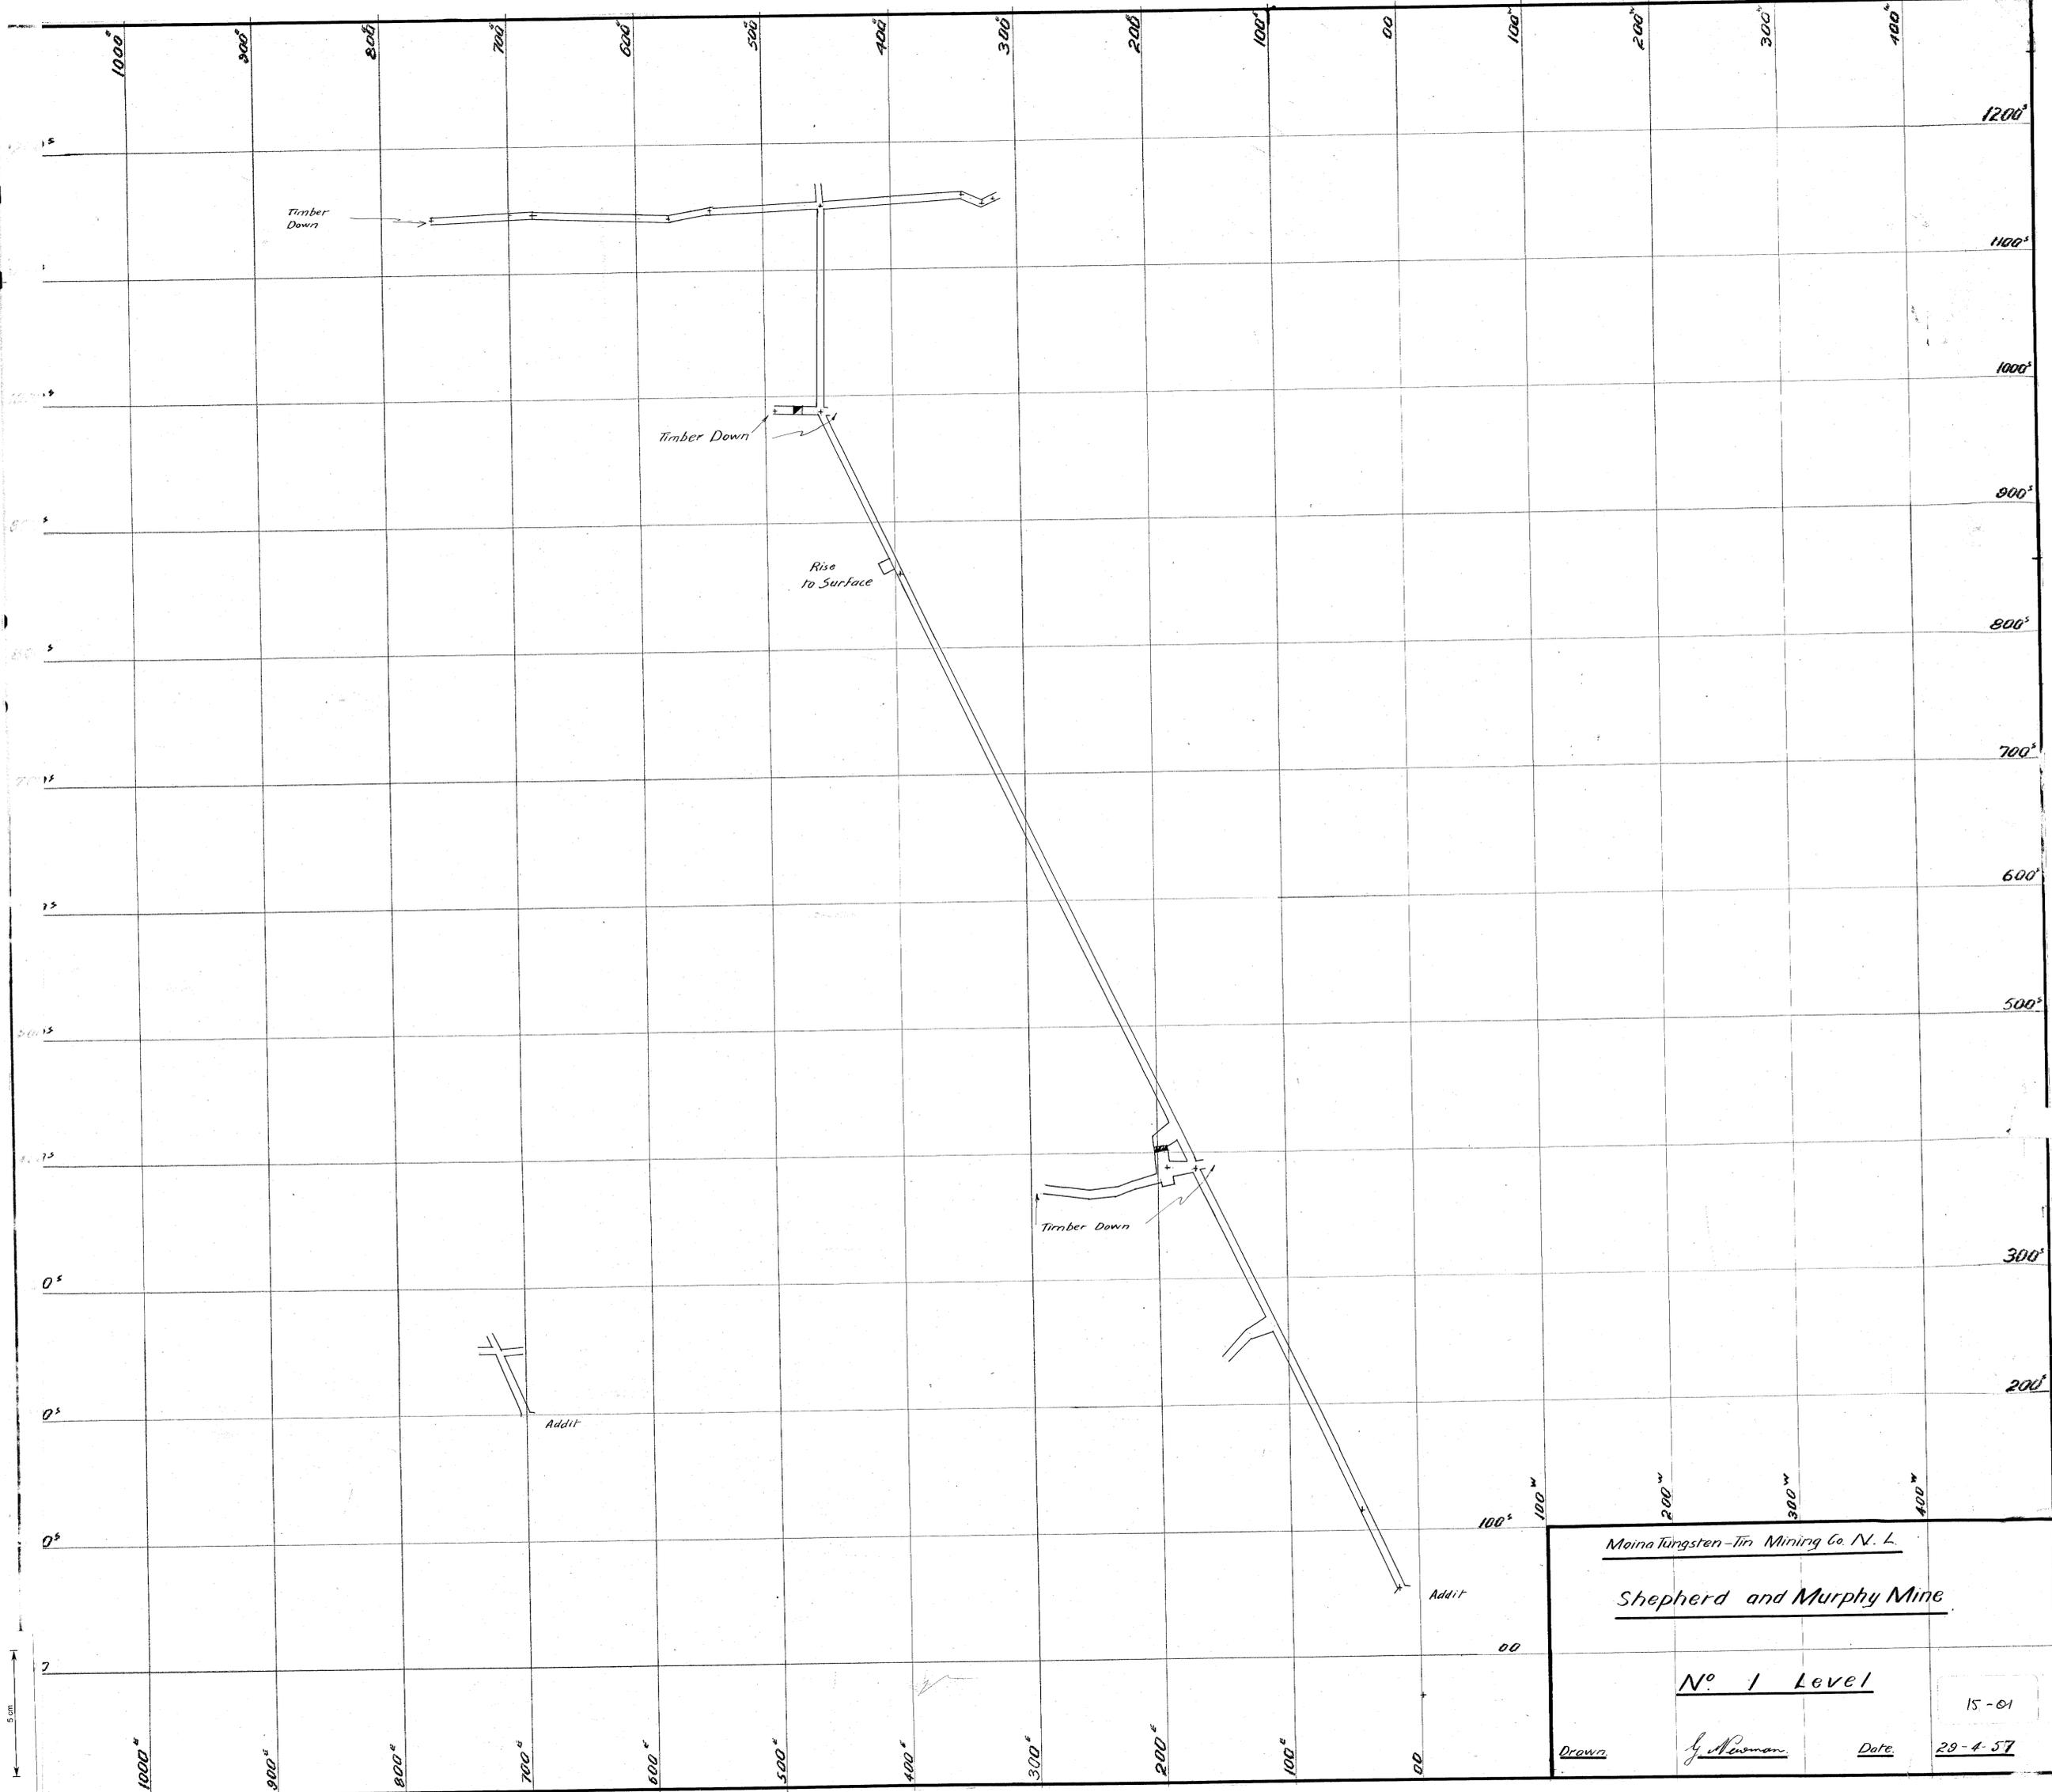

Maina Tungsten-Tin Mining Co. N. L.
Shepherd and Murphy Mine
N^o 1 Level
 Drawn J. Newman Date 29-4-57
 15-51