


15-02

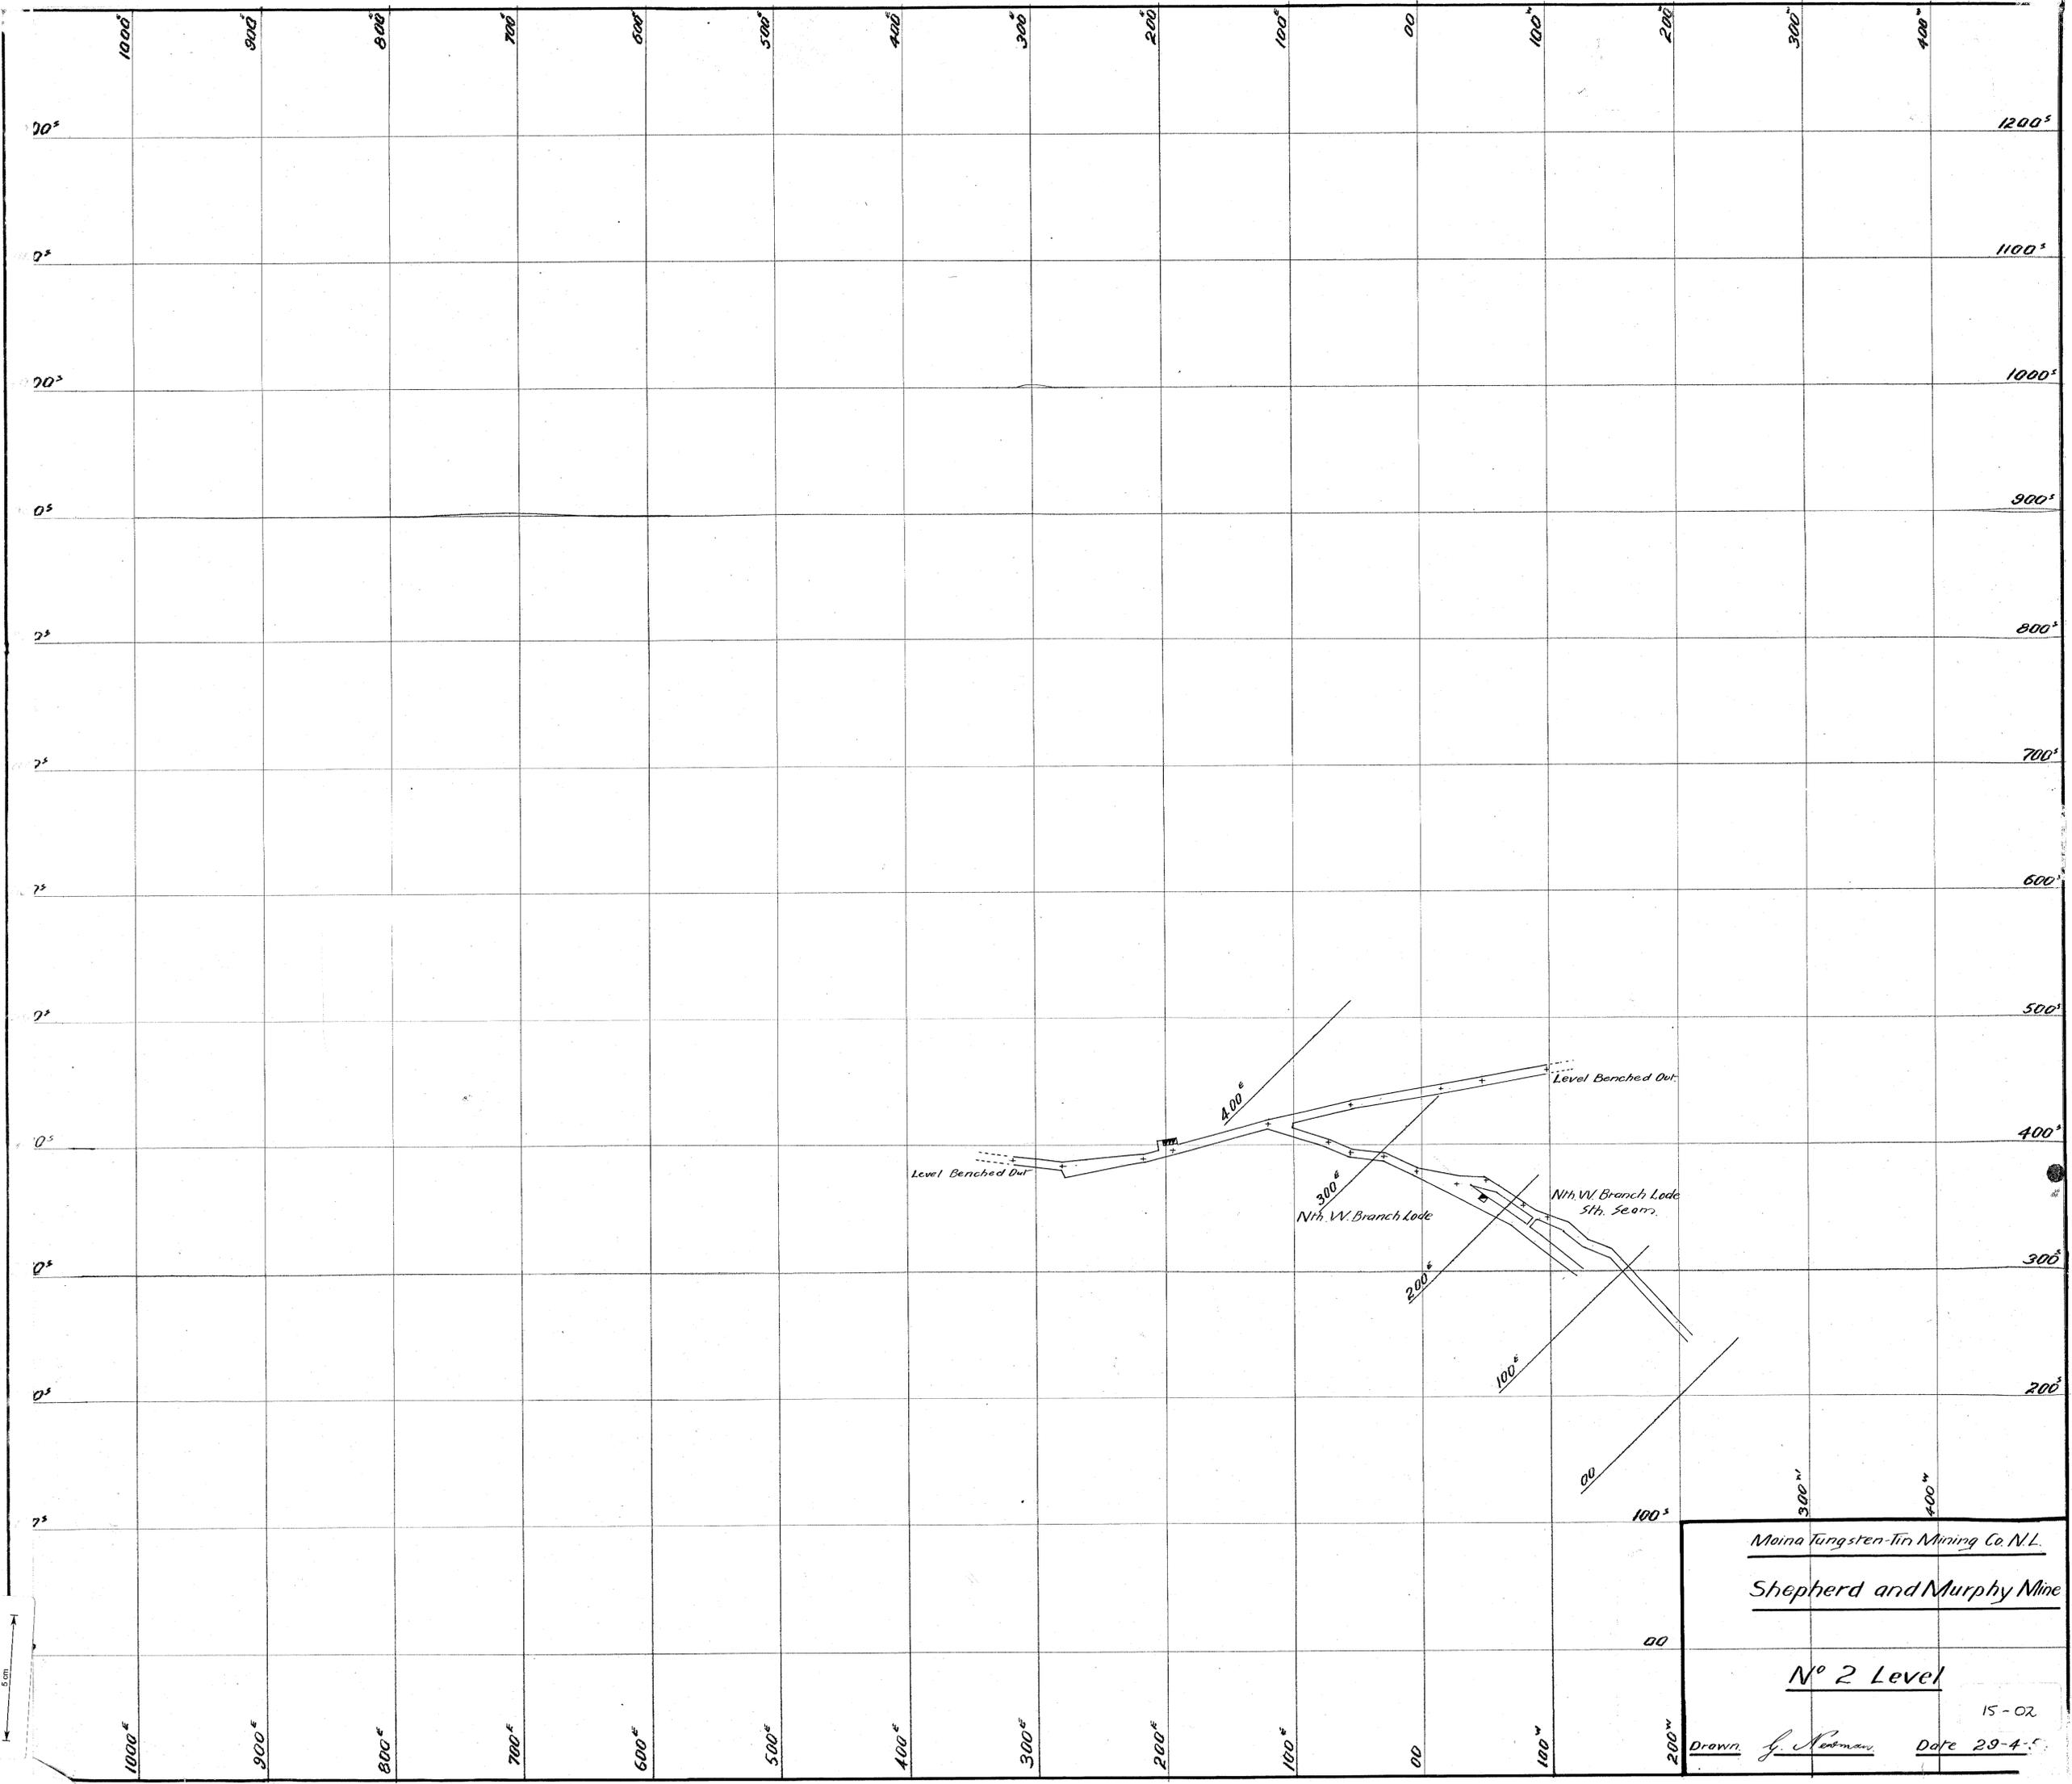

Moina Ferguson-Tin Mining Co. N.L.

Shepherd and Murphy Mine

Nº 2 Level

15-02

Drawn *J. Newman* Date 29-4-5