


50.51

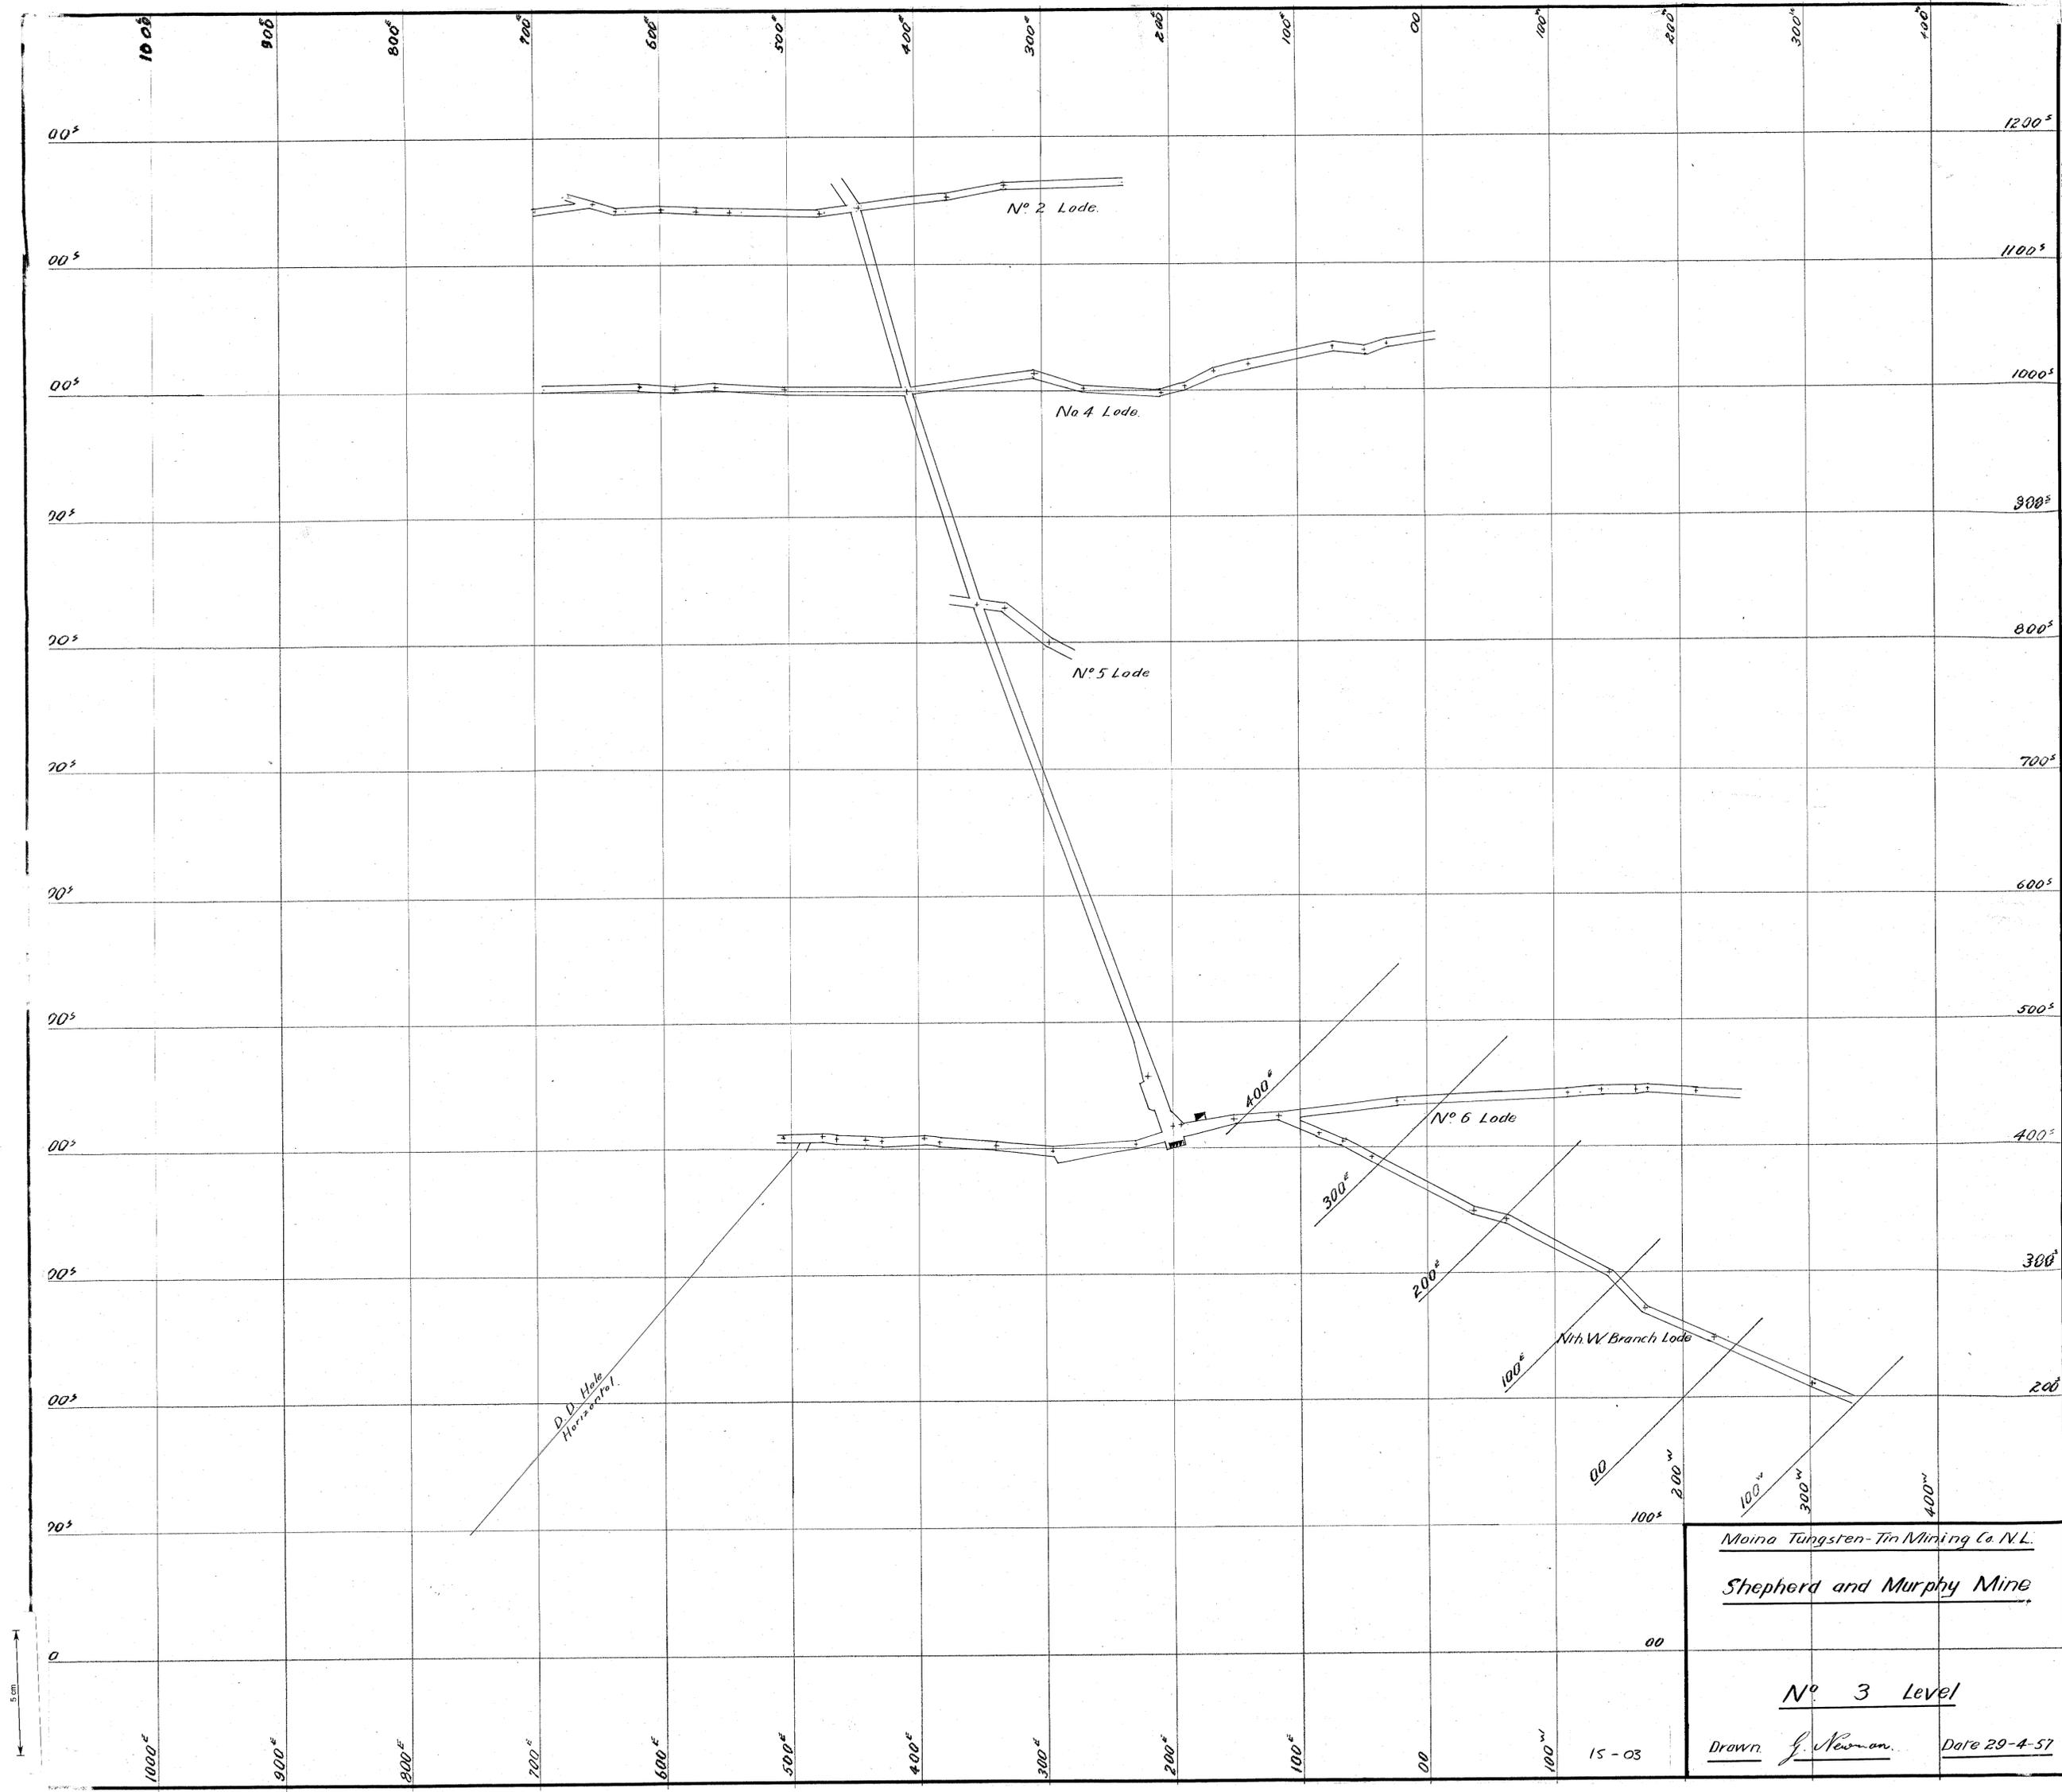

Maina Tungsten-Tin Mining Co. N.L.
Shepherd and Murphy Mine
 No. 3 Level
 Drawn J. Newman Date 29-4-57

15-03