


15-04

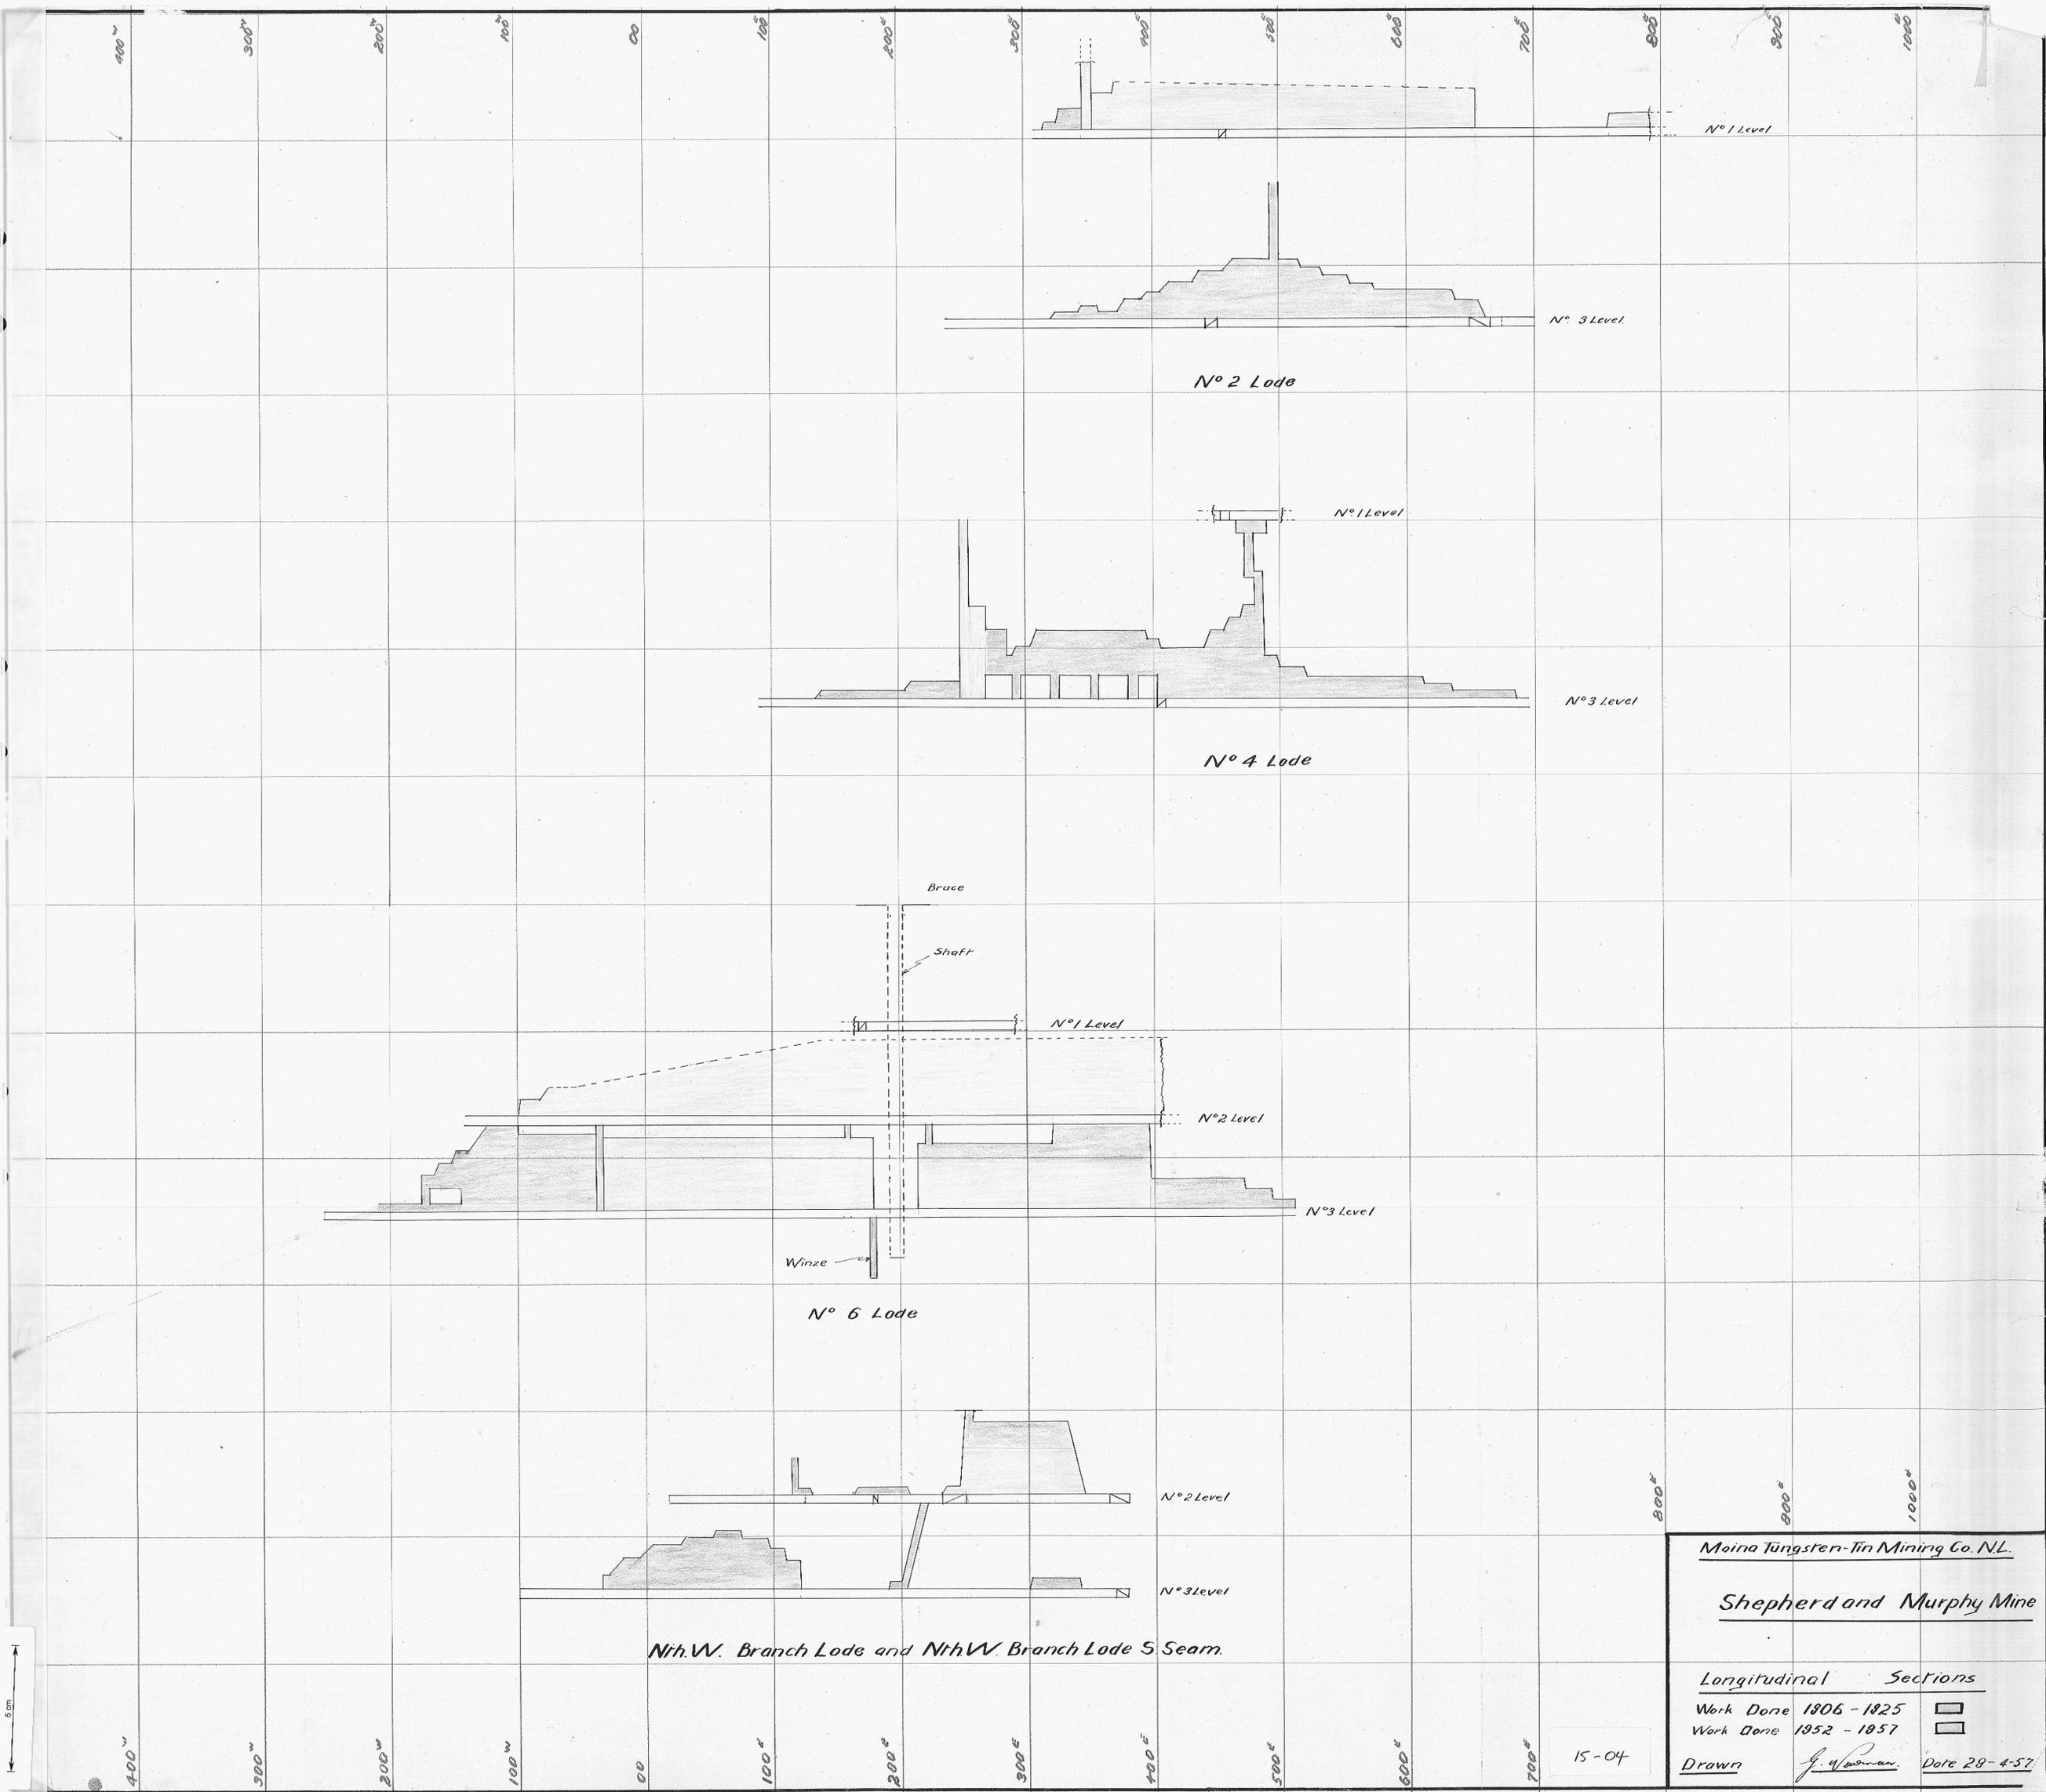

Moina Jungsten-Tin Mining Co. N.L.

### Shepherd and Murphy Mine

Longitudinal Sections

Work Done 1806 - 1825

Work Done 1852 - 1857

Drawn *J. Waldman* Date 28-4-57

15-04

5 cm