
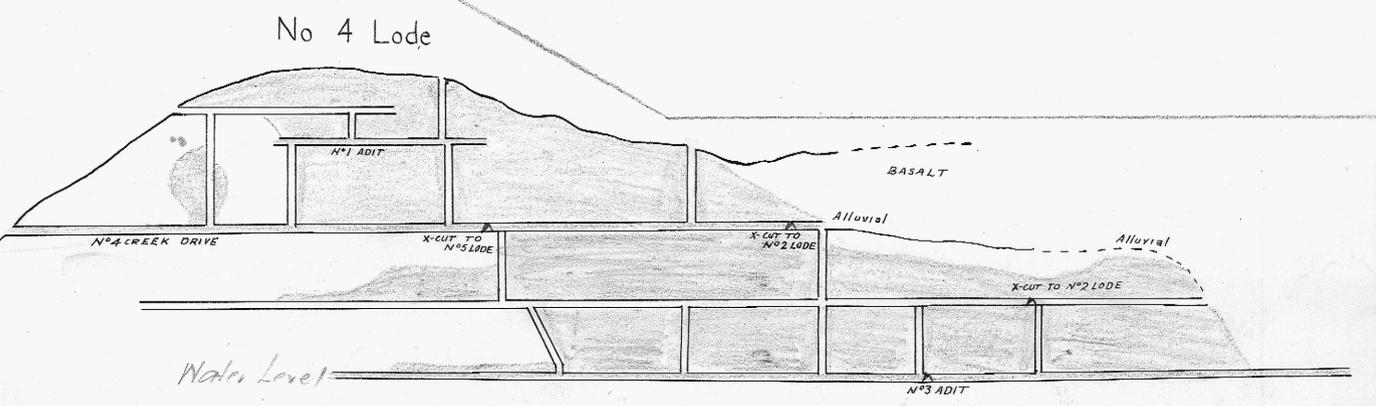
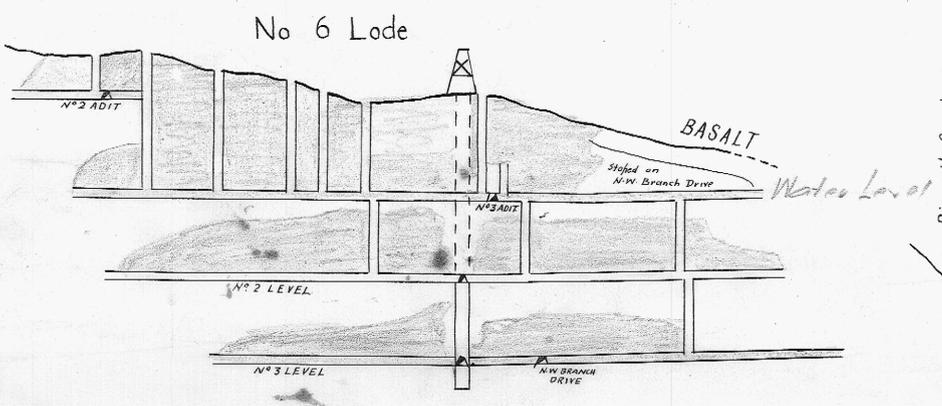
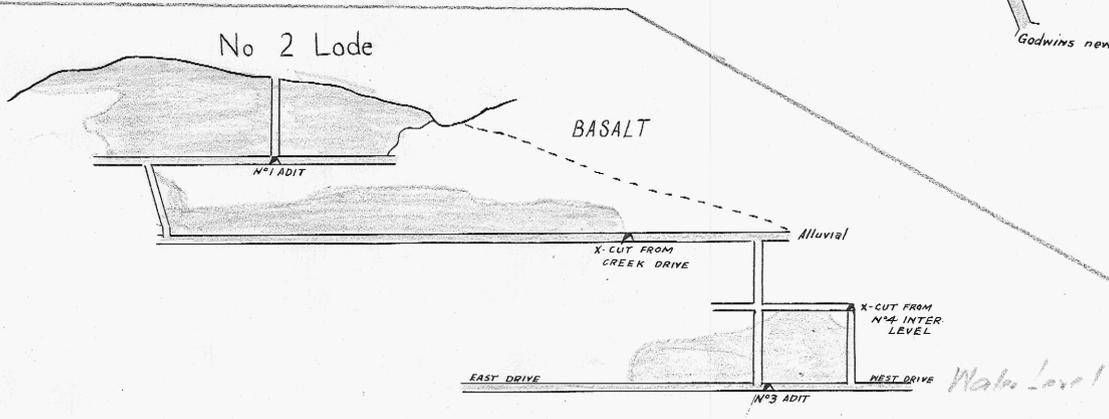


5 cm

1/10 SHEPHERD AND MURPHY

S. & M. MINE

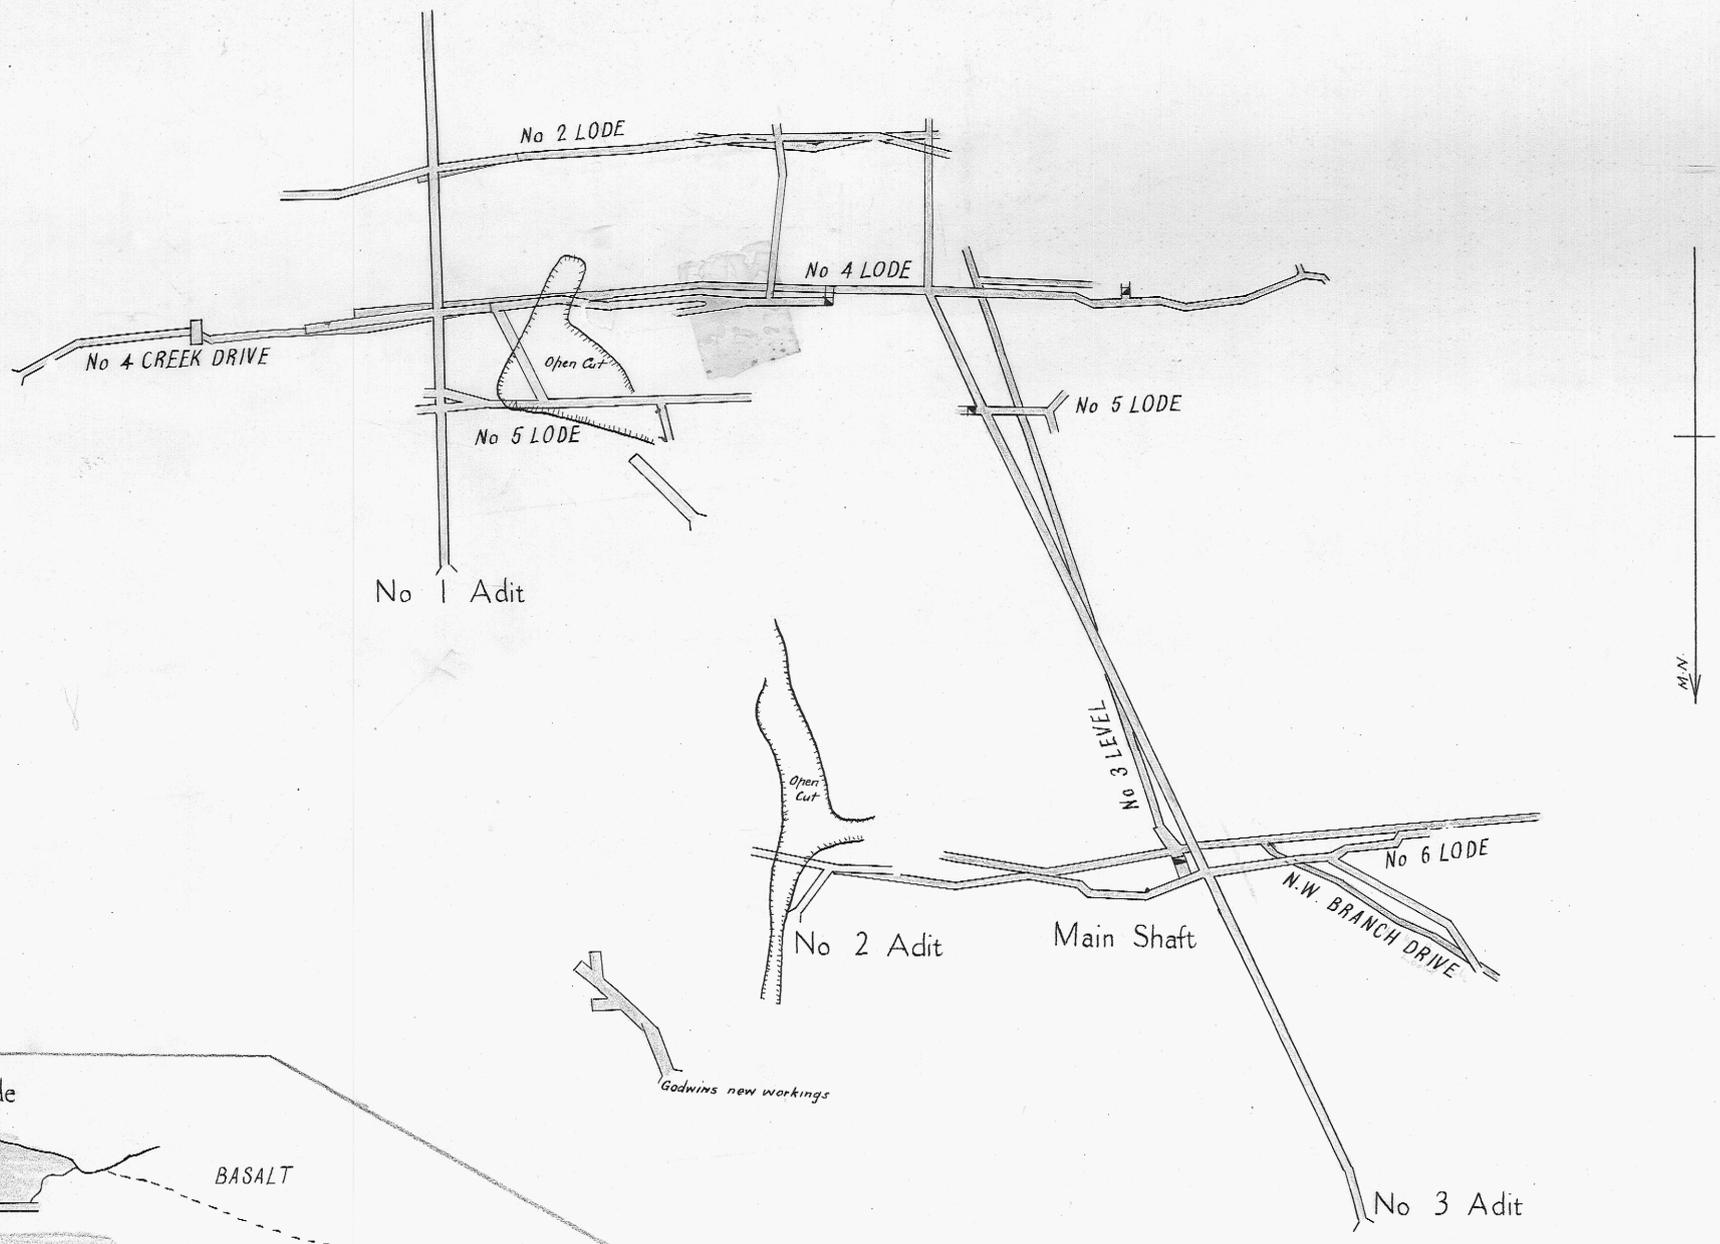

LONGITUDINAL SECTIONS

N°3 LEVEL