


S. & M. MINE

PLAN

No 3 Level Showing No 6 & N.W. Lodes

Scale 50 Feet to 1 Inch

5 cm

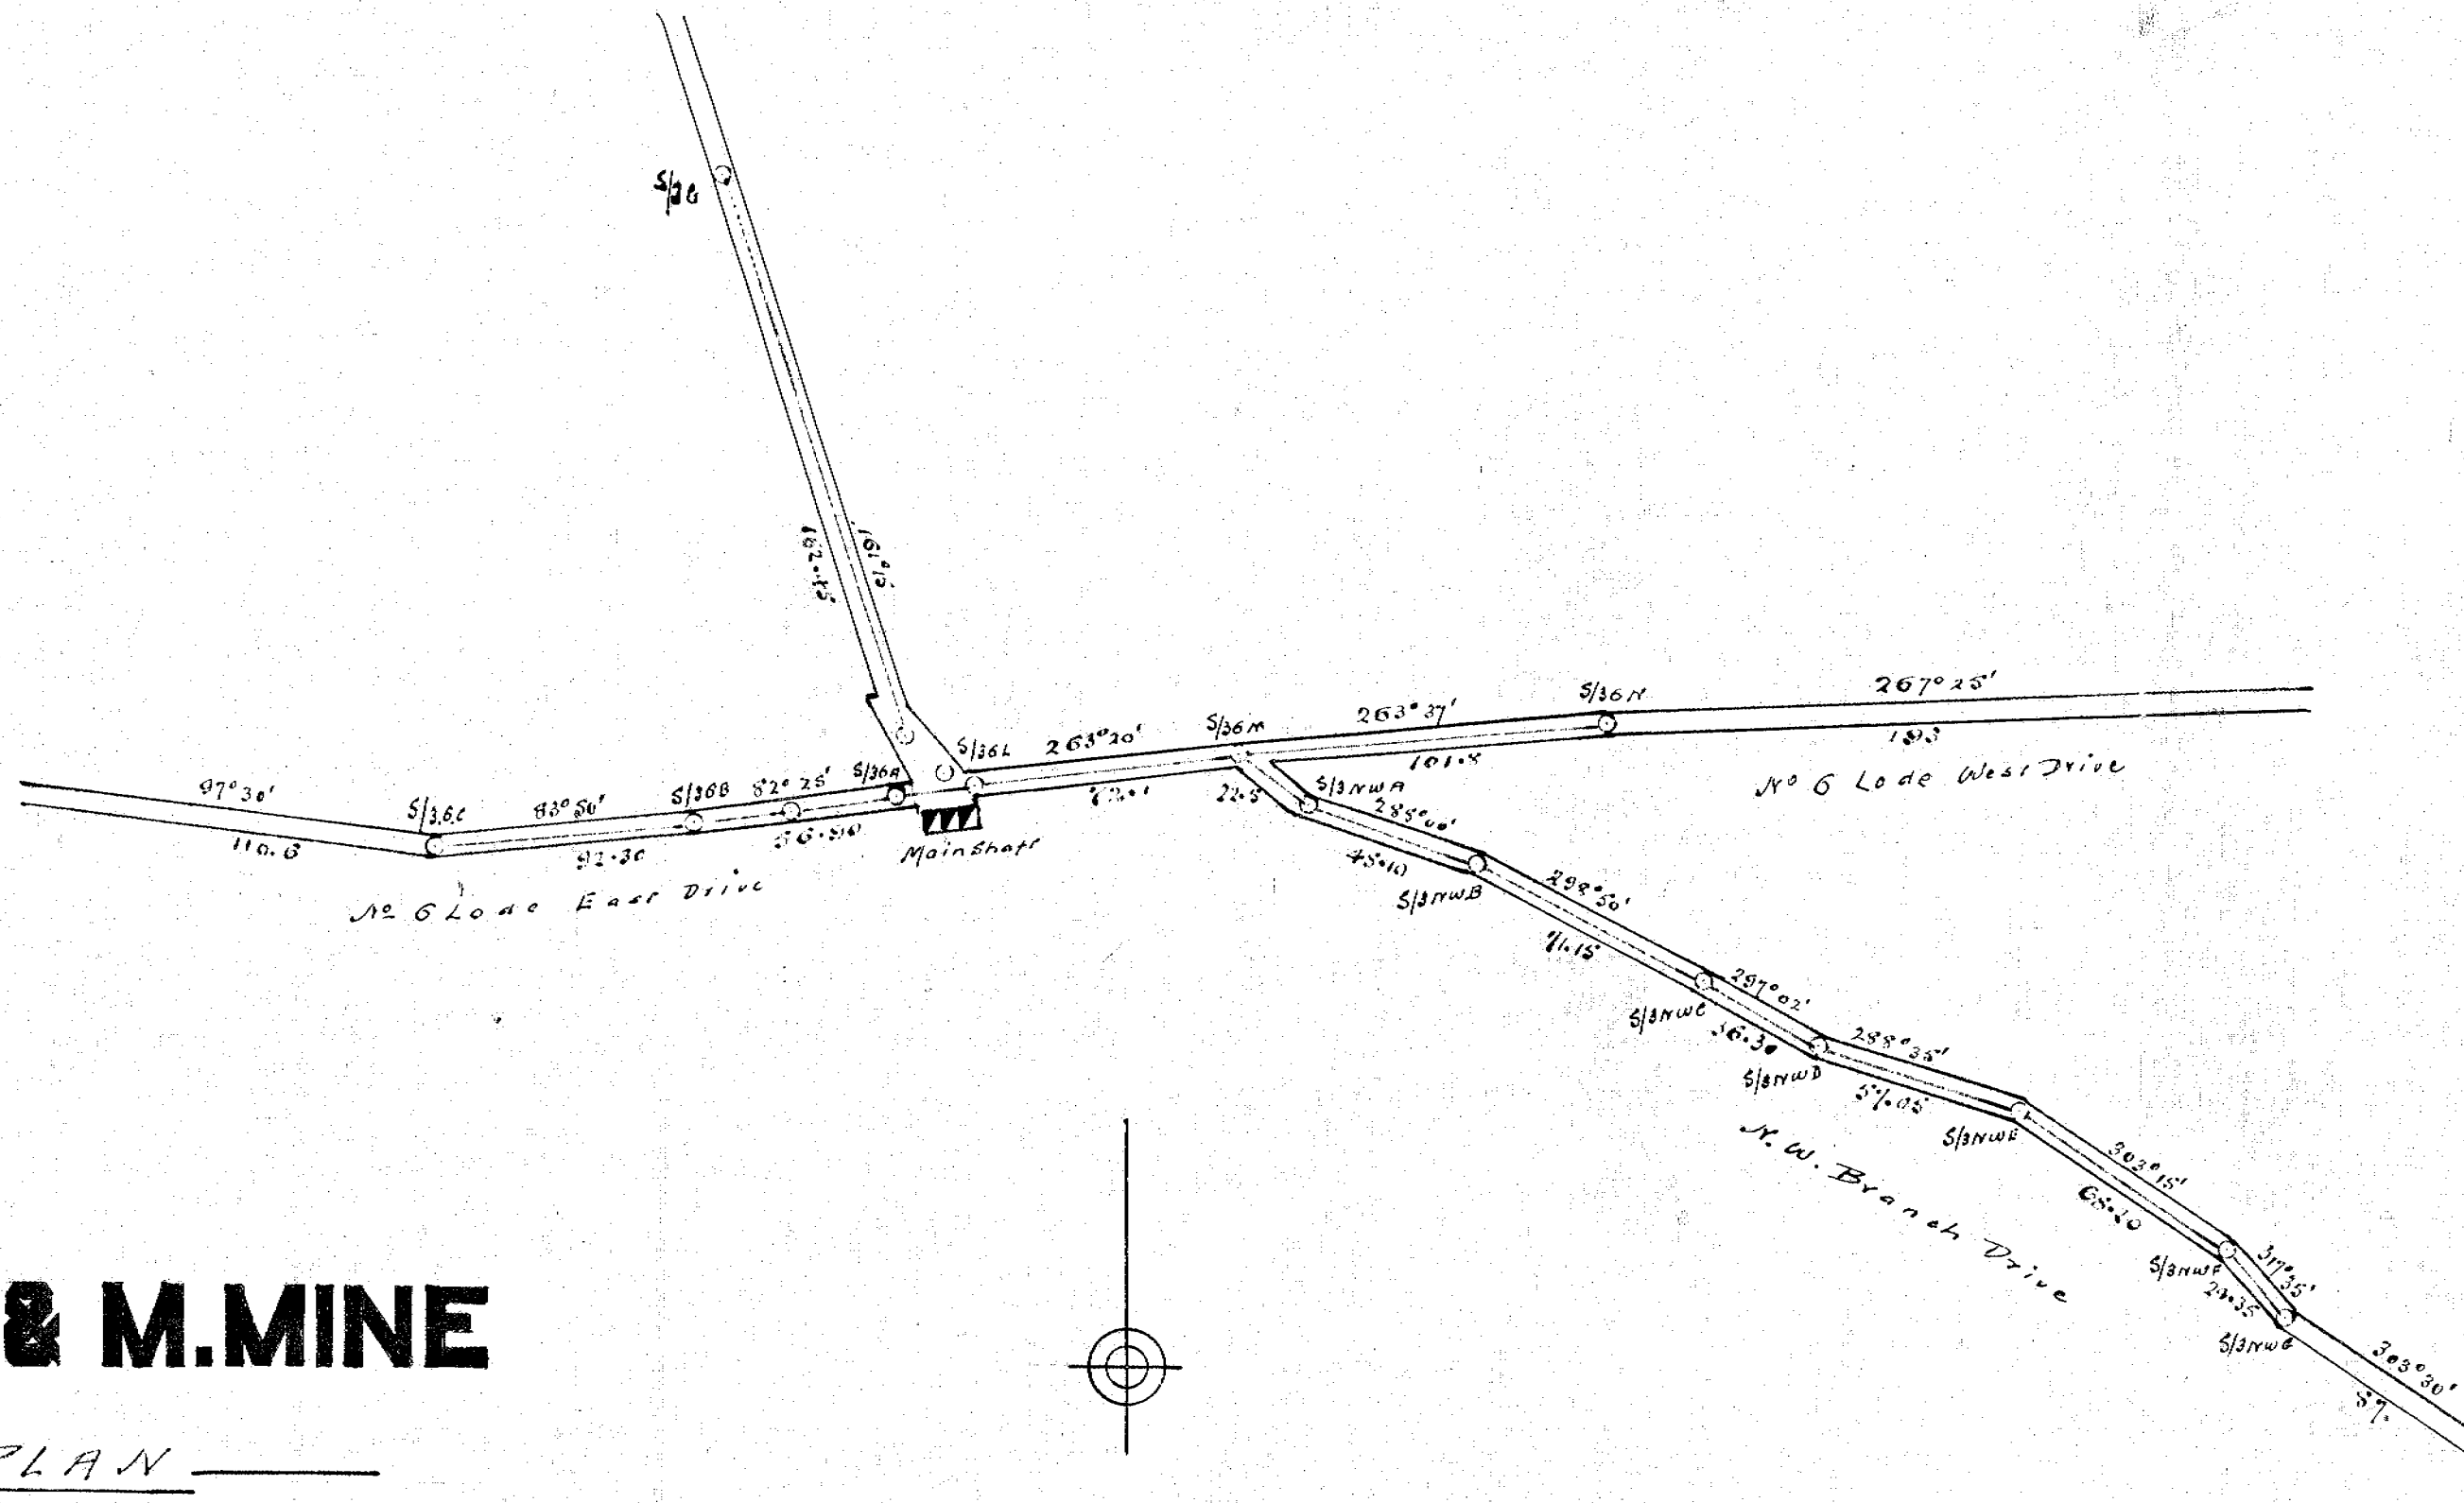

15-06

Inst. used S. T. S. Theodolite
Wm. S. Mitchell
15 July 19