



Som Mine Middlesex

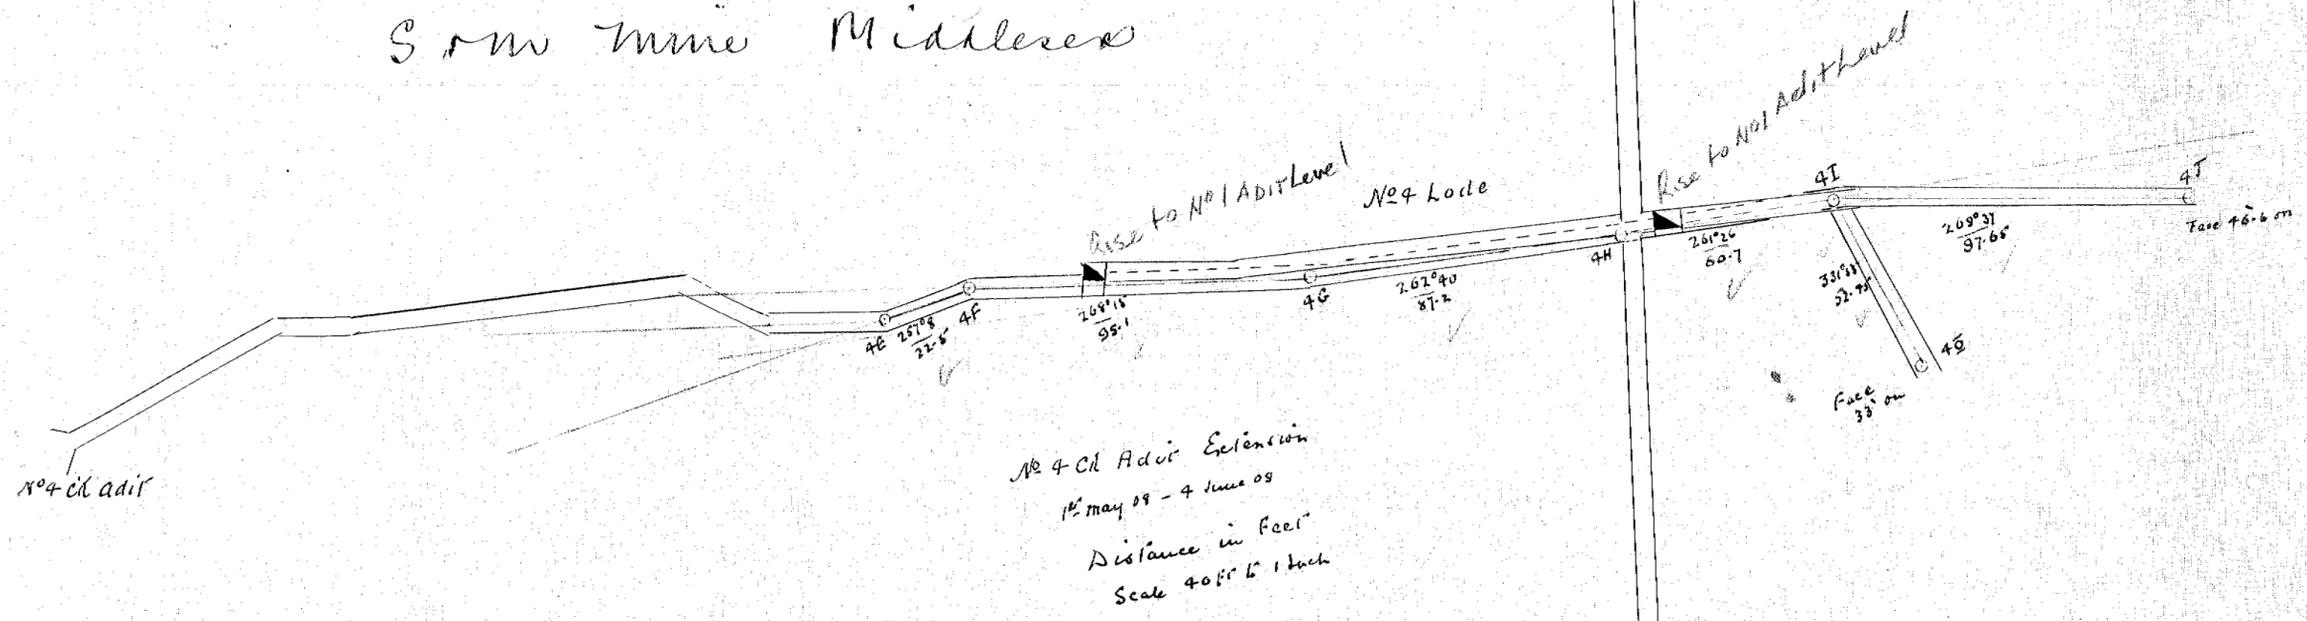


No. 4 Ch Adit Extension
 1st May 09 - 4 June 09
 Distance in Feet
 Scale 40 ft to 1 inch

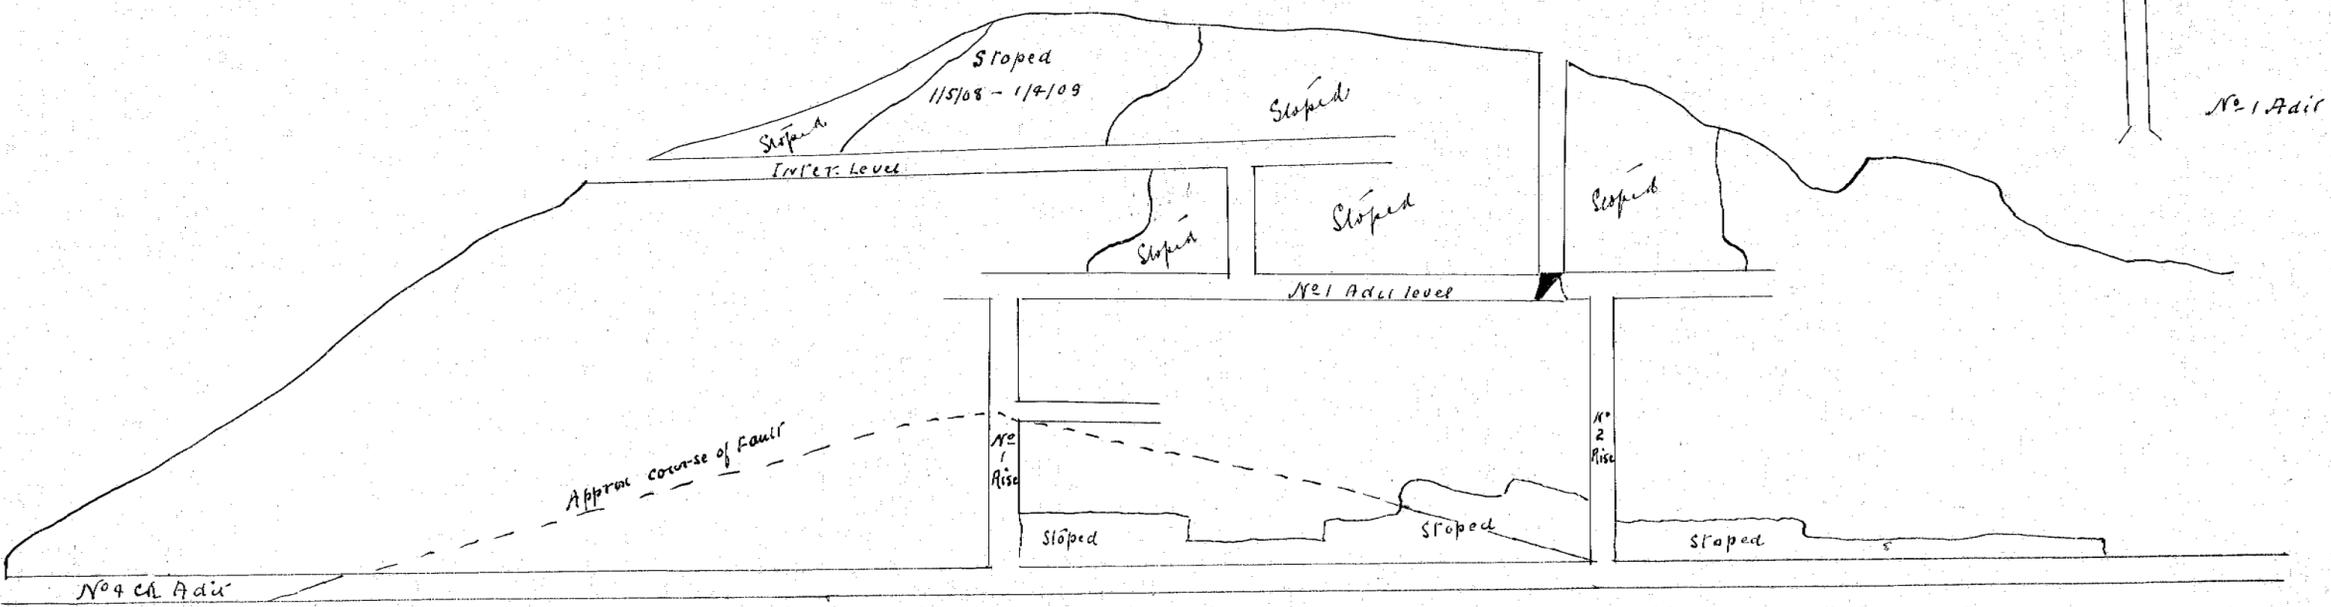

15-07

Wm E. Skelton
 7 June 09

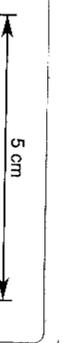

15-7