


5 cm

S. & M. Mine

Long Section No. 2, Lode

Scale 50 ft to 1 in

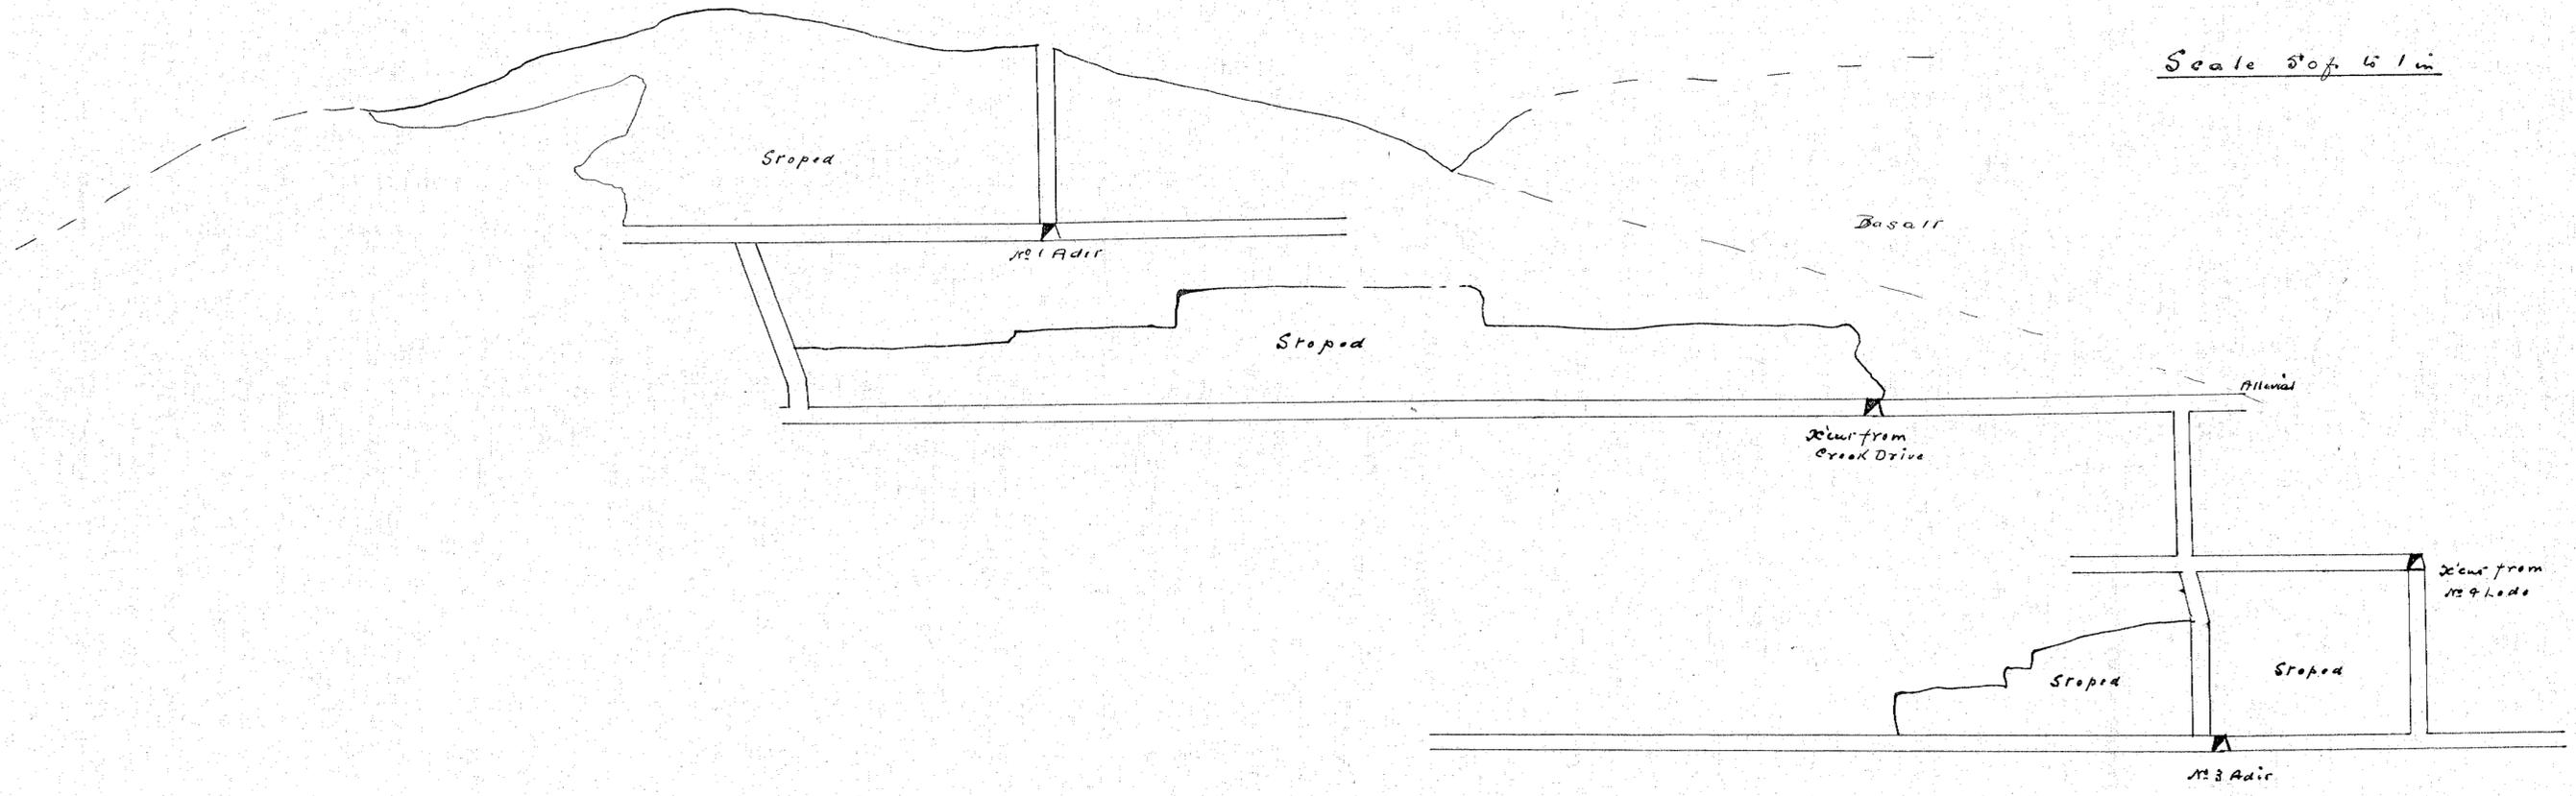

W.P.H.  
22/10/18

15-13