
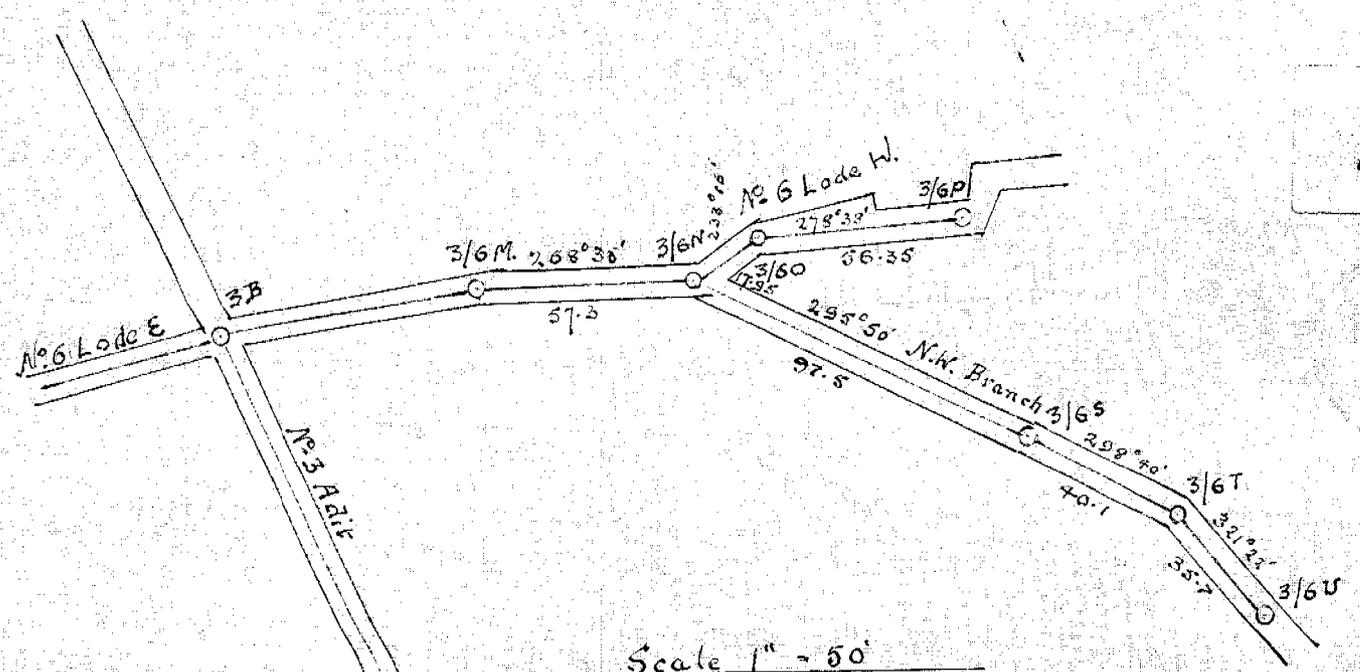


S & M Mine Moira

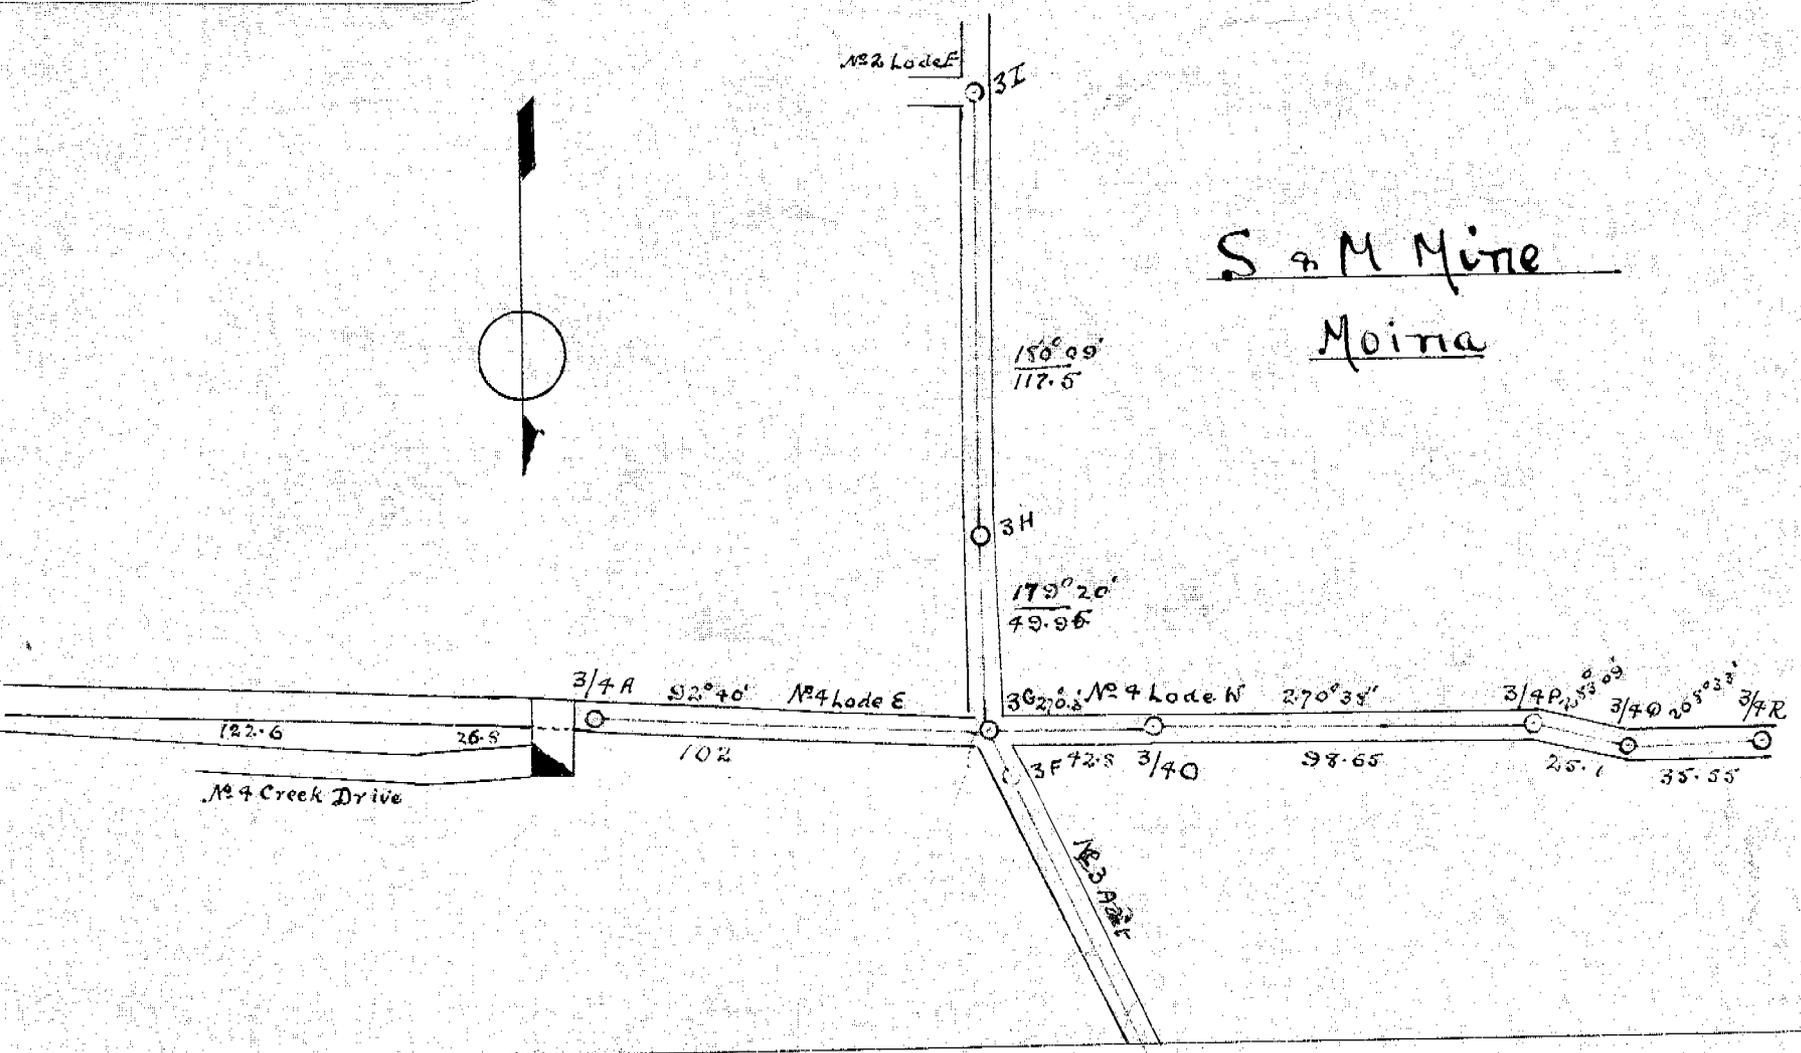

15-16

Scale 1" = 50'

Wm E. Hitchcock
3 Aug 11