
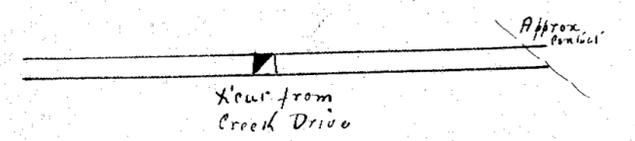


15-18


5 cm

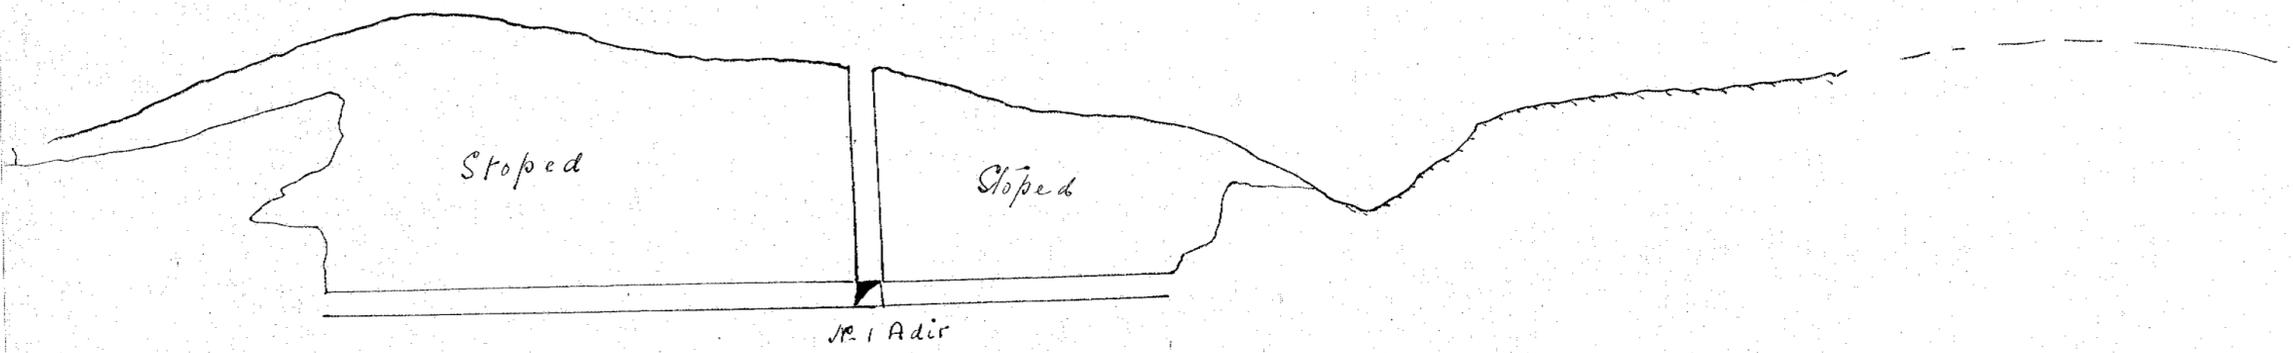

S + M Mine No 2 Lode Levels

Scale 1" = 50 F'

Wm E Hitchcock
28/7/13

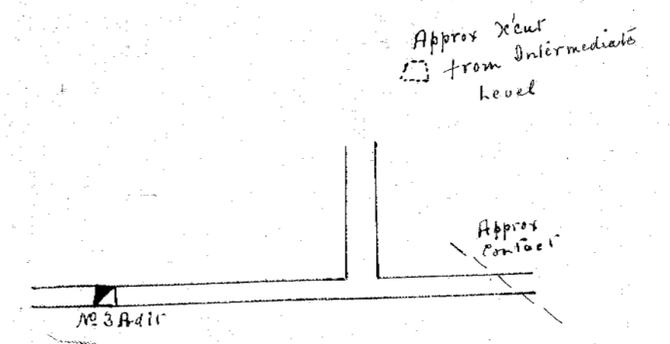

15-18

Wm E Hitchcock
29/7/13