


5 cm

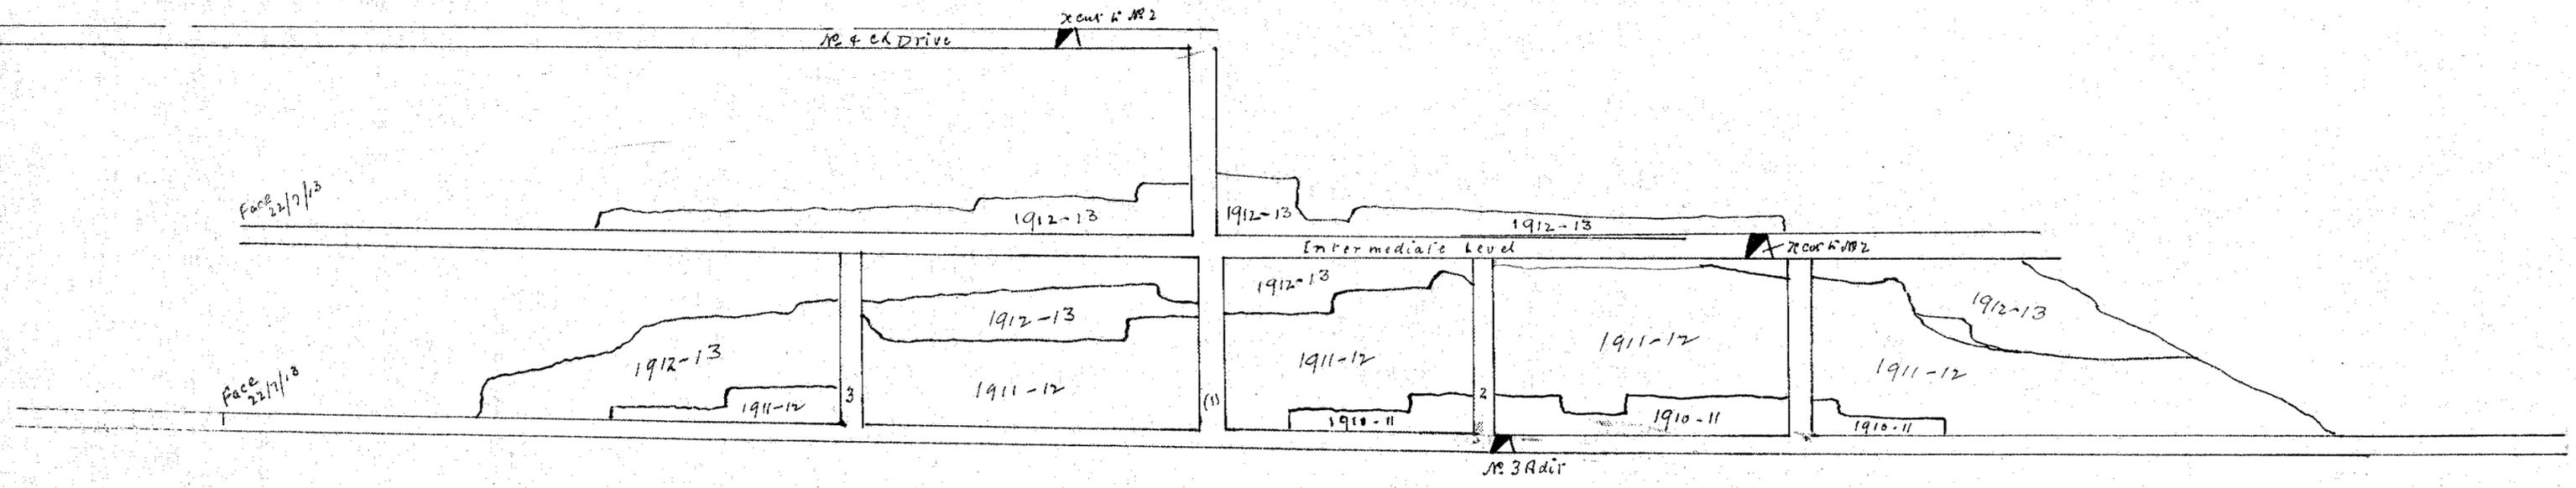

S + M. Mine Levels & Stopes Extensions

Scale 1" = 50 ft

No 2 Sketches
29-7-13

15-19

15-19