



5 cm

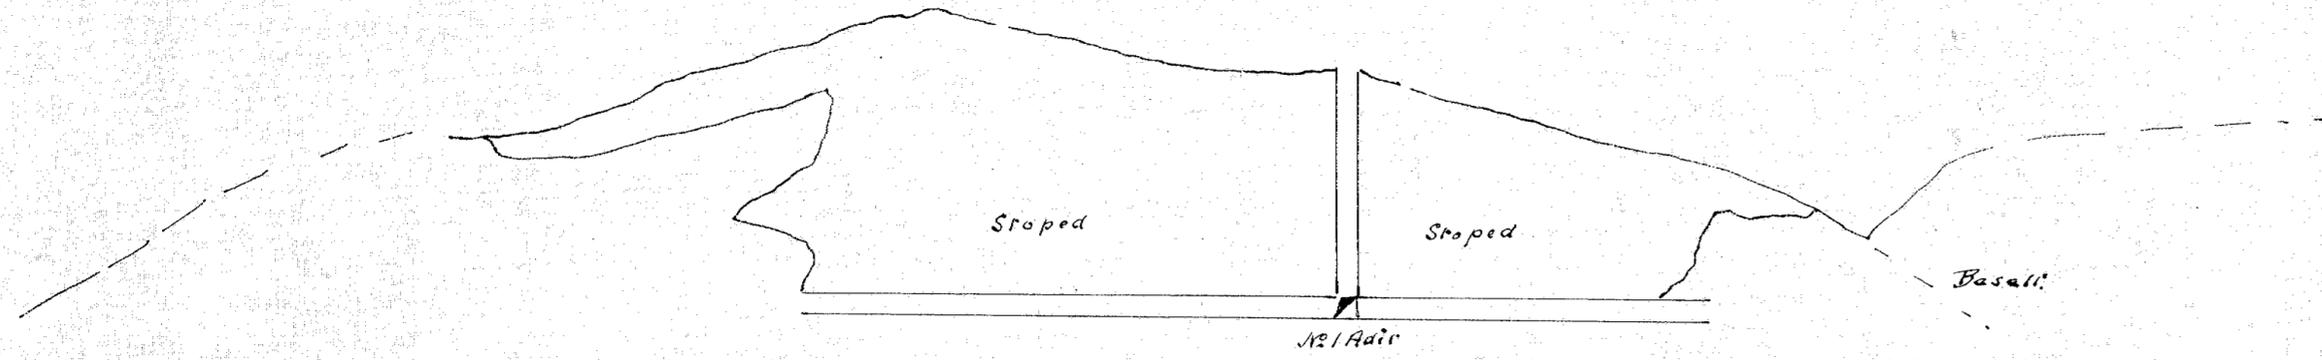

S & H. Mine  
Moine  
No 2 lode Scale 1 inch = 50 ft.

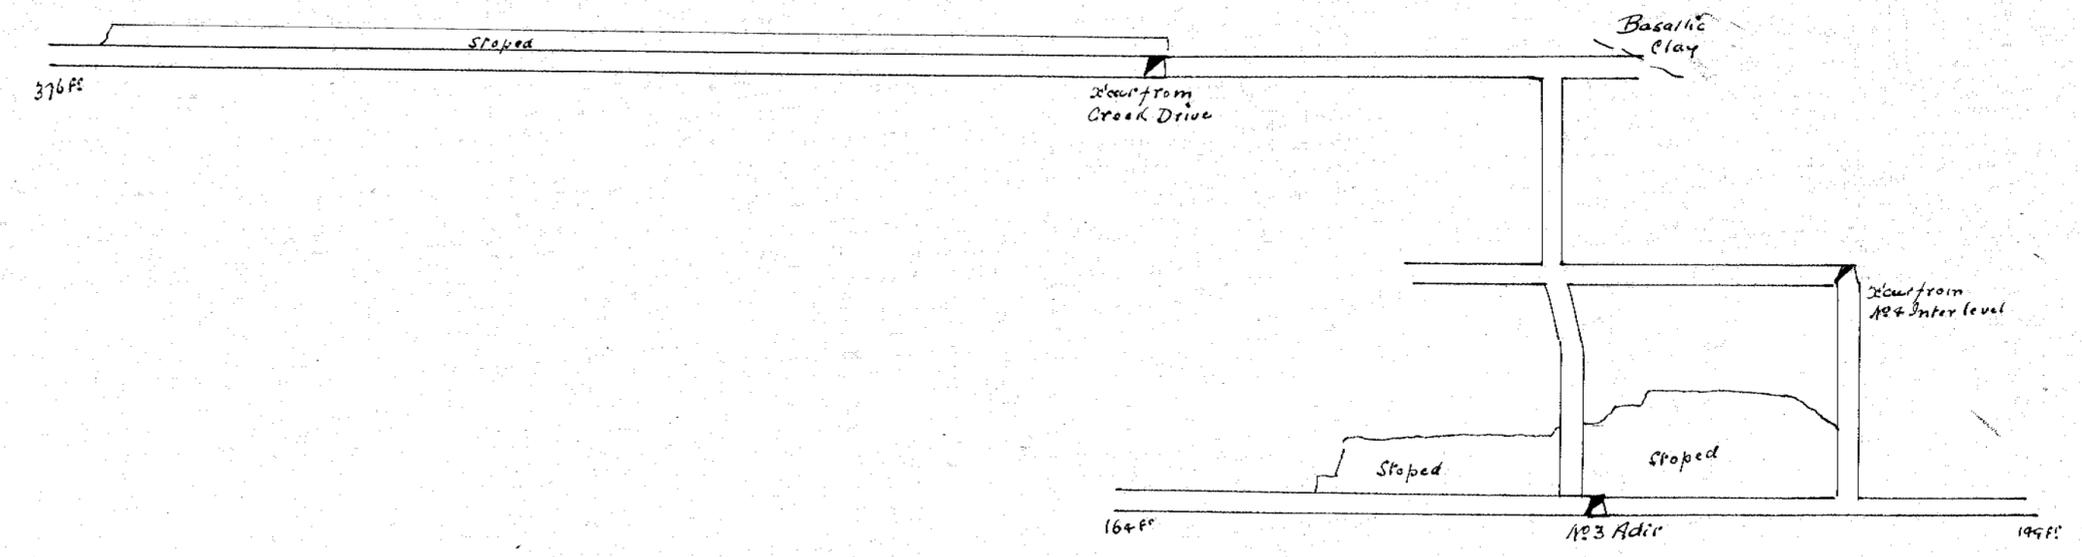

15-27

Wm S Hitchcock  
 31 July 15