
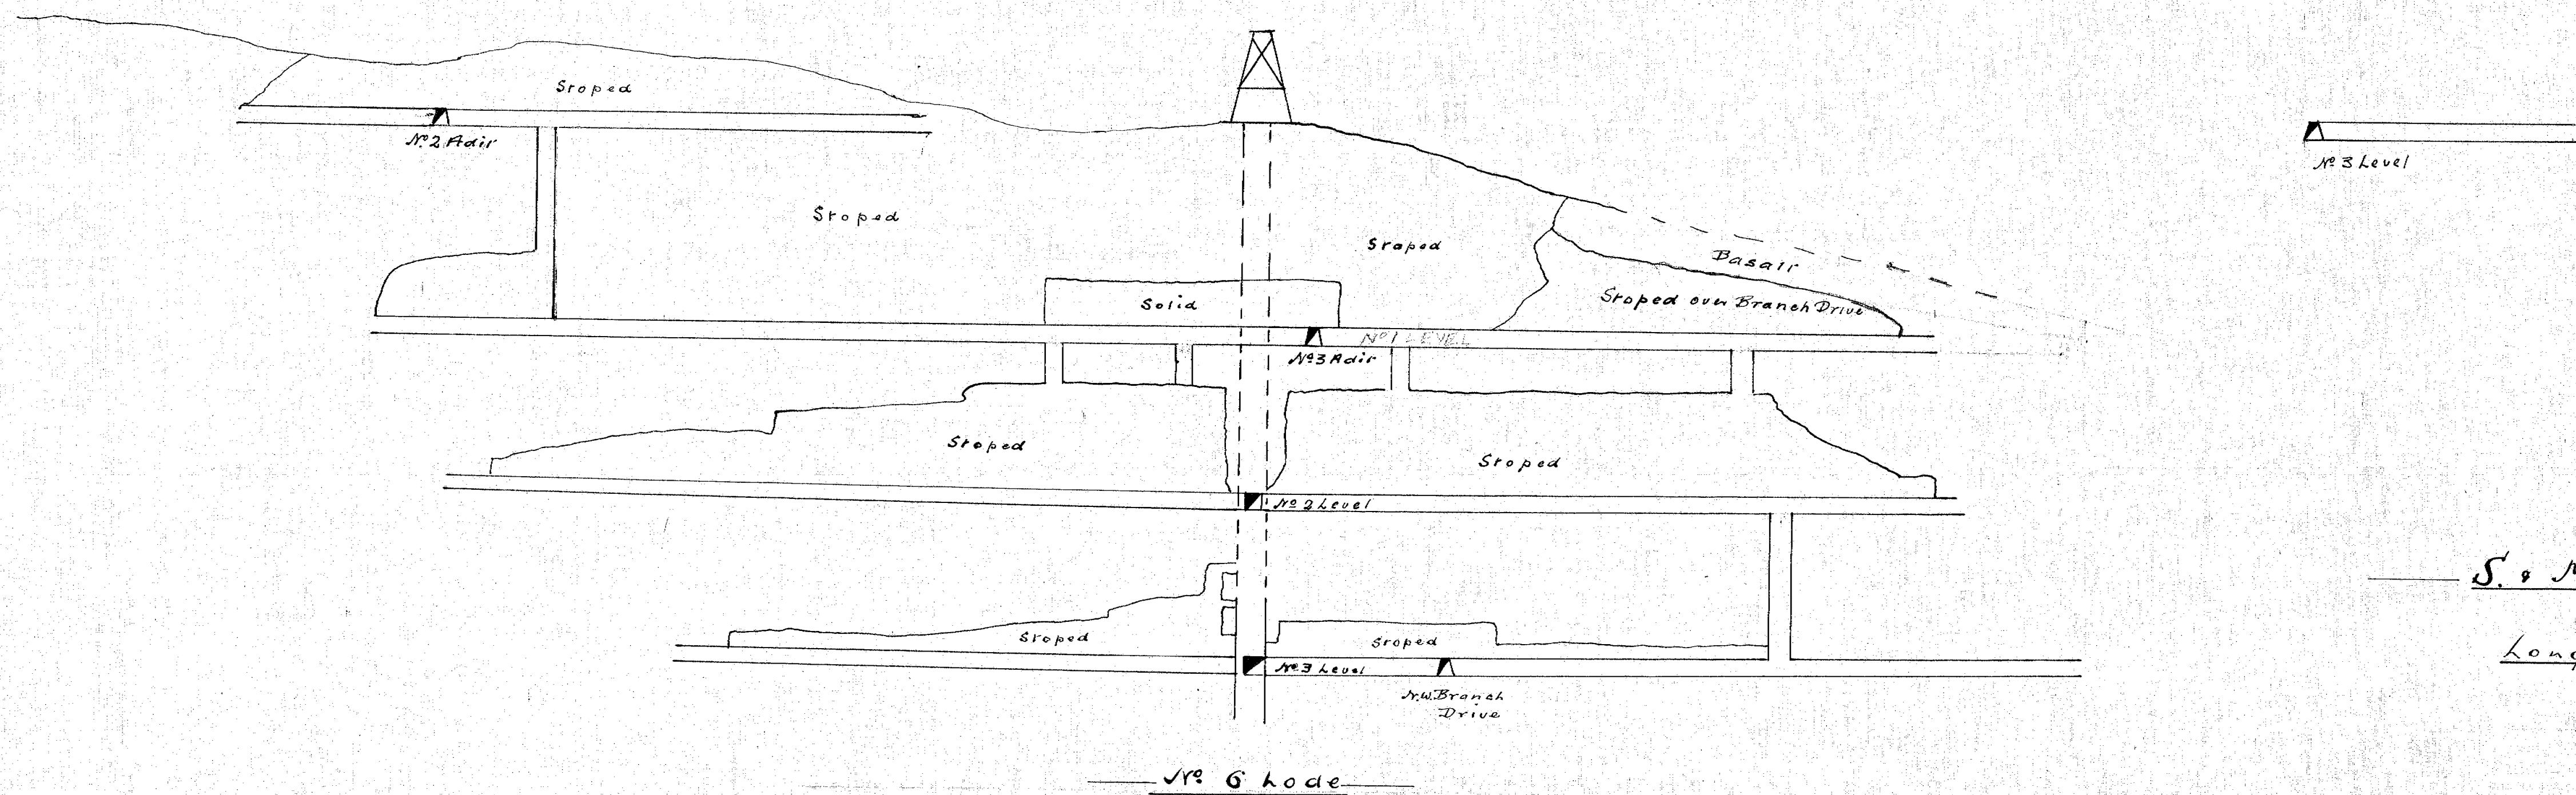


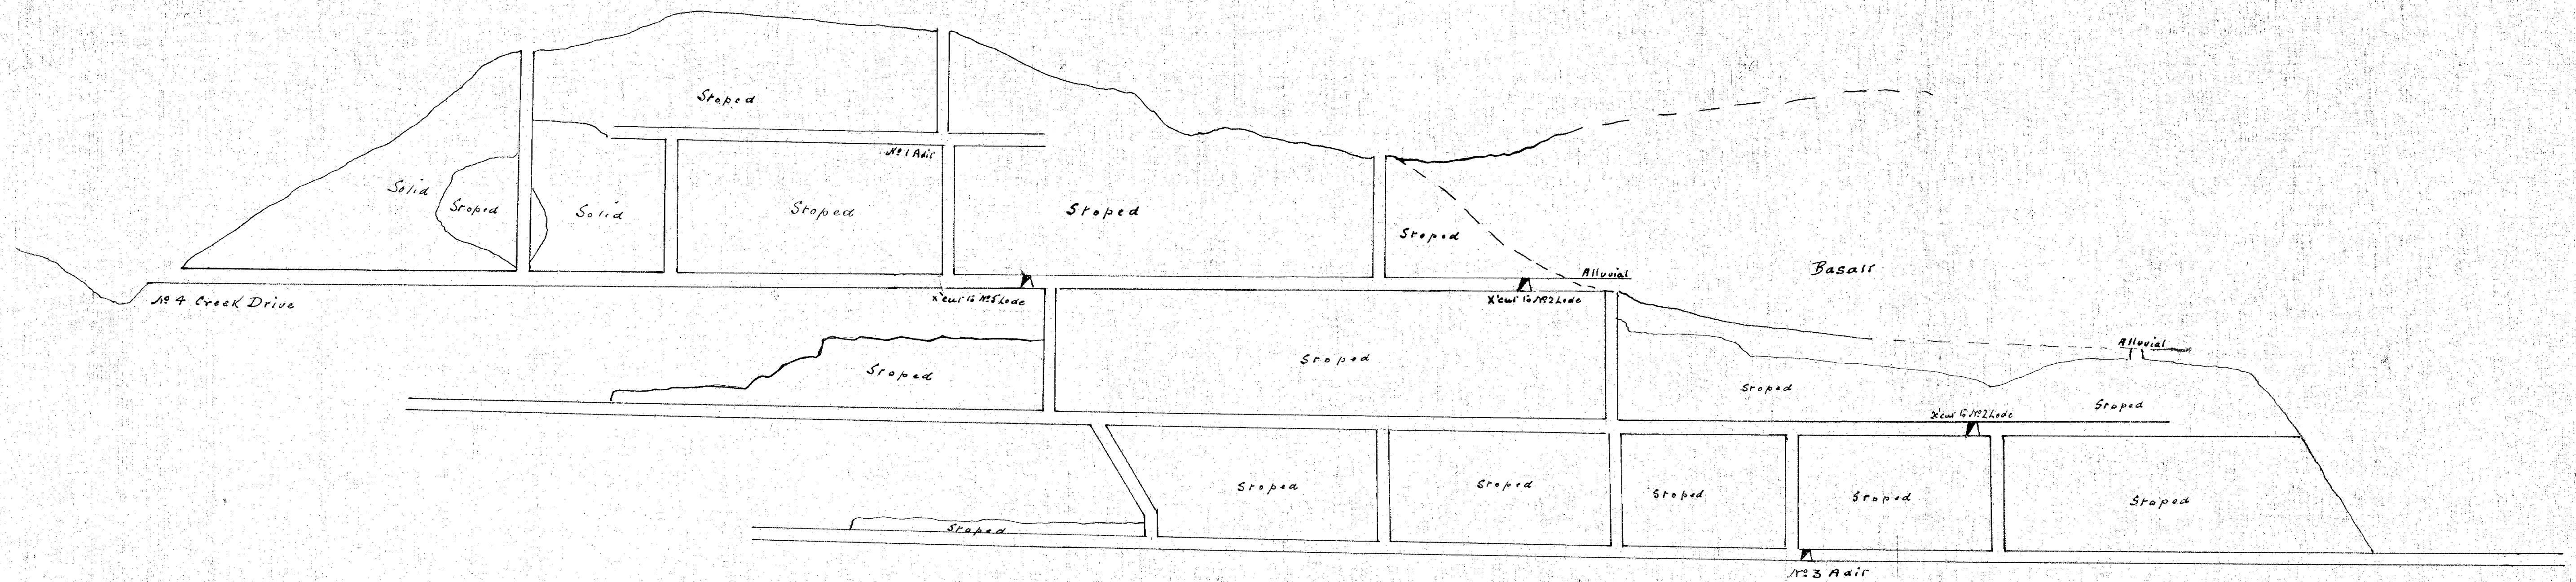

S. & M. Mine

Long' Sections Nos 4 & 6 Lodes

Scale 50 ft 1 in