


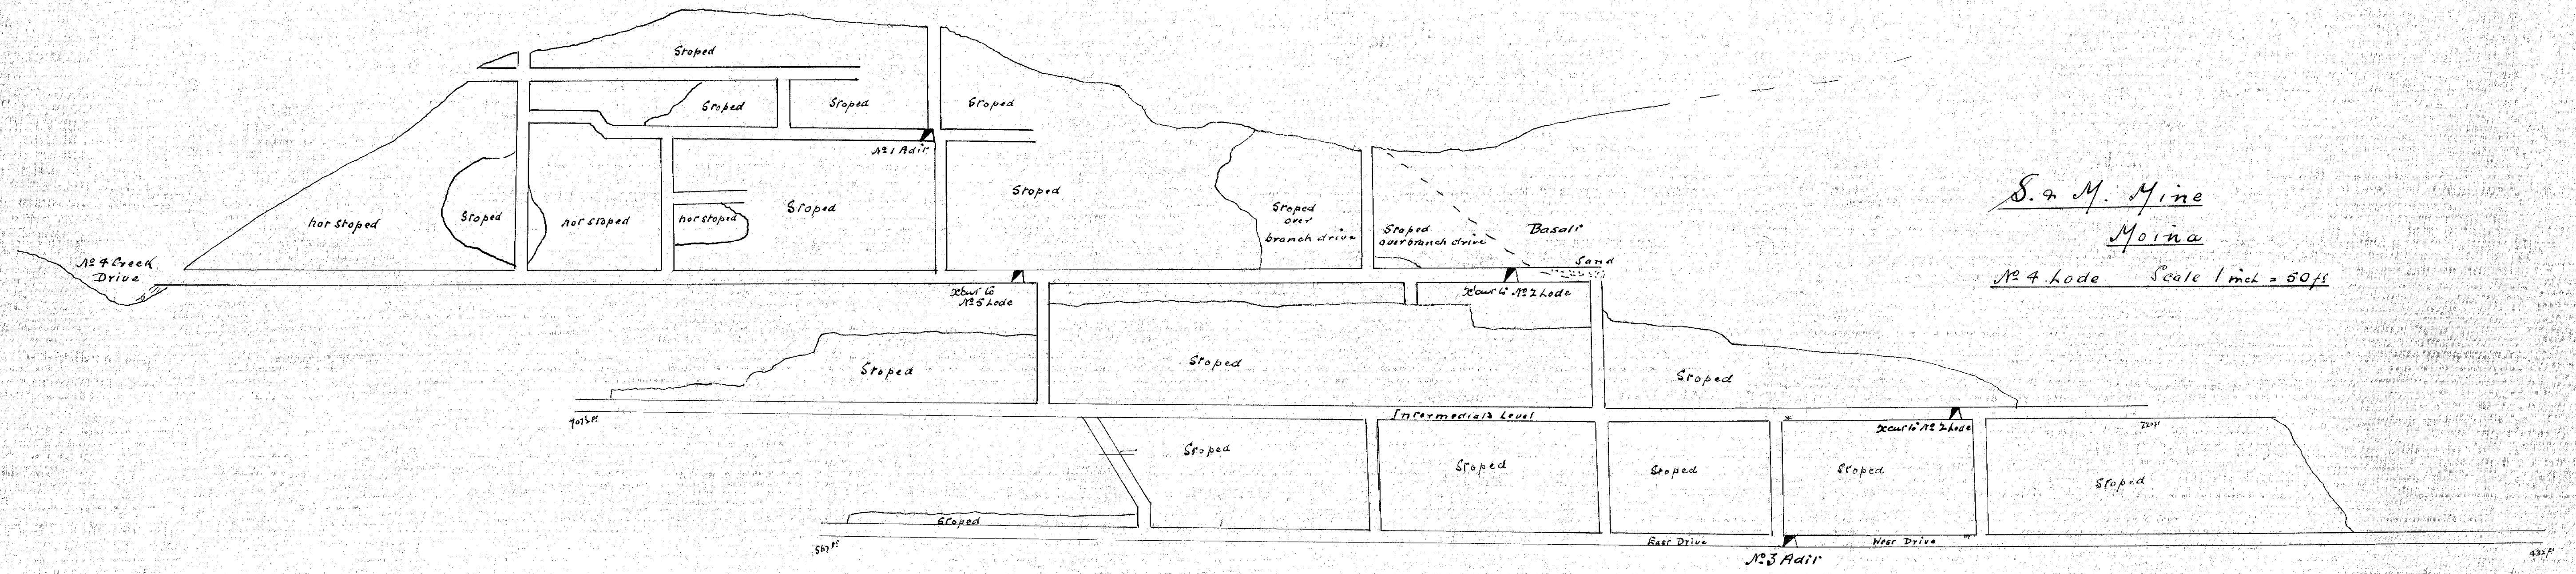

S. & M. Mine
Moine
No. 4 Lode Scale 1 inch = 50 ft

5 cm

Wm S. Hitchcock
31 July 15
15-30