


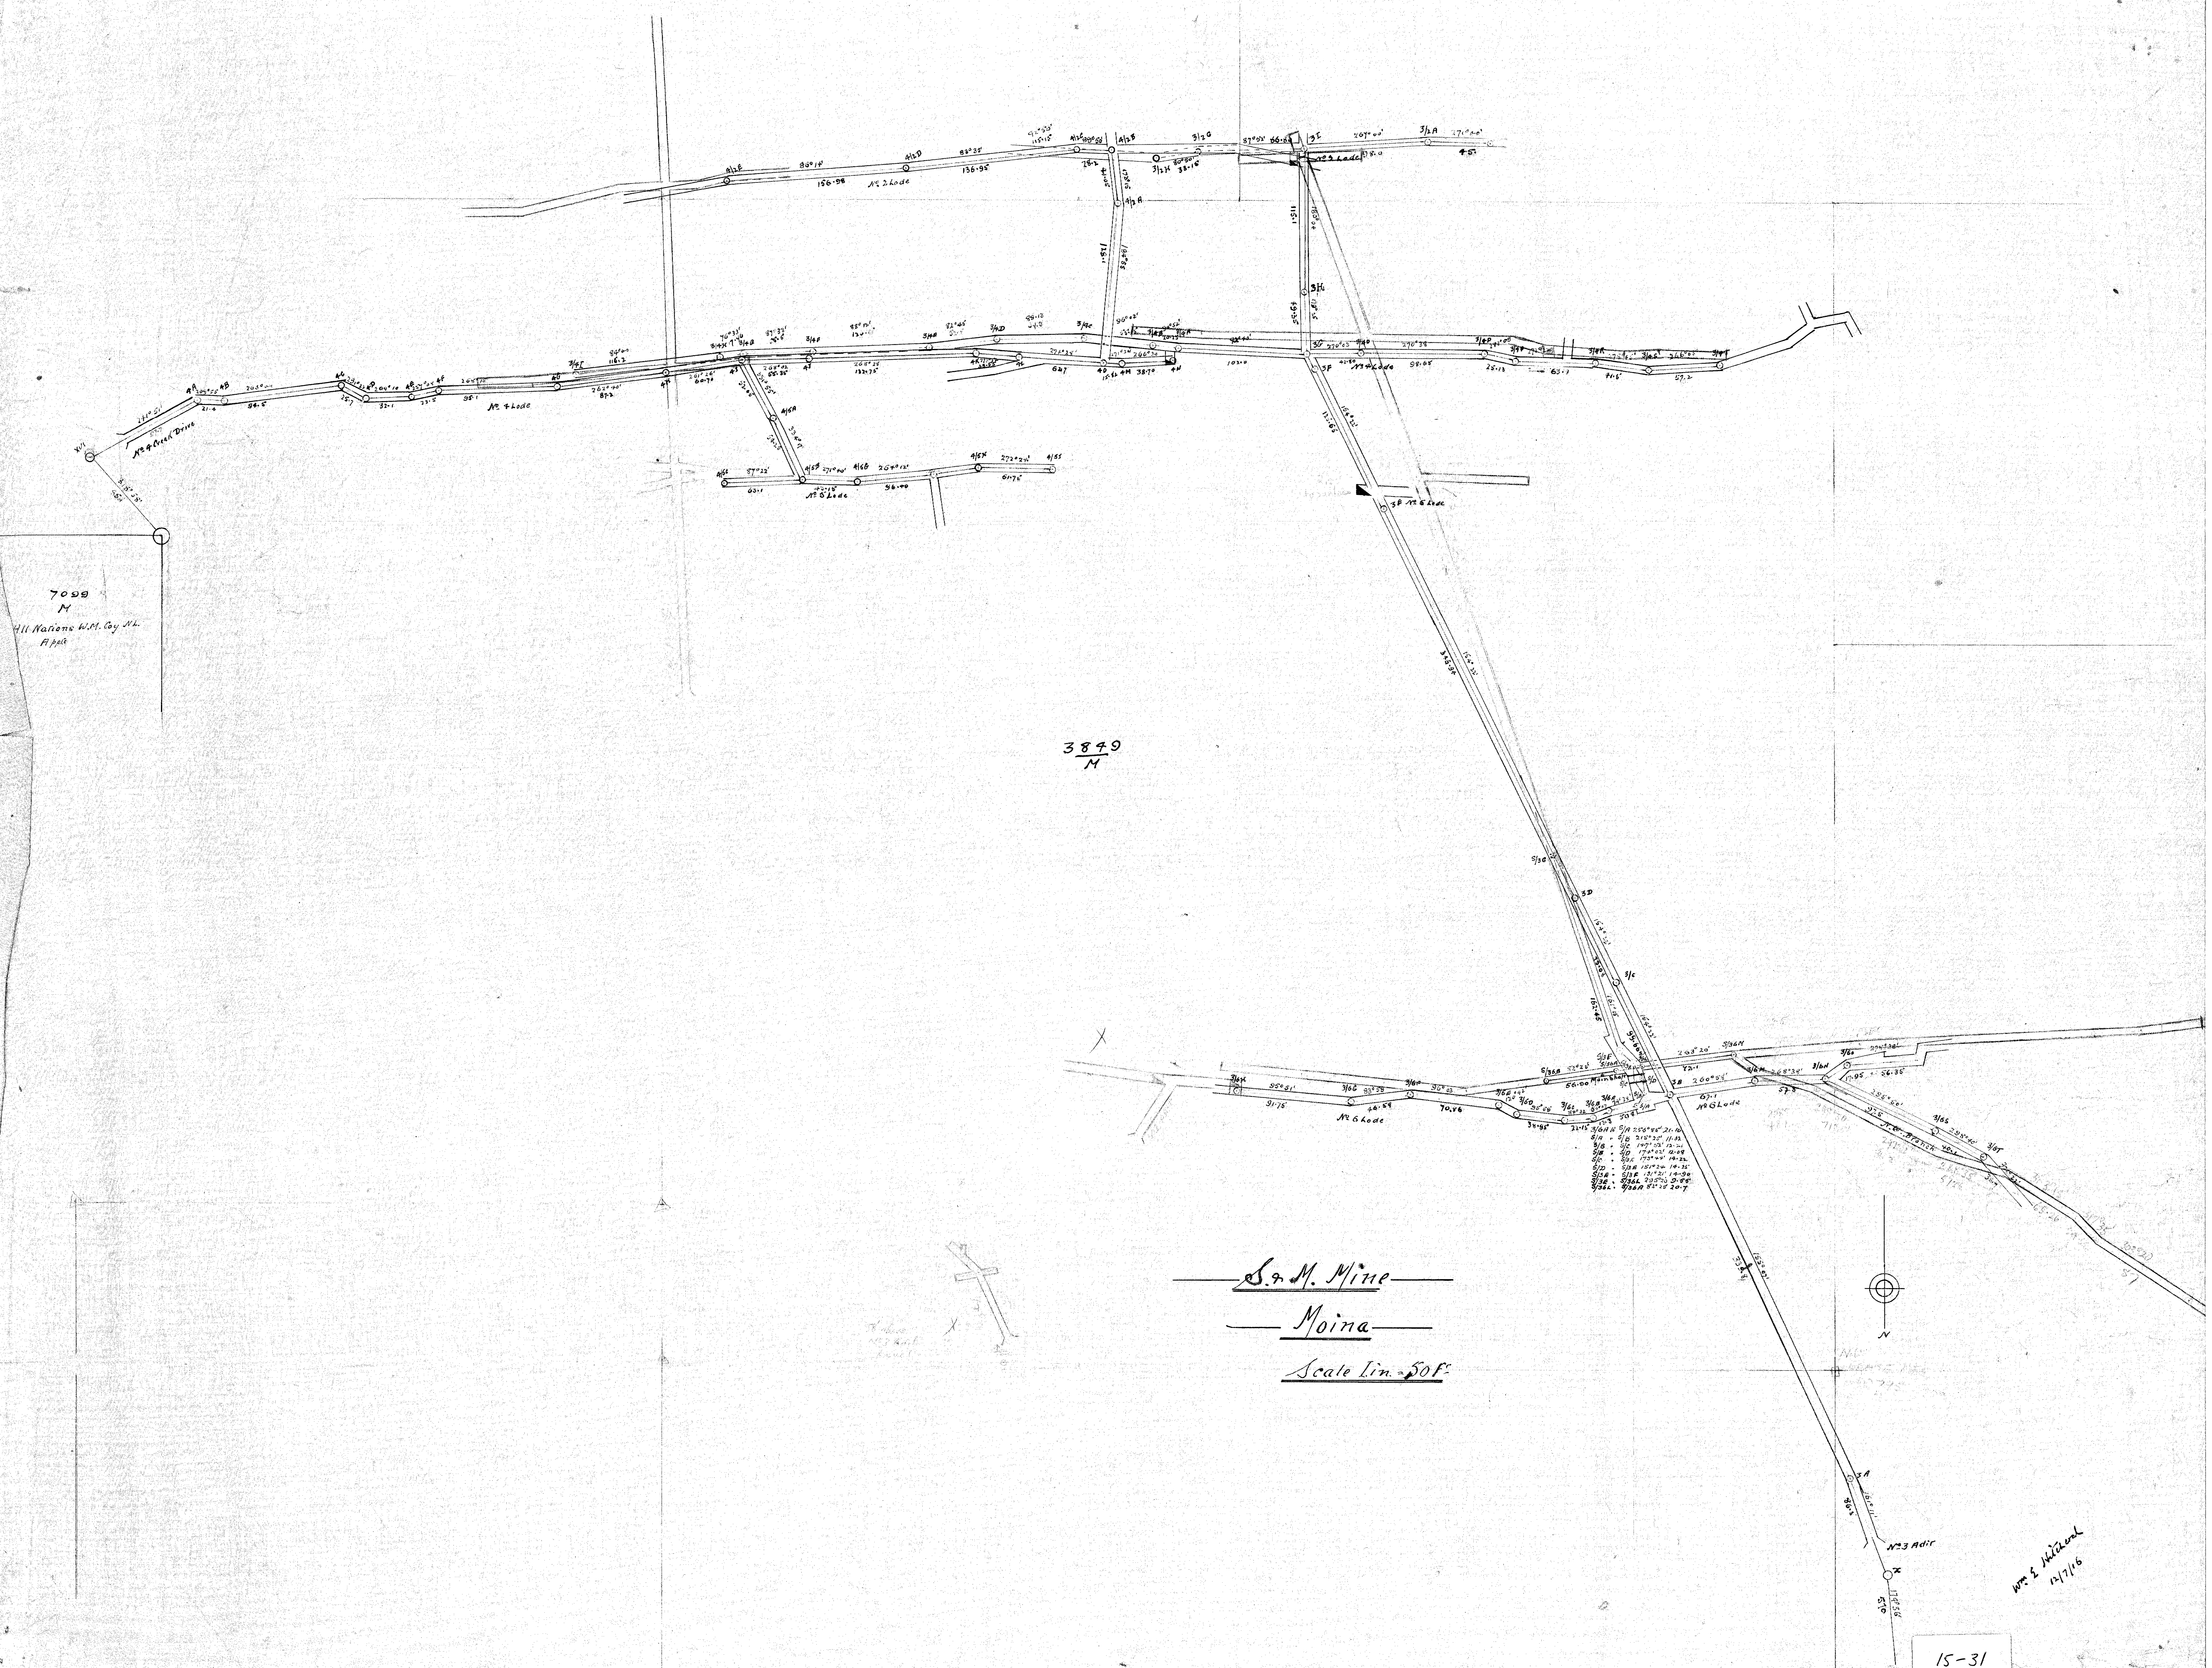

7000
ft
Hill Nations W.M. Coy. N.H.
1895

3849
ft

S. M. Mine
Moine
Scale 1 in = 50 ft

W. S. Hildner
12/1/16

15-31