



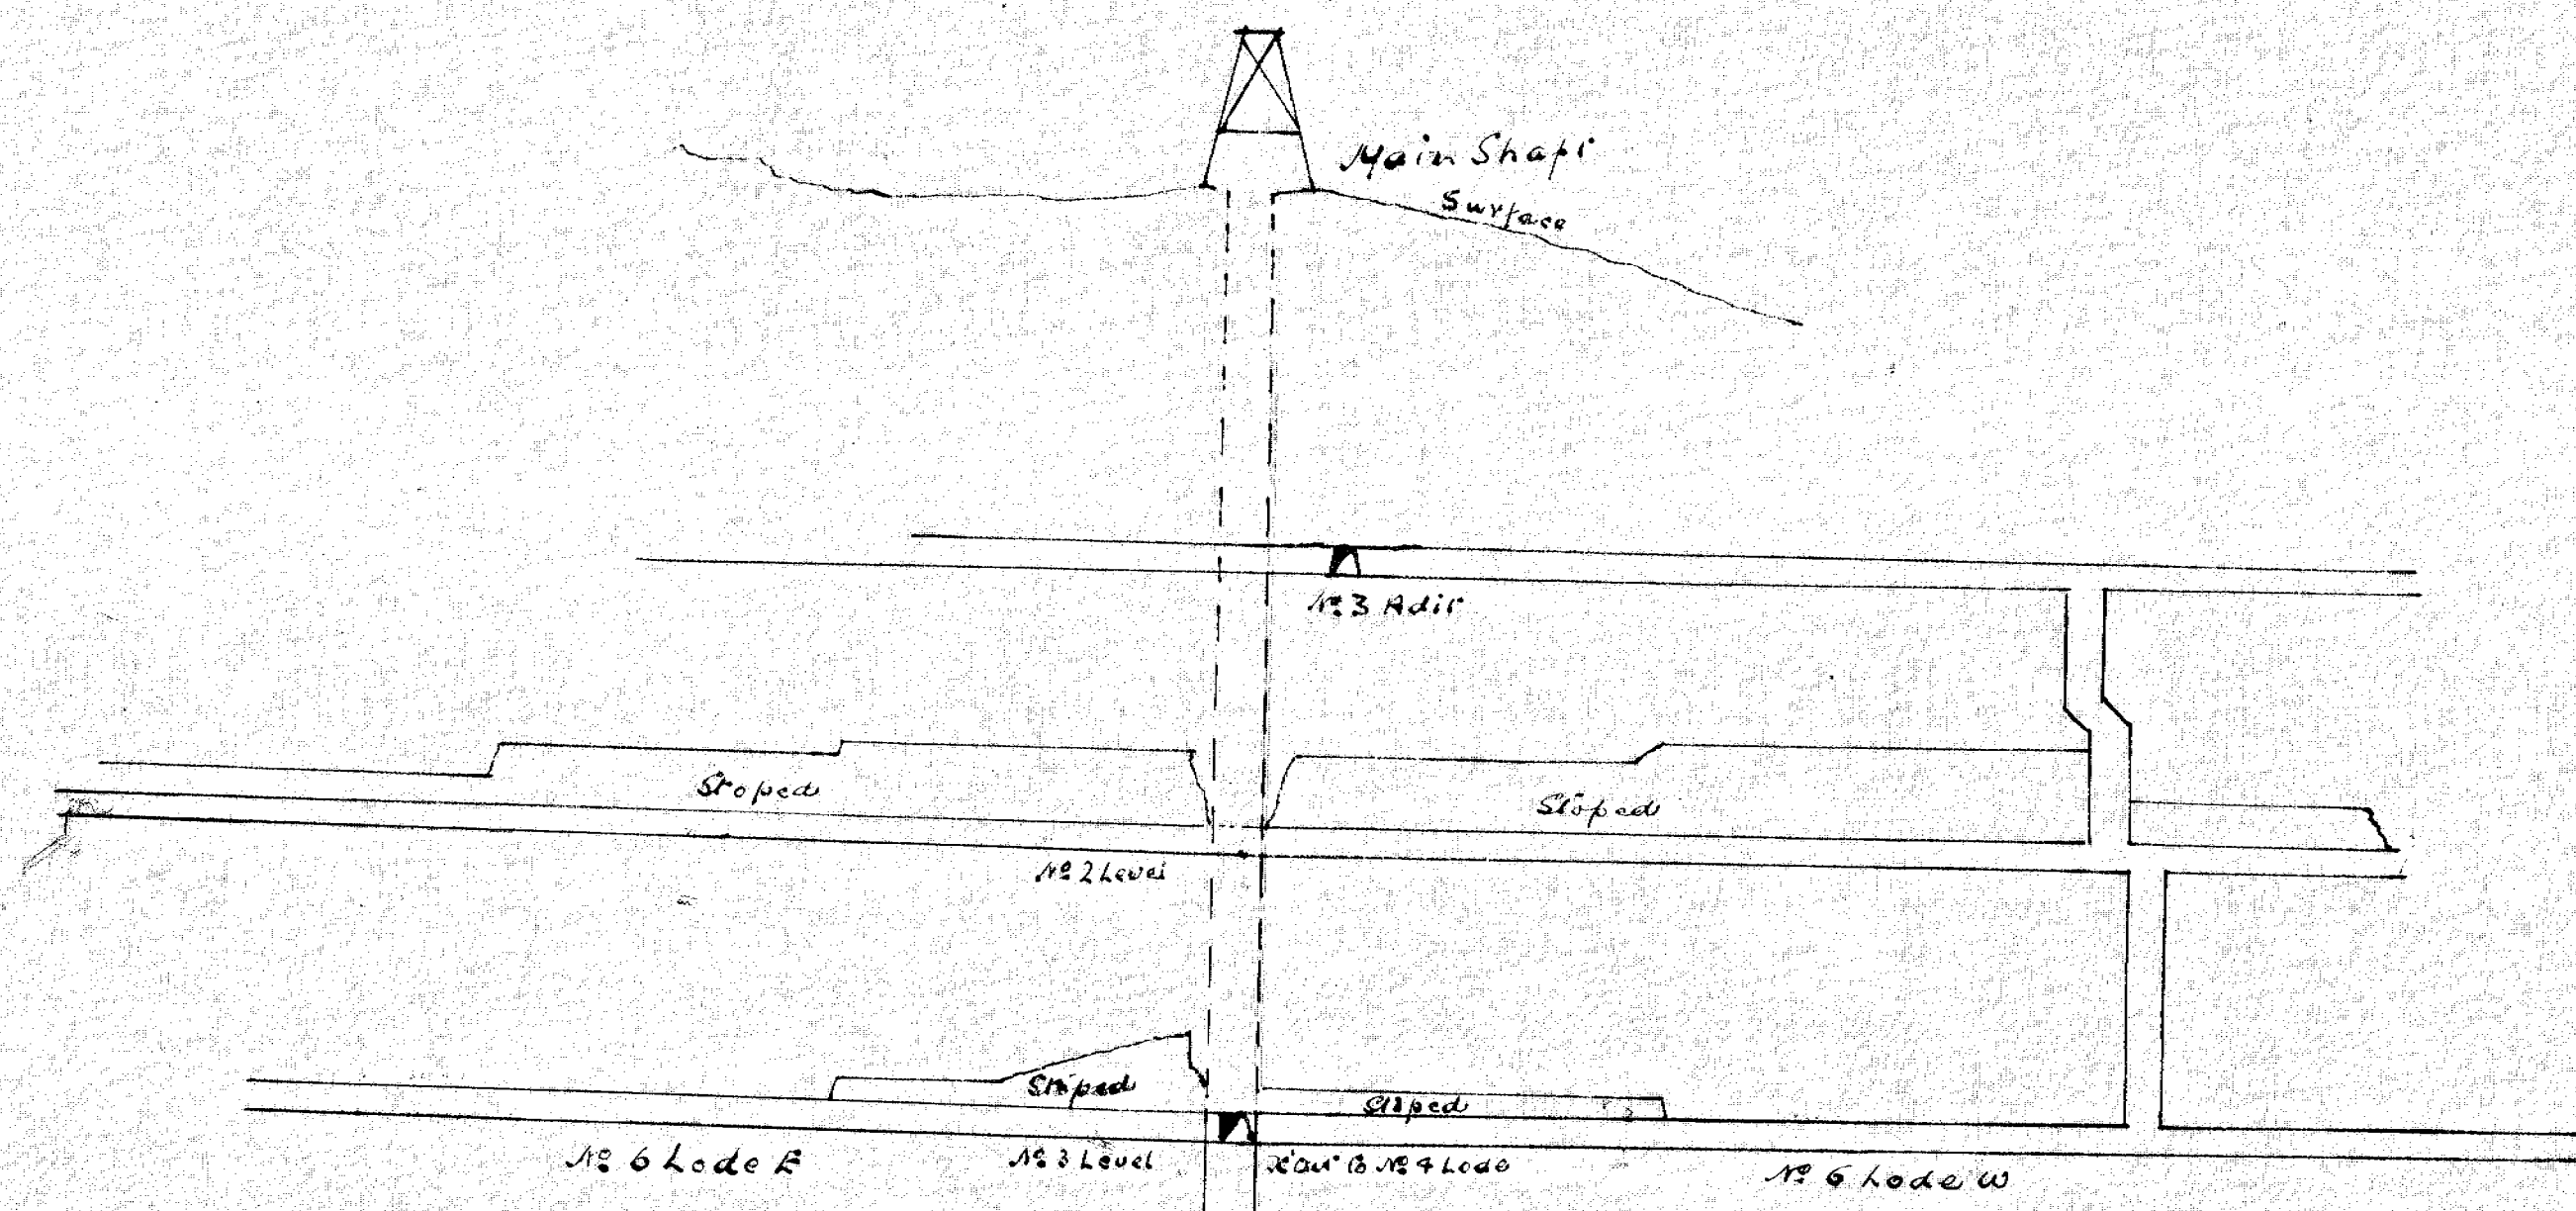

Section No 6 Level
Scale 50 ft to 1 in

— S. Mine —
Moine

W. E. Hutchings
10.8.17

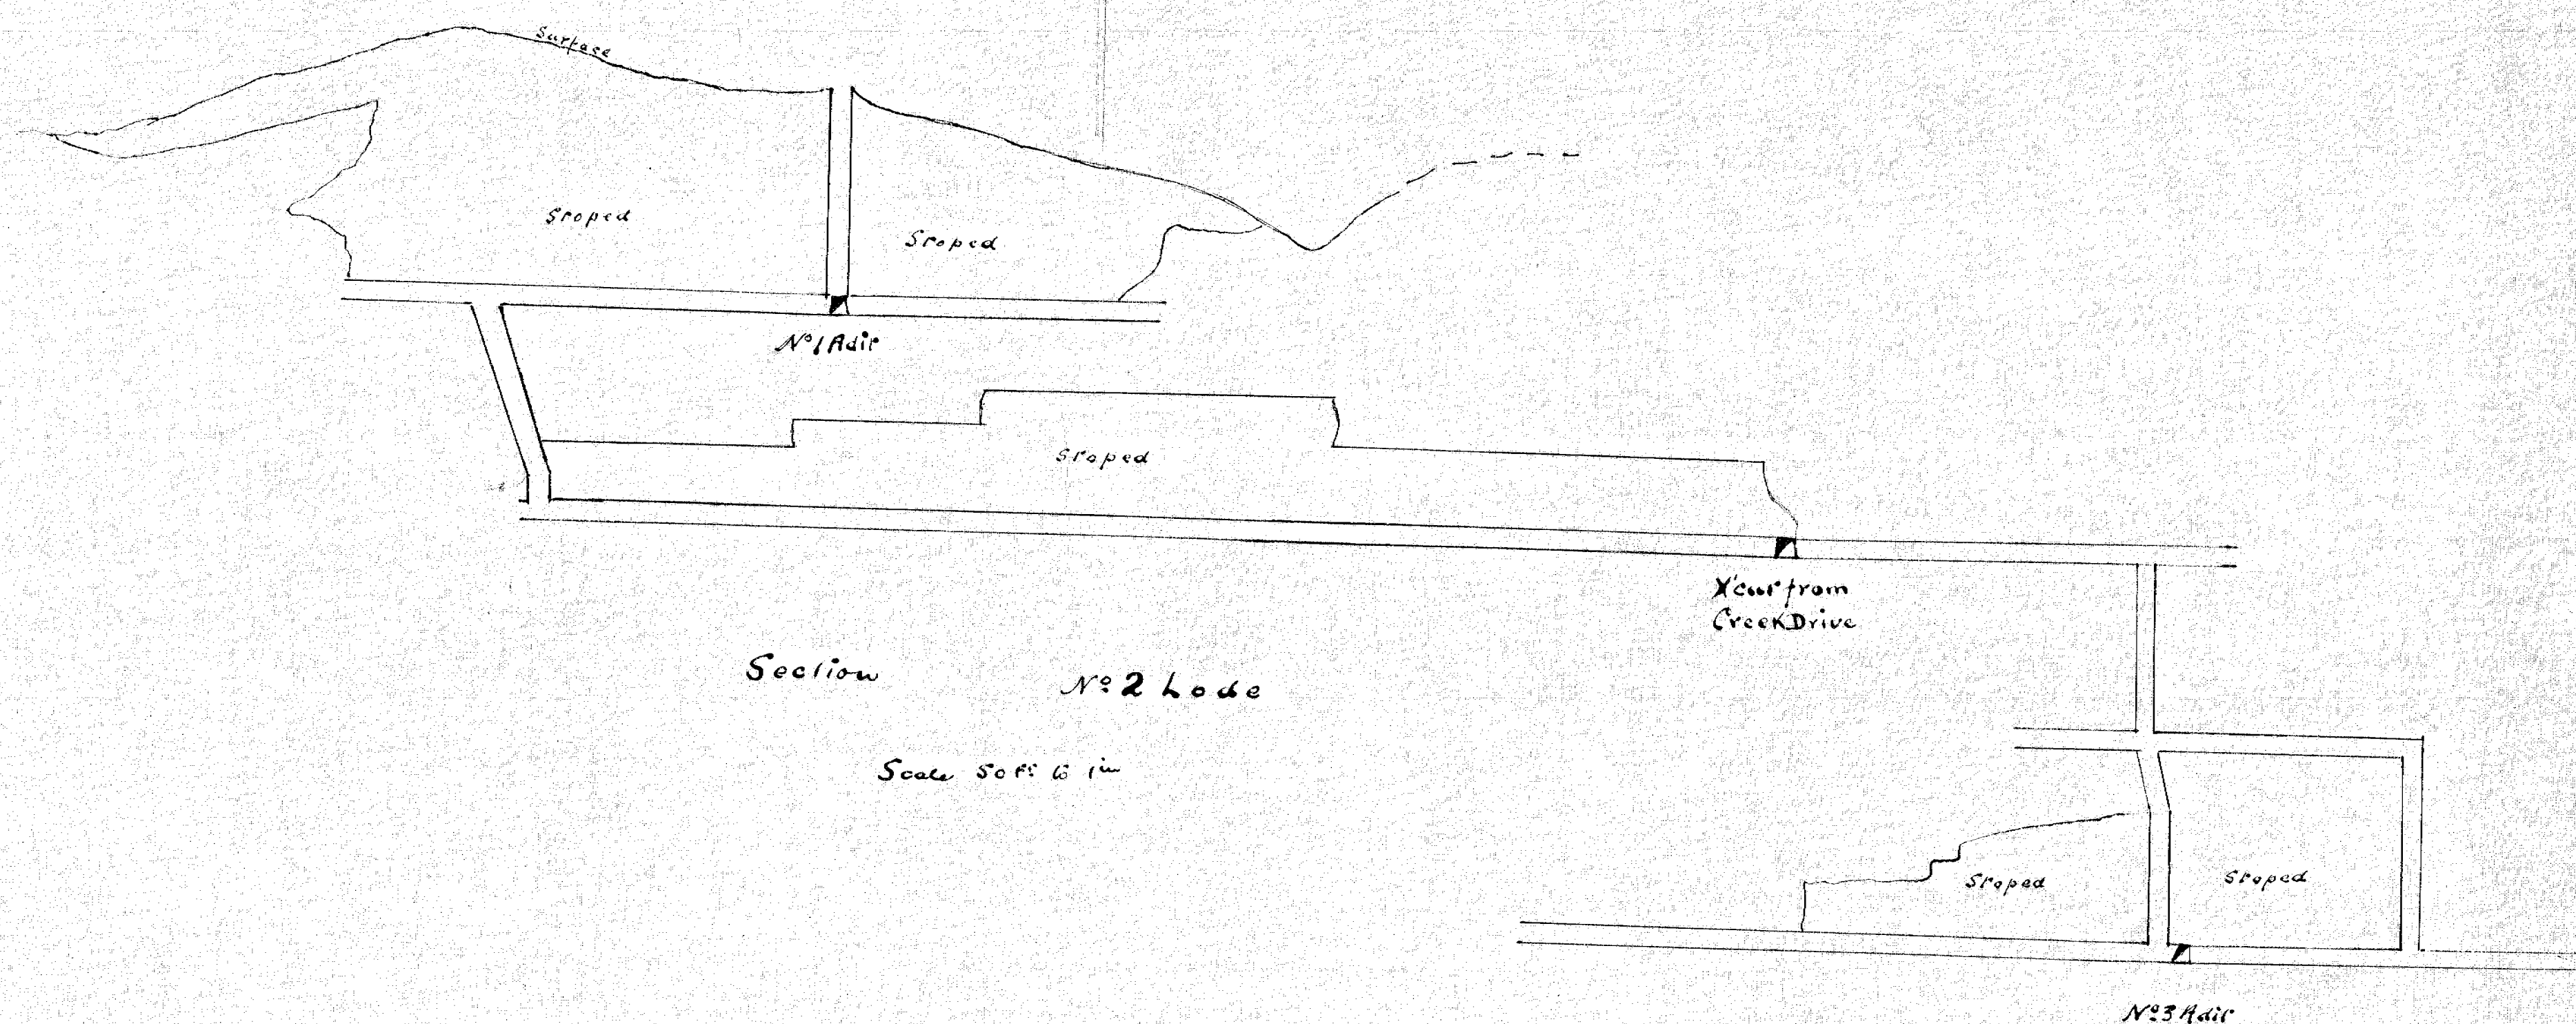

Section No 2 Level

Scale 50 ft to 1 in

No 3 Adit