


15-37
T.C.O.
LARGE

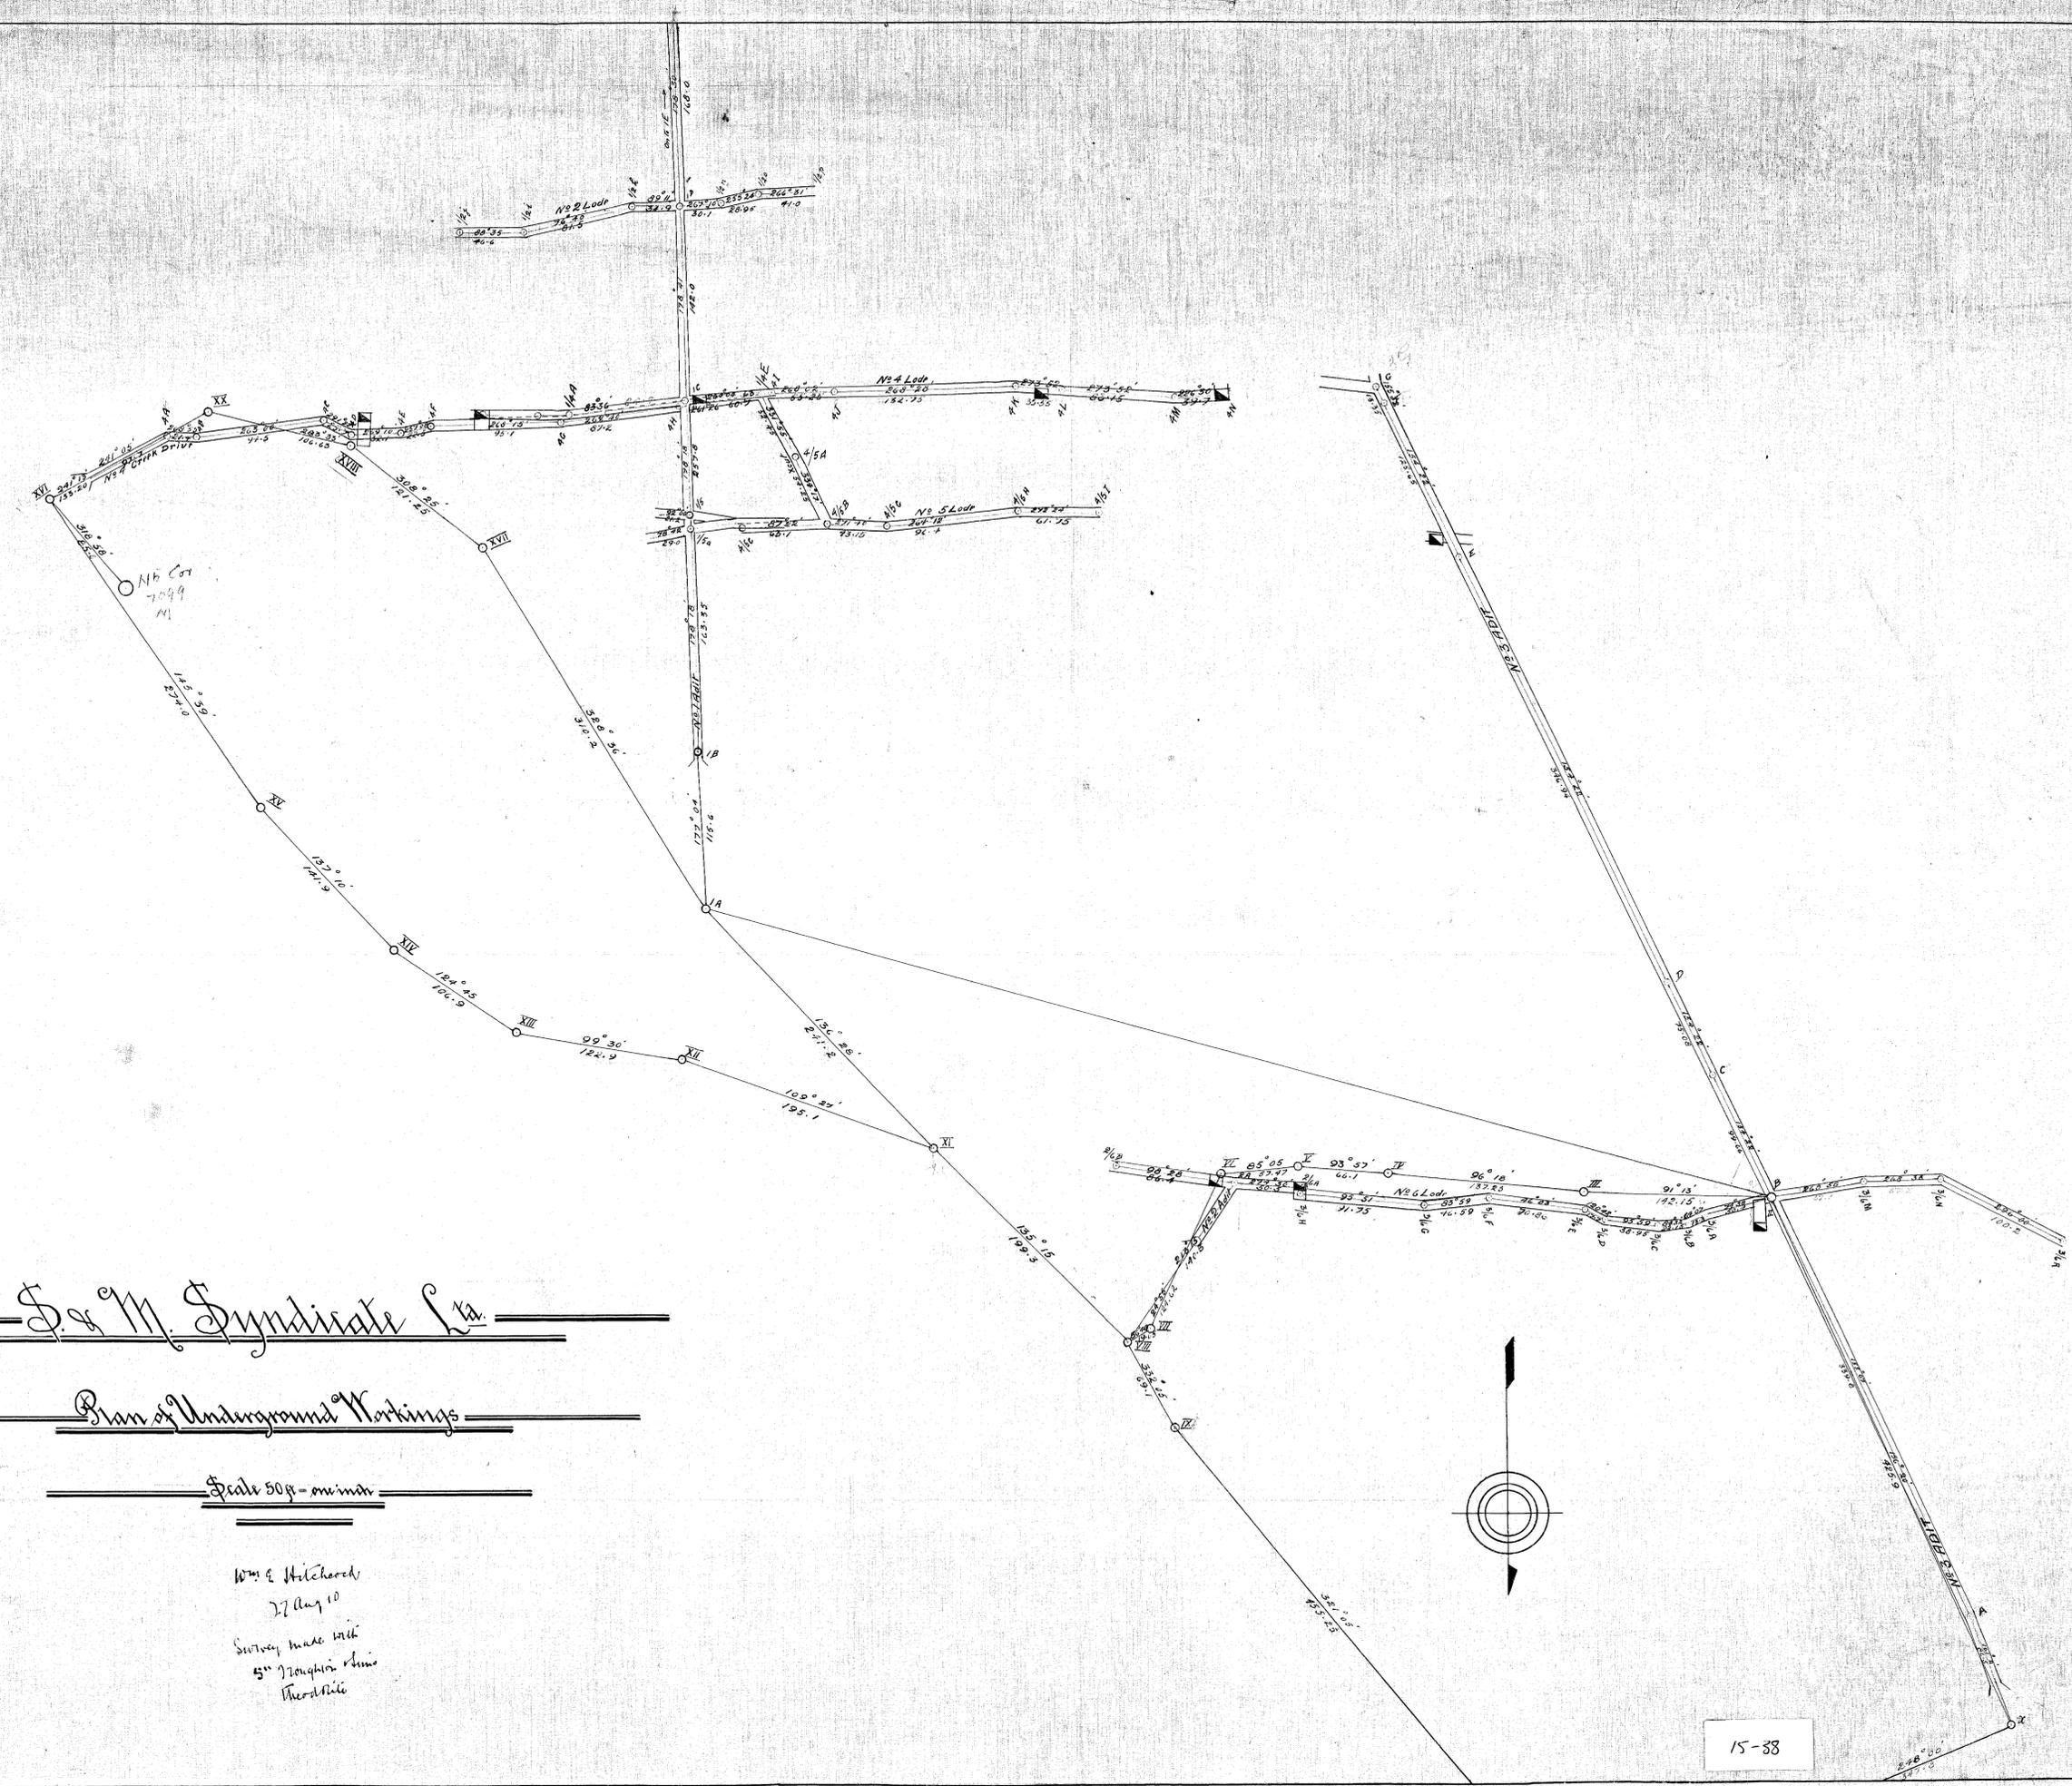


S. & M. Syndicate Ltd.

Plan of Underground Workings

Scale 50 ft = 1 inch

Wm. E. Hitchcock
27 Aug 10
Survey made with
5" Tongue & Anis
Theodolite

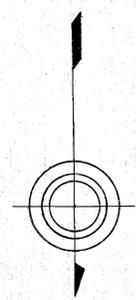

MINES INSPECTOR OF NEW
SPAIN 1910
LAUNCESTON

15-38