


15-40


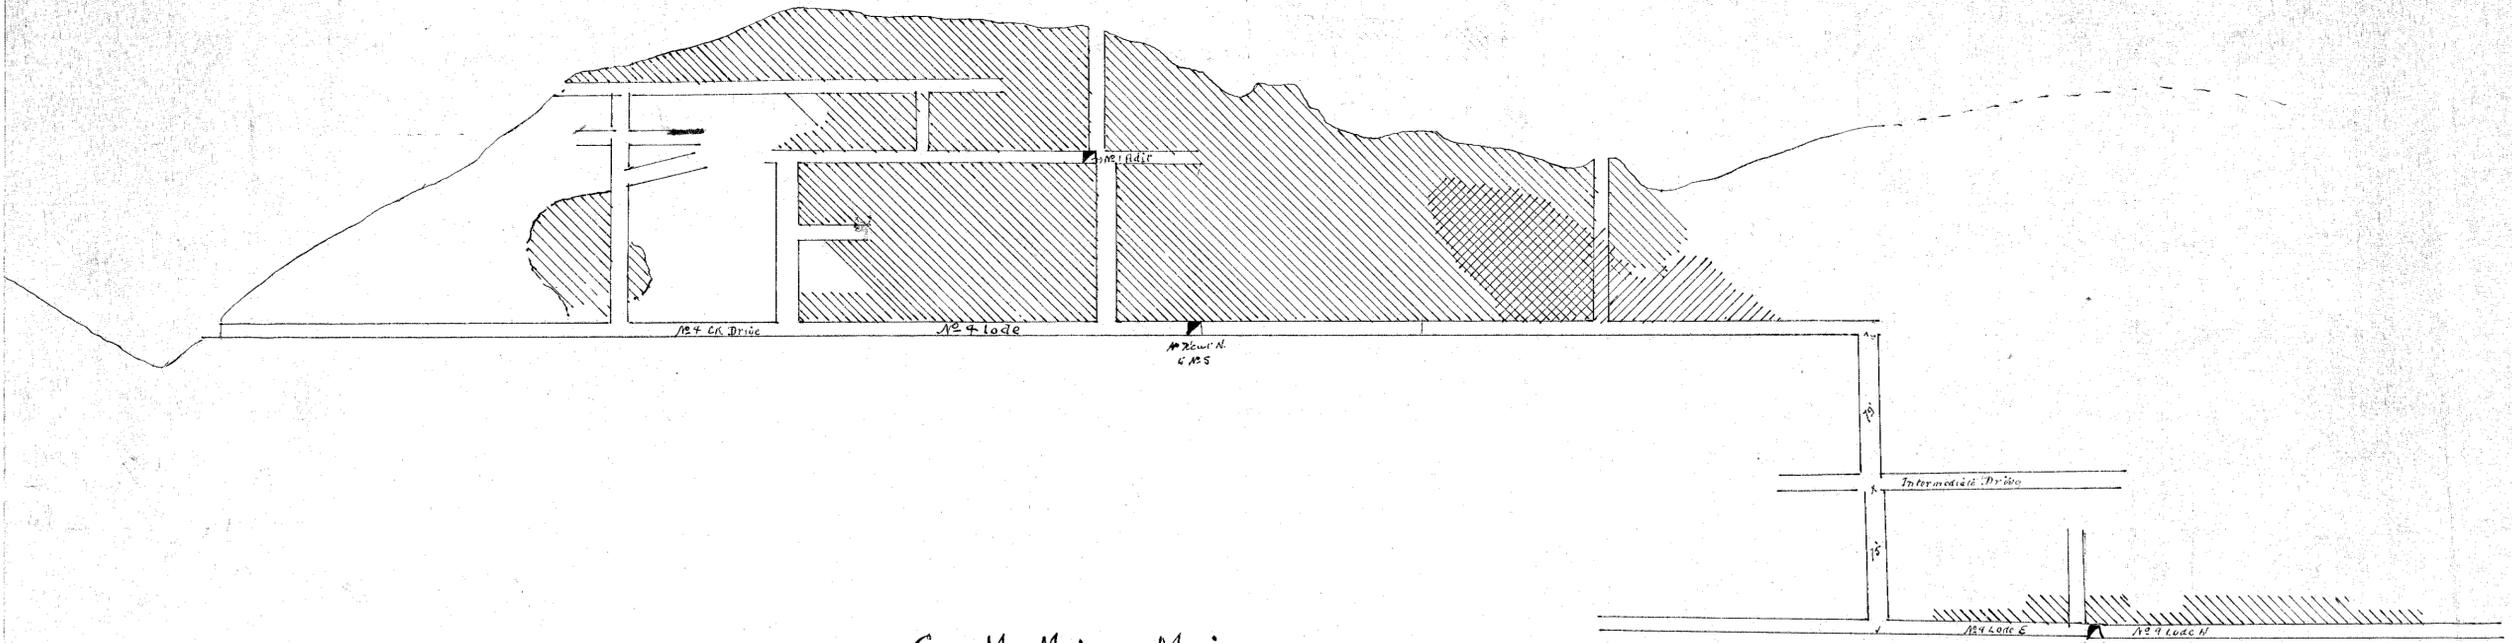


S & M Mine Moins
Sections on No 2, 4 & 6 Lodes
3. 8. 11

Stoped over Main Drives thus 

Stoped over Branch Drives - 

1" = 50'

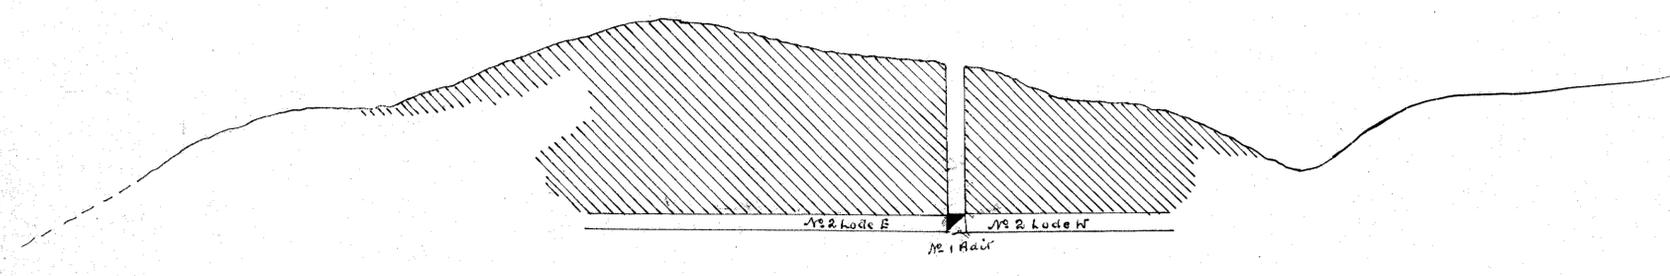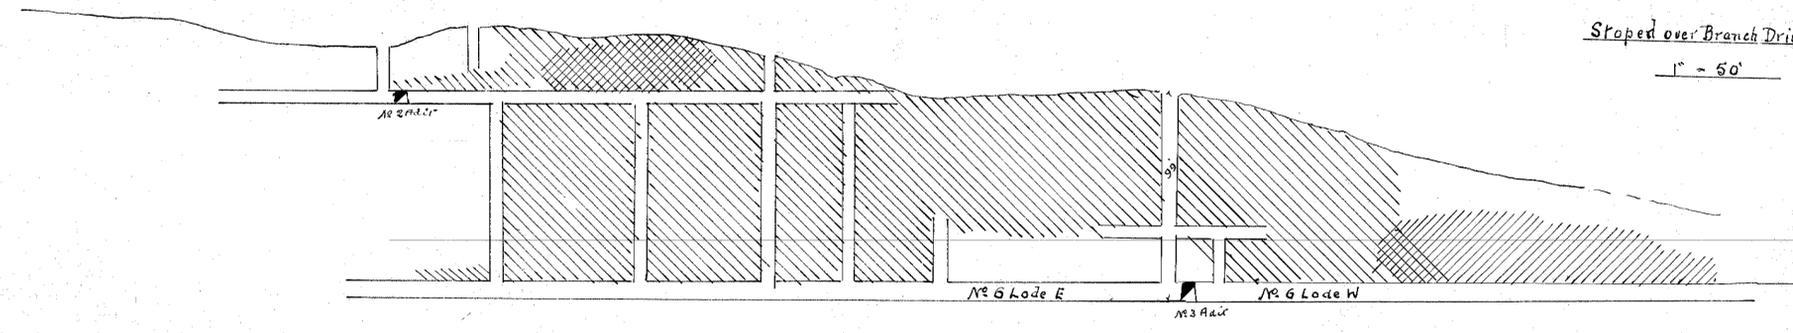

5 cm

15-40

No 3 Air



Wm. C. Hitchcock
 3 Aug 11

47