


S M Mine Middlesex

15-4392

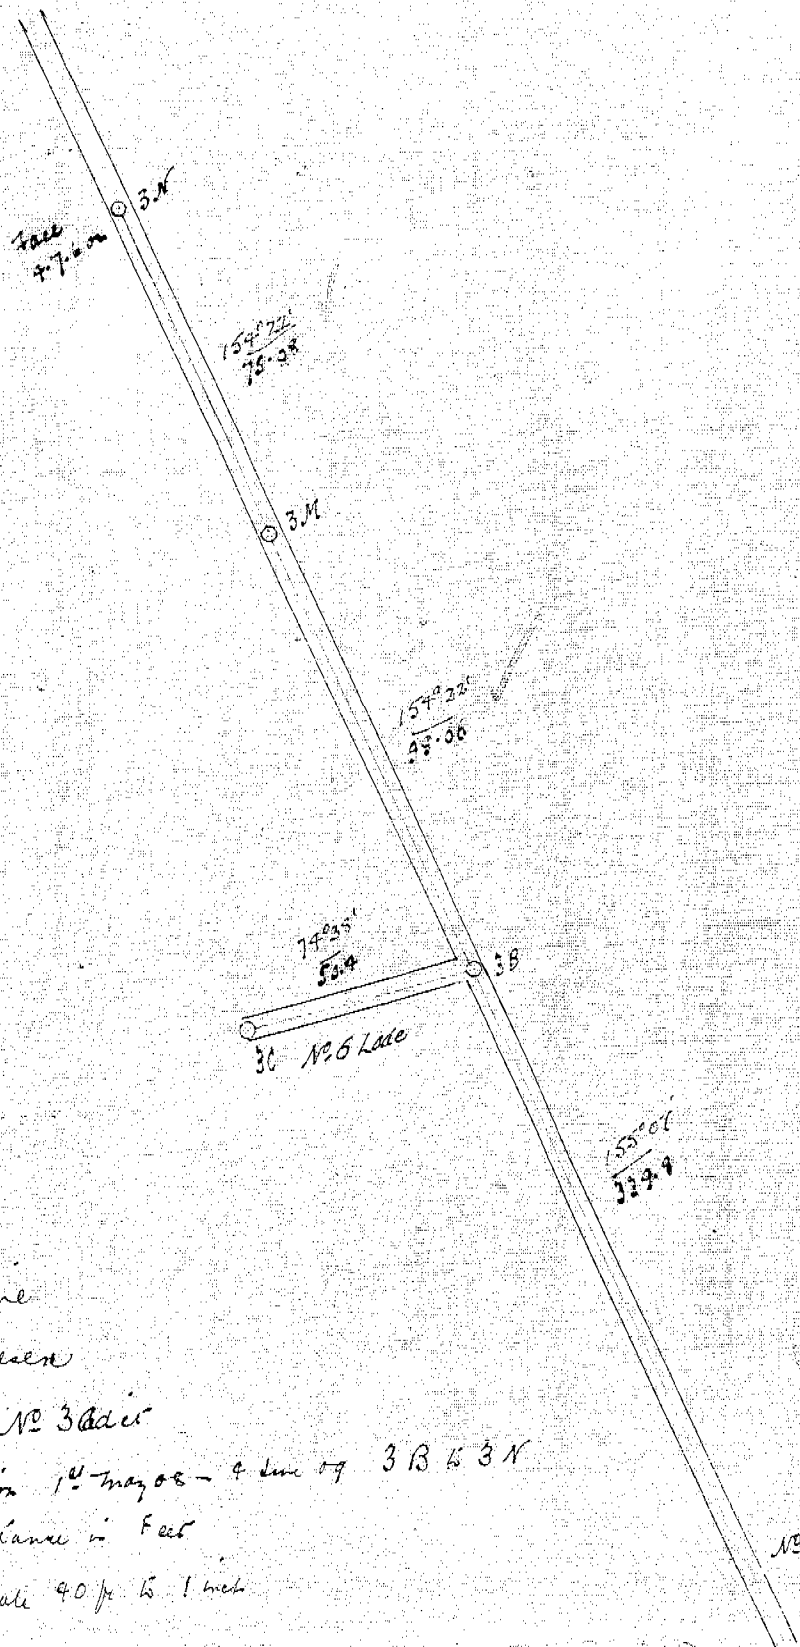

S M Mine
Middlesex

No 3 Adit

Extension 1st May 08 - 4 line of 3 B to 3 N
Distance in Feet

Scale 40 ft to 1 inch

Wm E. Hitchcock
7 June 09

No 3 Adit