
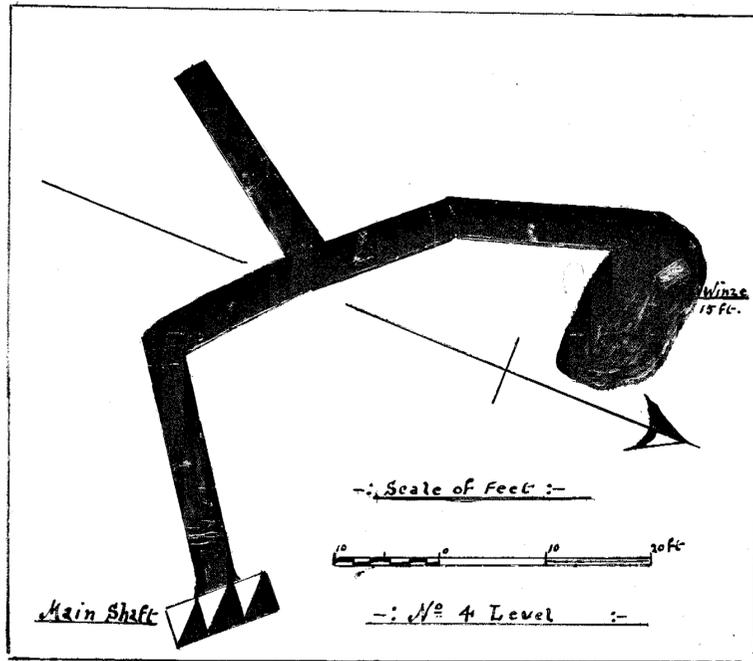


5 cm


Plan of Benlomond Tin Mine. Main Shaft & Open Cut :-

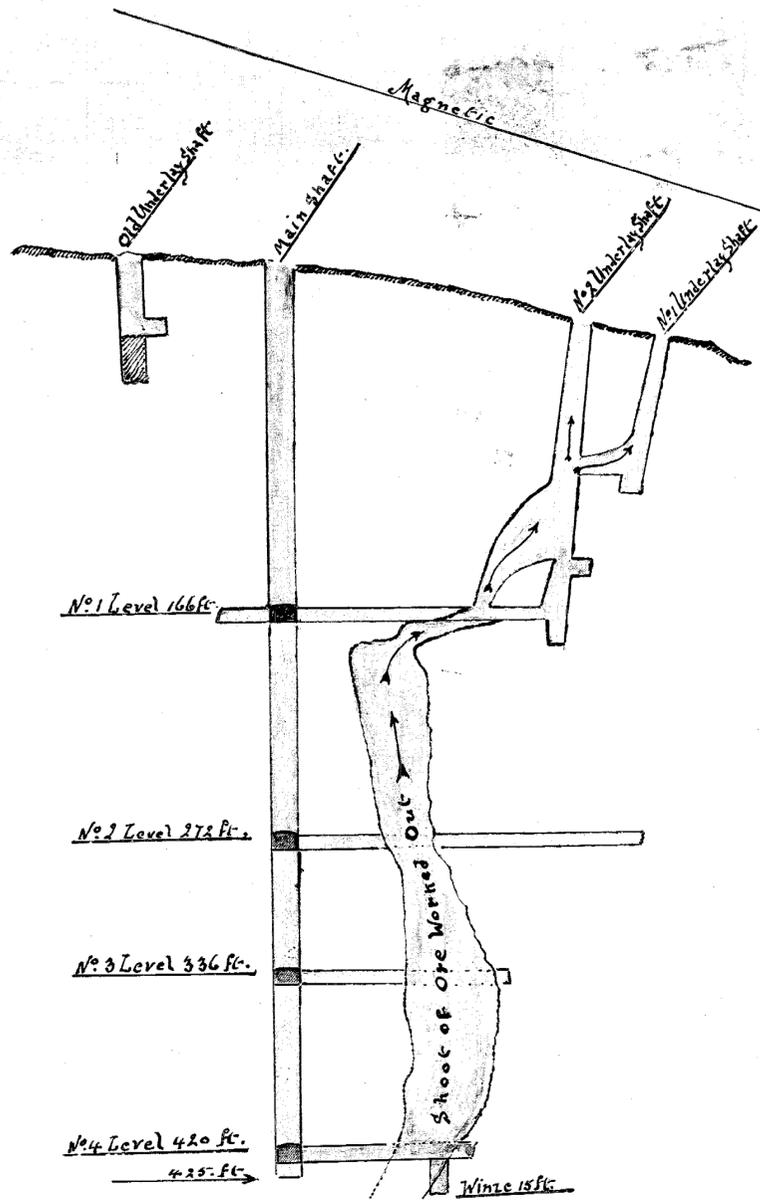

50 0 50 100 ft

Scale of Feet :-
Main Shaft :-

Thos. H. Bailey :-
Benlomond Tin Mine Co. N.Z.
July 3rd 1919

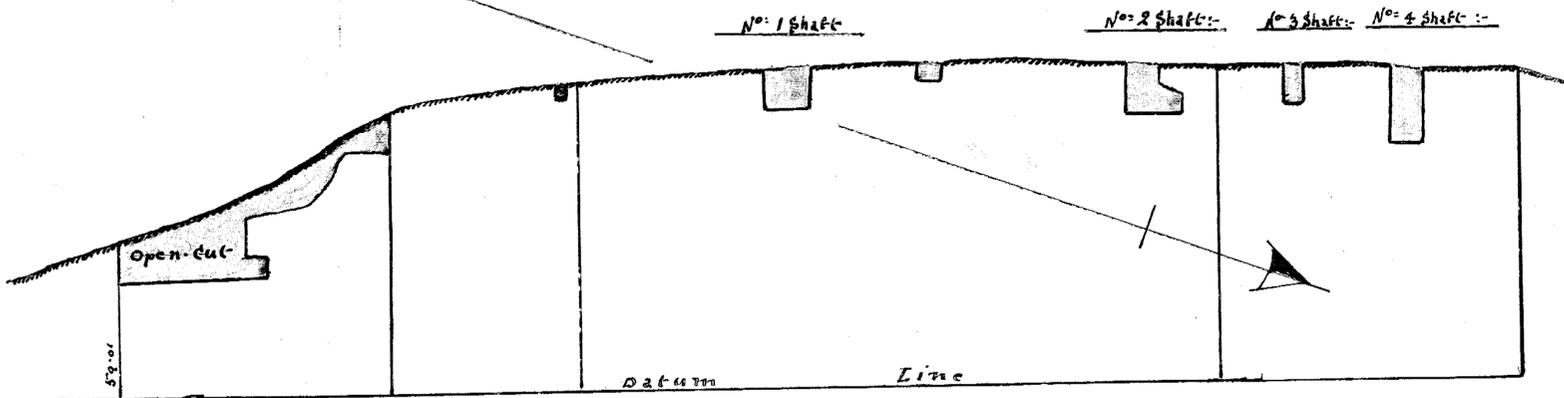

Sectional View of North Lode Open Cut :- Datum 50 feet :-

Vertical Scale 40 feet to 1 inch :-

Horizontal 1 Chain to 1 inch :-

Thos. H. Bailey July 9th 1919