



5 cm

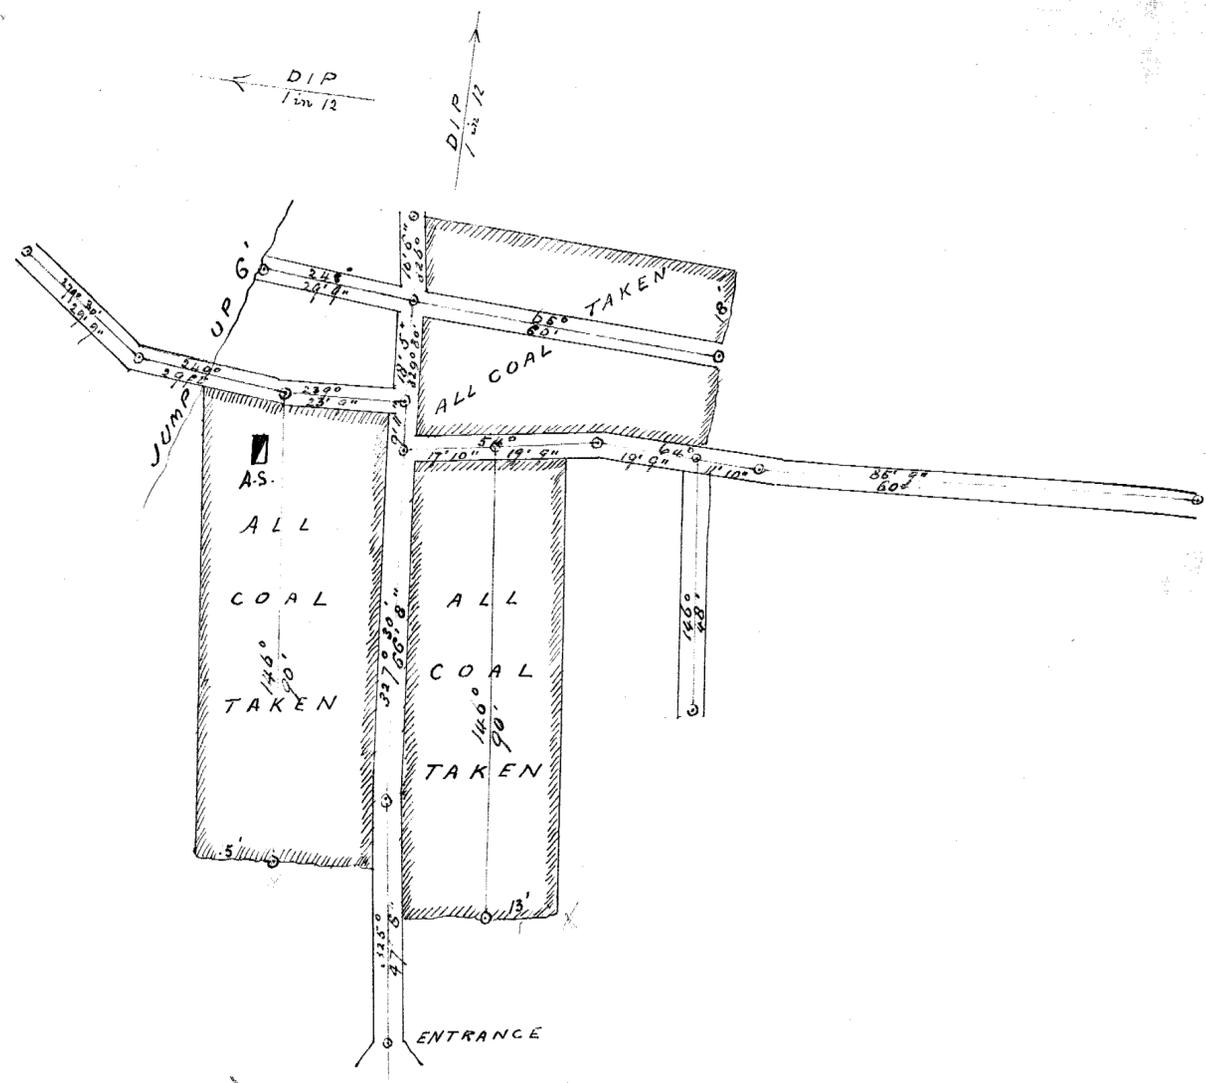

Teasdale's Colliery  
Dulverton  
1881

TEASDALE'S COLLIERY  
DULVERTON  
Scale 25ft. to 1 inch.

Certified correct copy  
of work done during  
year 1903  
R. W. Watson  
Government Surveyor.

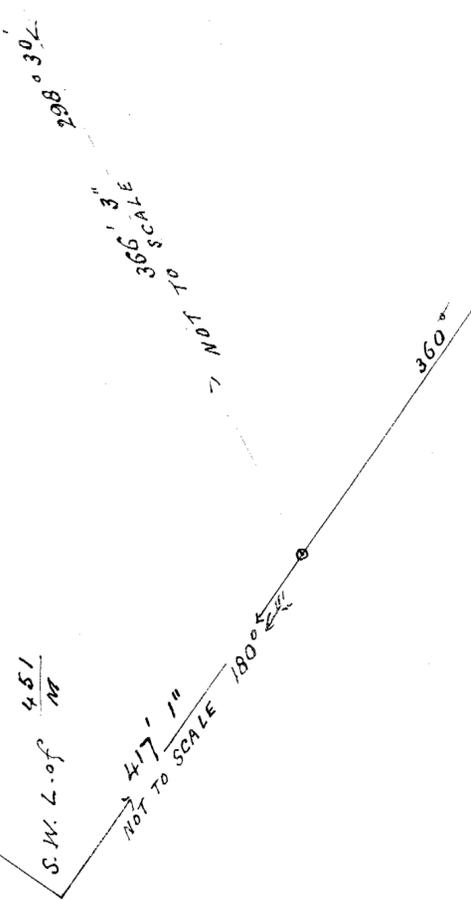

17-01

15