



DULVERTON COLLIERY

Scale 40 feet to 1 inch.

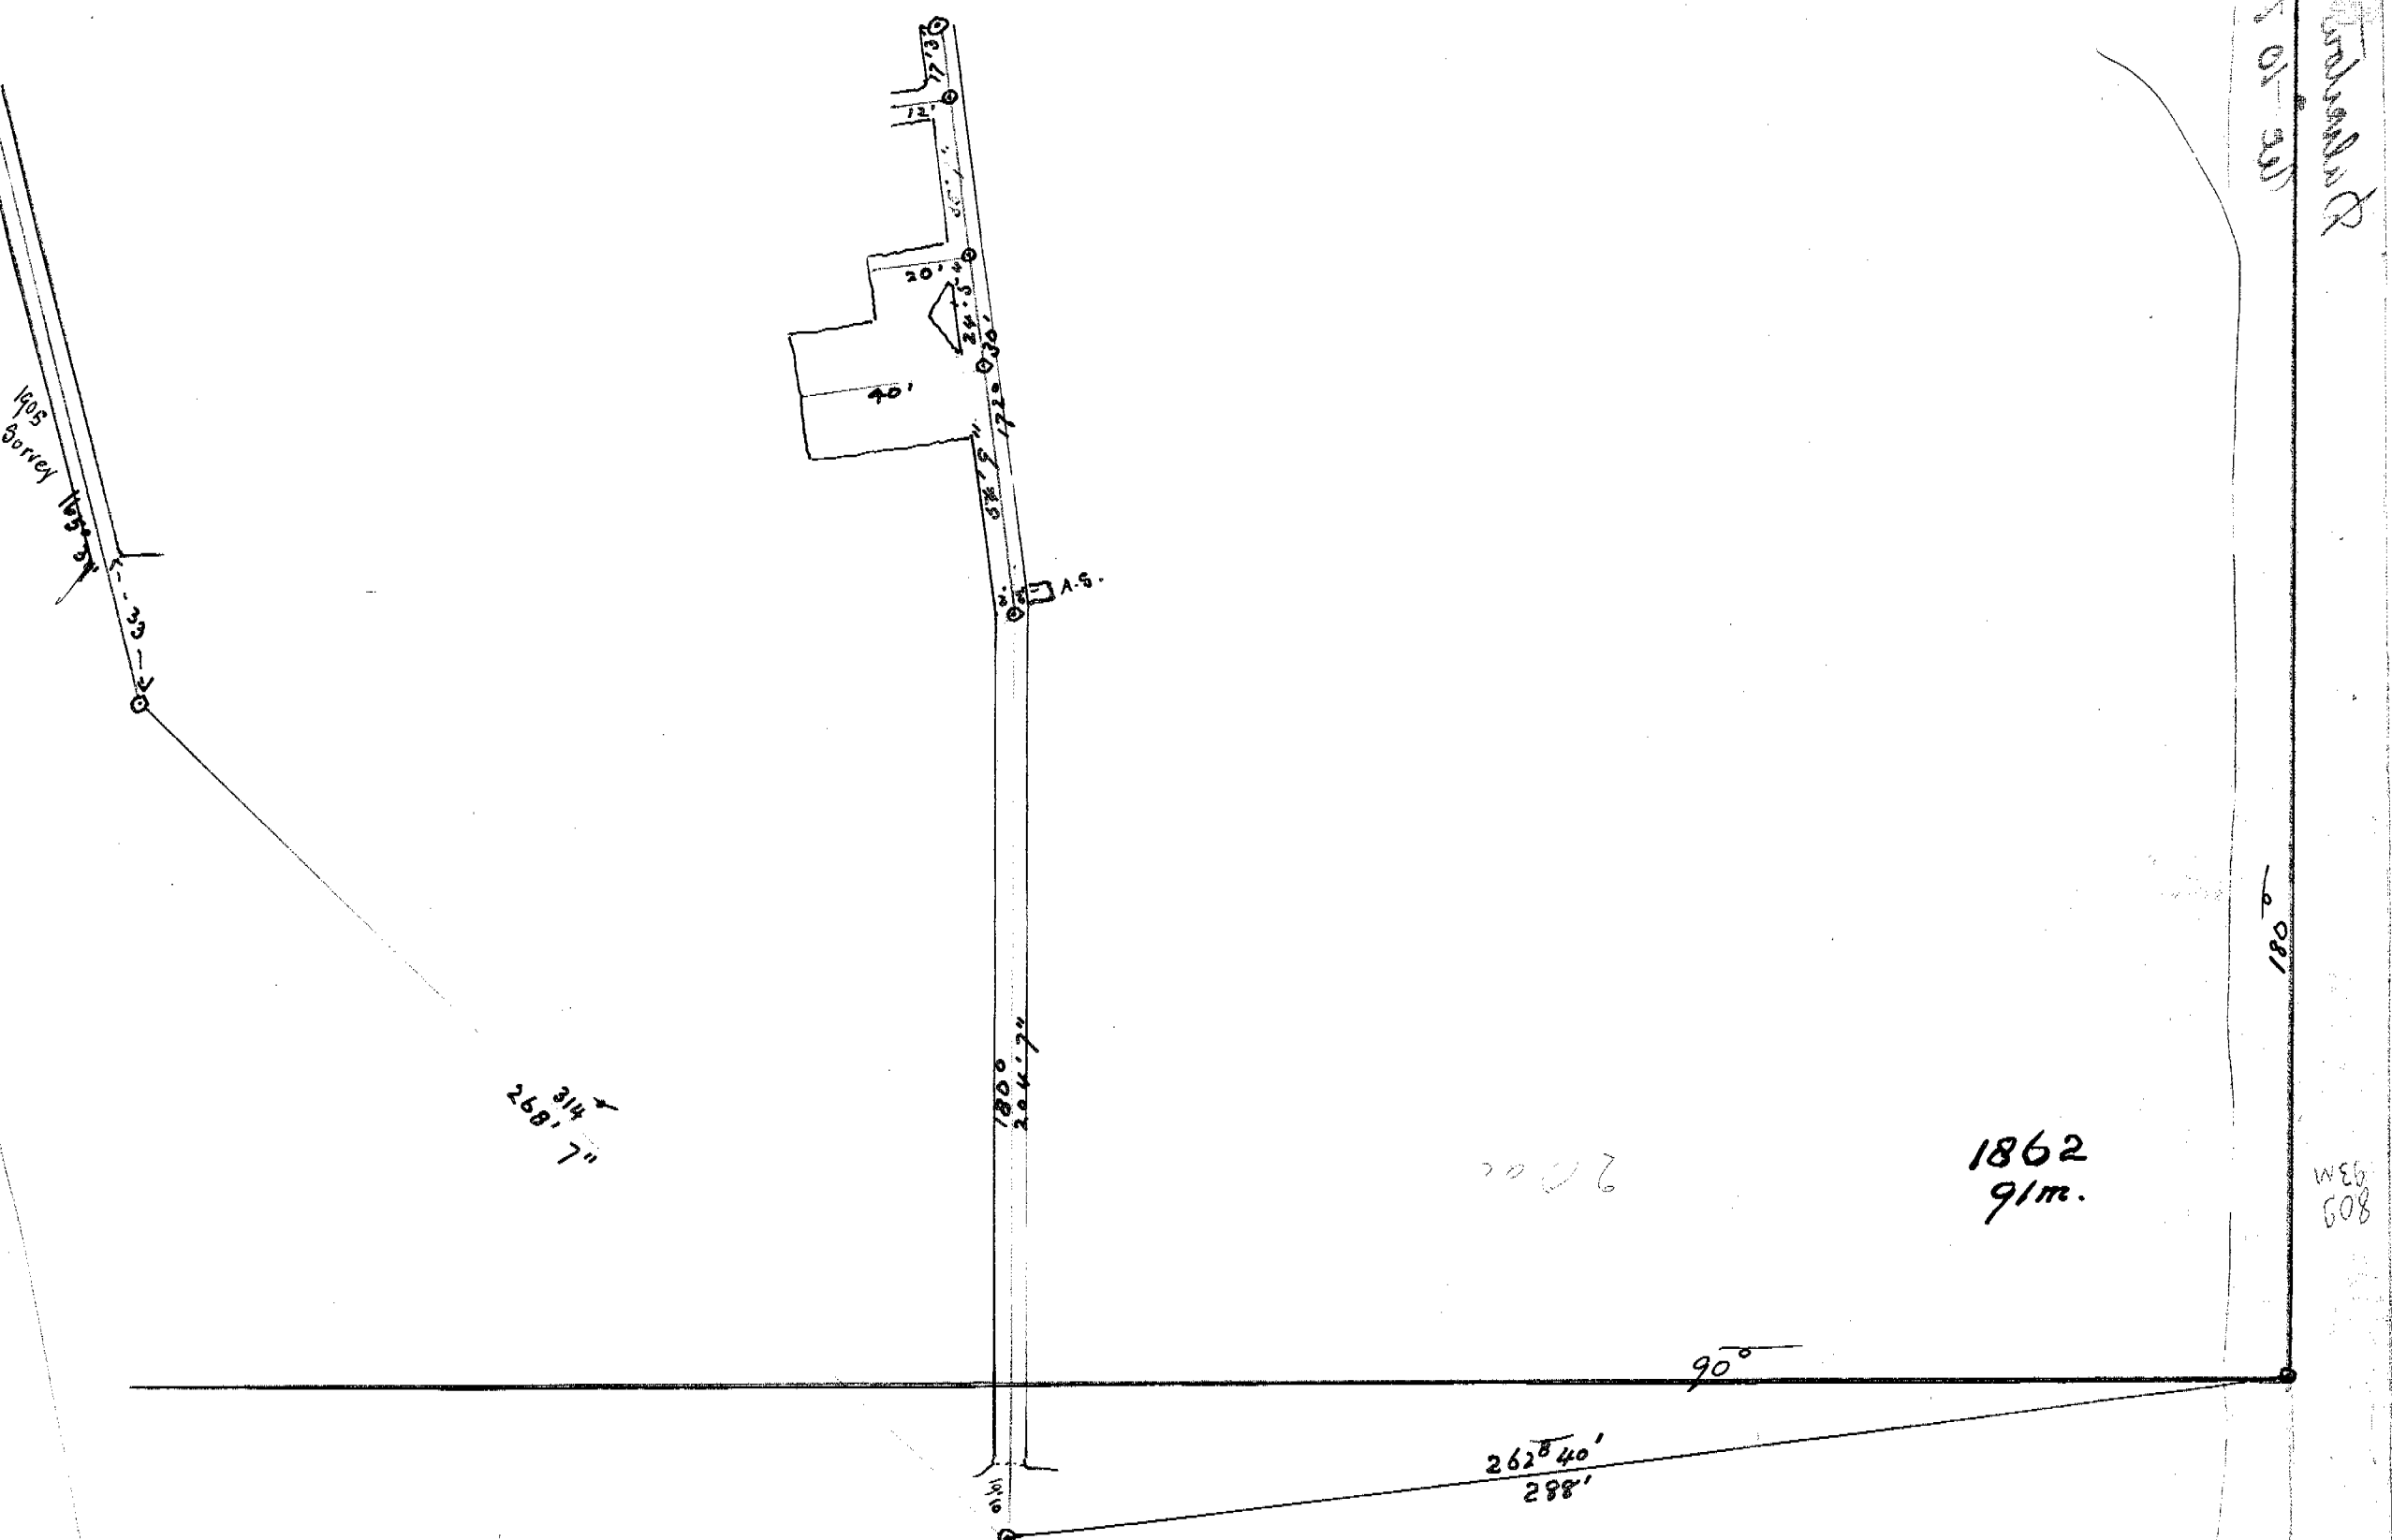

WL8
tbl1

17-02

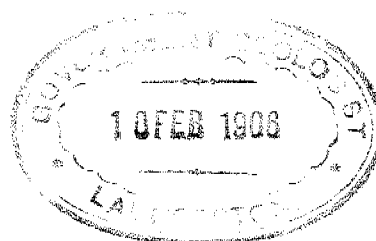

Survey with the Revolute
Certified correct copy of
Survey Feb 5. 06
C. Quincy Watson.
Capt. Sumner