


5 cm

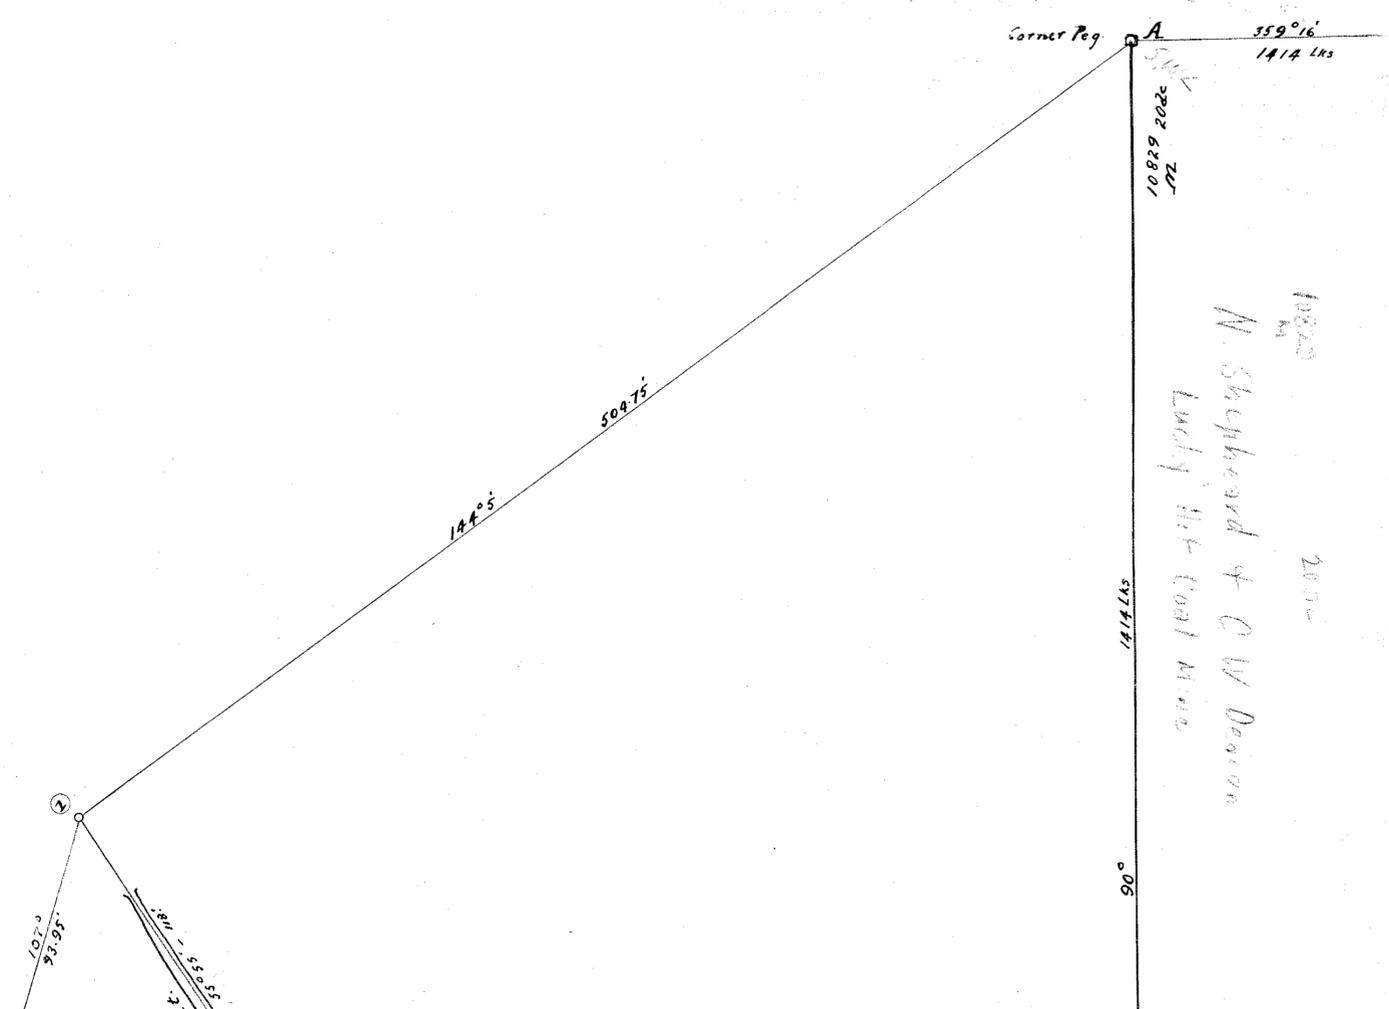

1882
 N. Shephard & C W Deacon
 Lucky Hill Coal Mine
 2002


THE LAST CHANCE COAL MINE
 NEW-BED.- RAILTON-DULVERTON.
 COUNTY DEVON.

Scale 40' to 1."



5" Transit & 4" Compass used.

Usual dip of coal N.W.

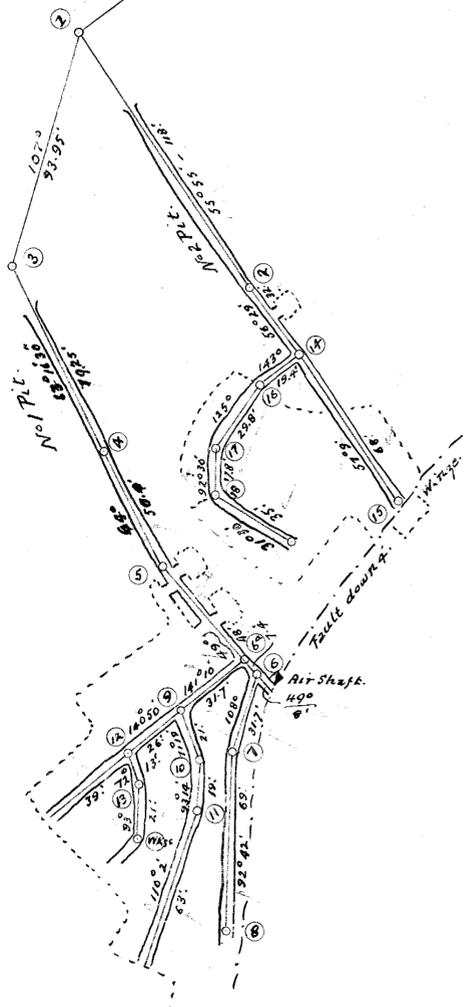

Very old workings.