

5 cm

# PREOLENNA COAL MINE

SECTION 5964 240 AC A. L. M. GRAUE.  
M

MAIN TUNNEL DRIVEN 321 FEET 6 IN.

to date 22. 6. 14

H. E. WINDOR.

Mining Surveyor

June 1914.

Scale 1 ch. to an inch

No 5964 210 ac  
M

A. L. M. Graue.

No 6636 5 ac  
M

Machinery Site

B. Shop. Hut

Iron Rail Transvers


265° 49'

502

56.7


55°

347.5

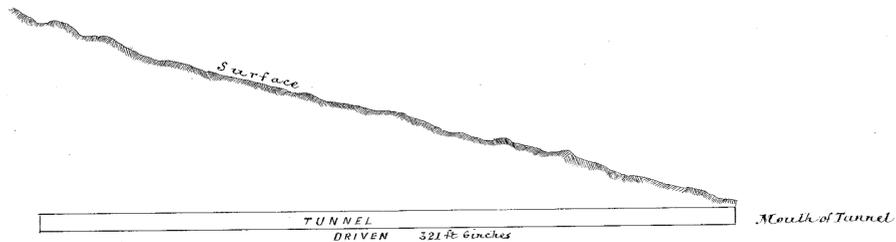


SECTION

Scale 40 ft to an Inch

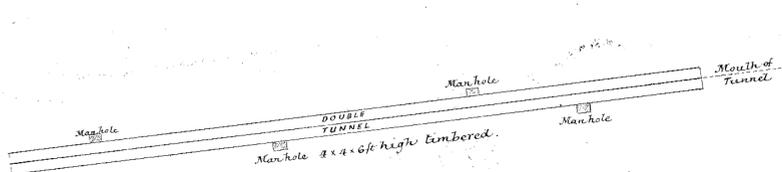

PLAN

Scale 40 ft to an Inch

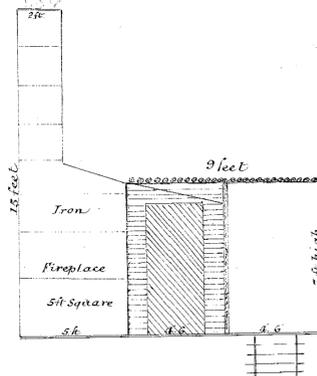

Section of Tunnel

8-489

19-01