


PREOLENNA COAL MINING CO.Y

Tunnel and Surface contour Survey, giving height approximately from surface to bottom of tunnel

at every 100 ft. (given in ft.) Tunnel 7 ft high, 9 ft wide and 556 ft long

Scale 2chs to 1inch. 100ft. 152 links. Tunnel No 2. Situated at 8 Mile

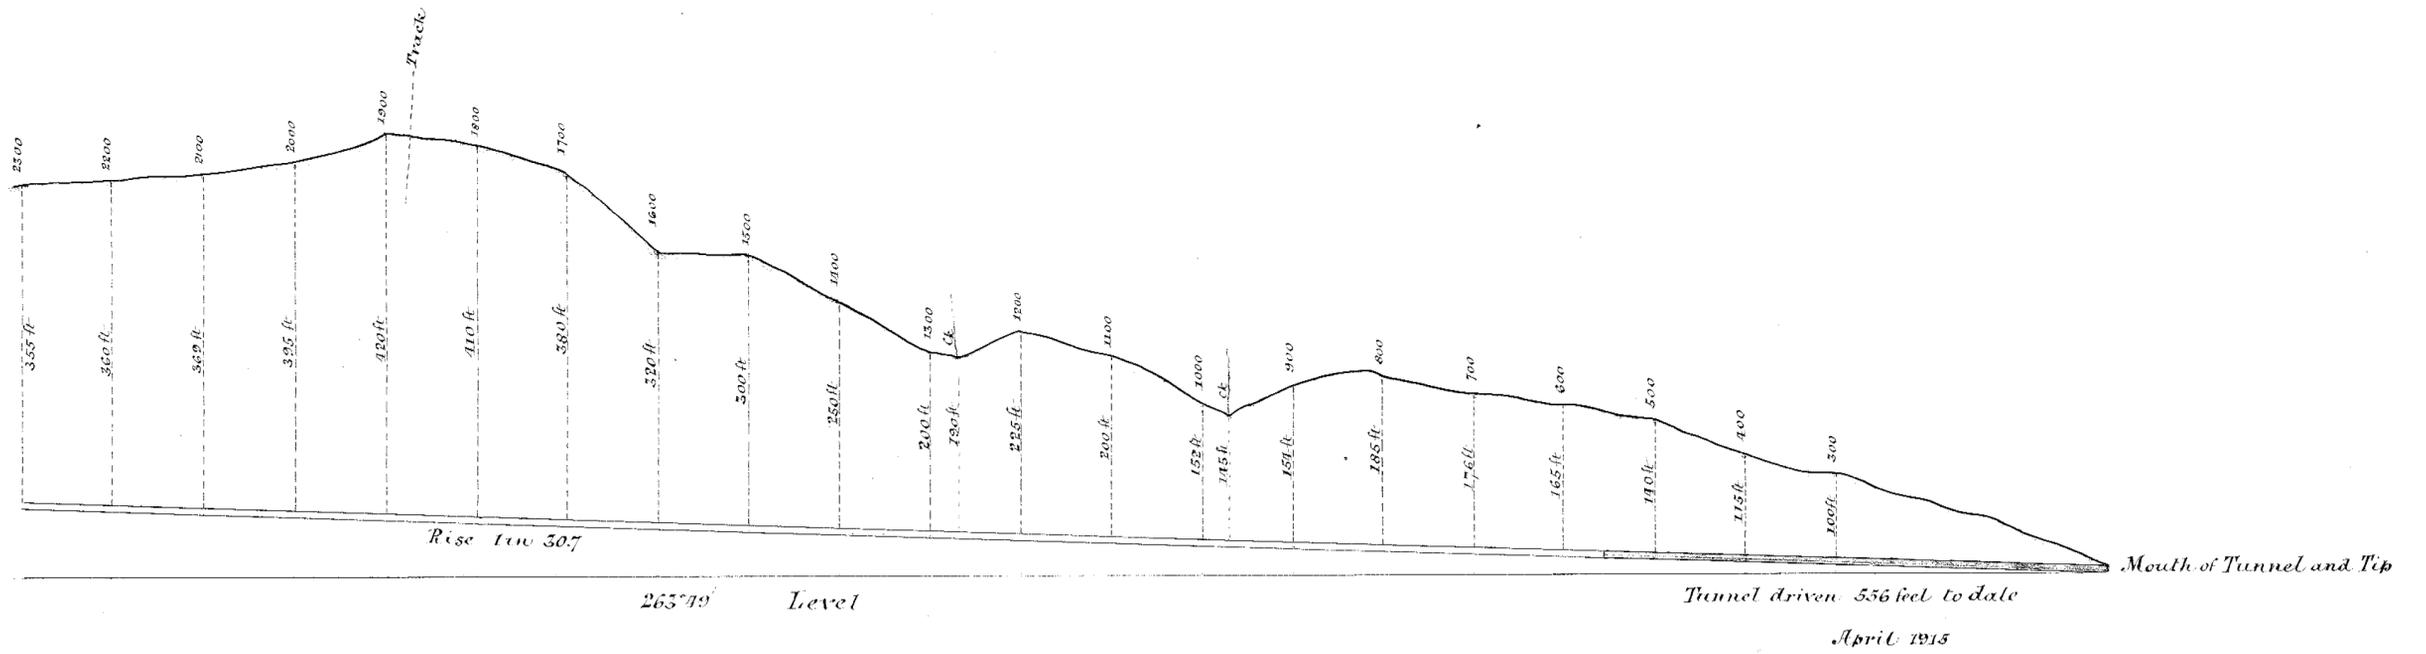

*Thos. E. Windsor.
 Surveyor.
 April 1915.*