


5 cm

PREOLENNA COAL MINE.

SCALE 40 FT. = 1 INCH.

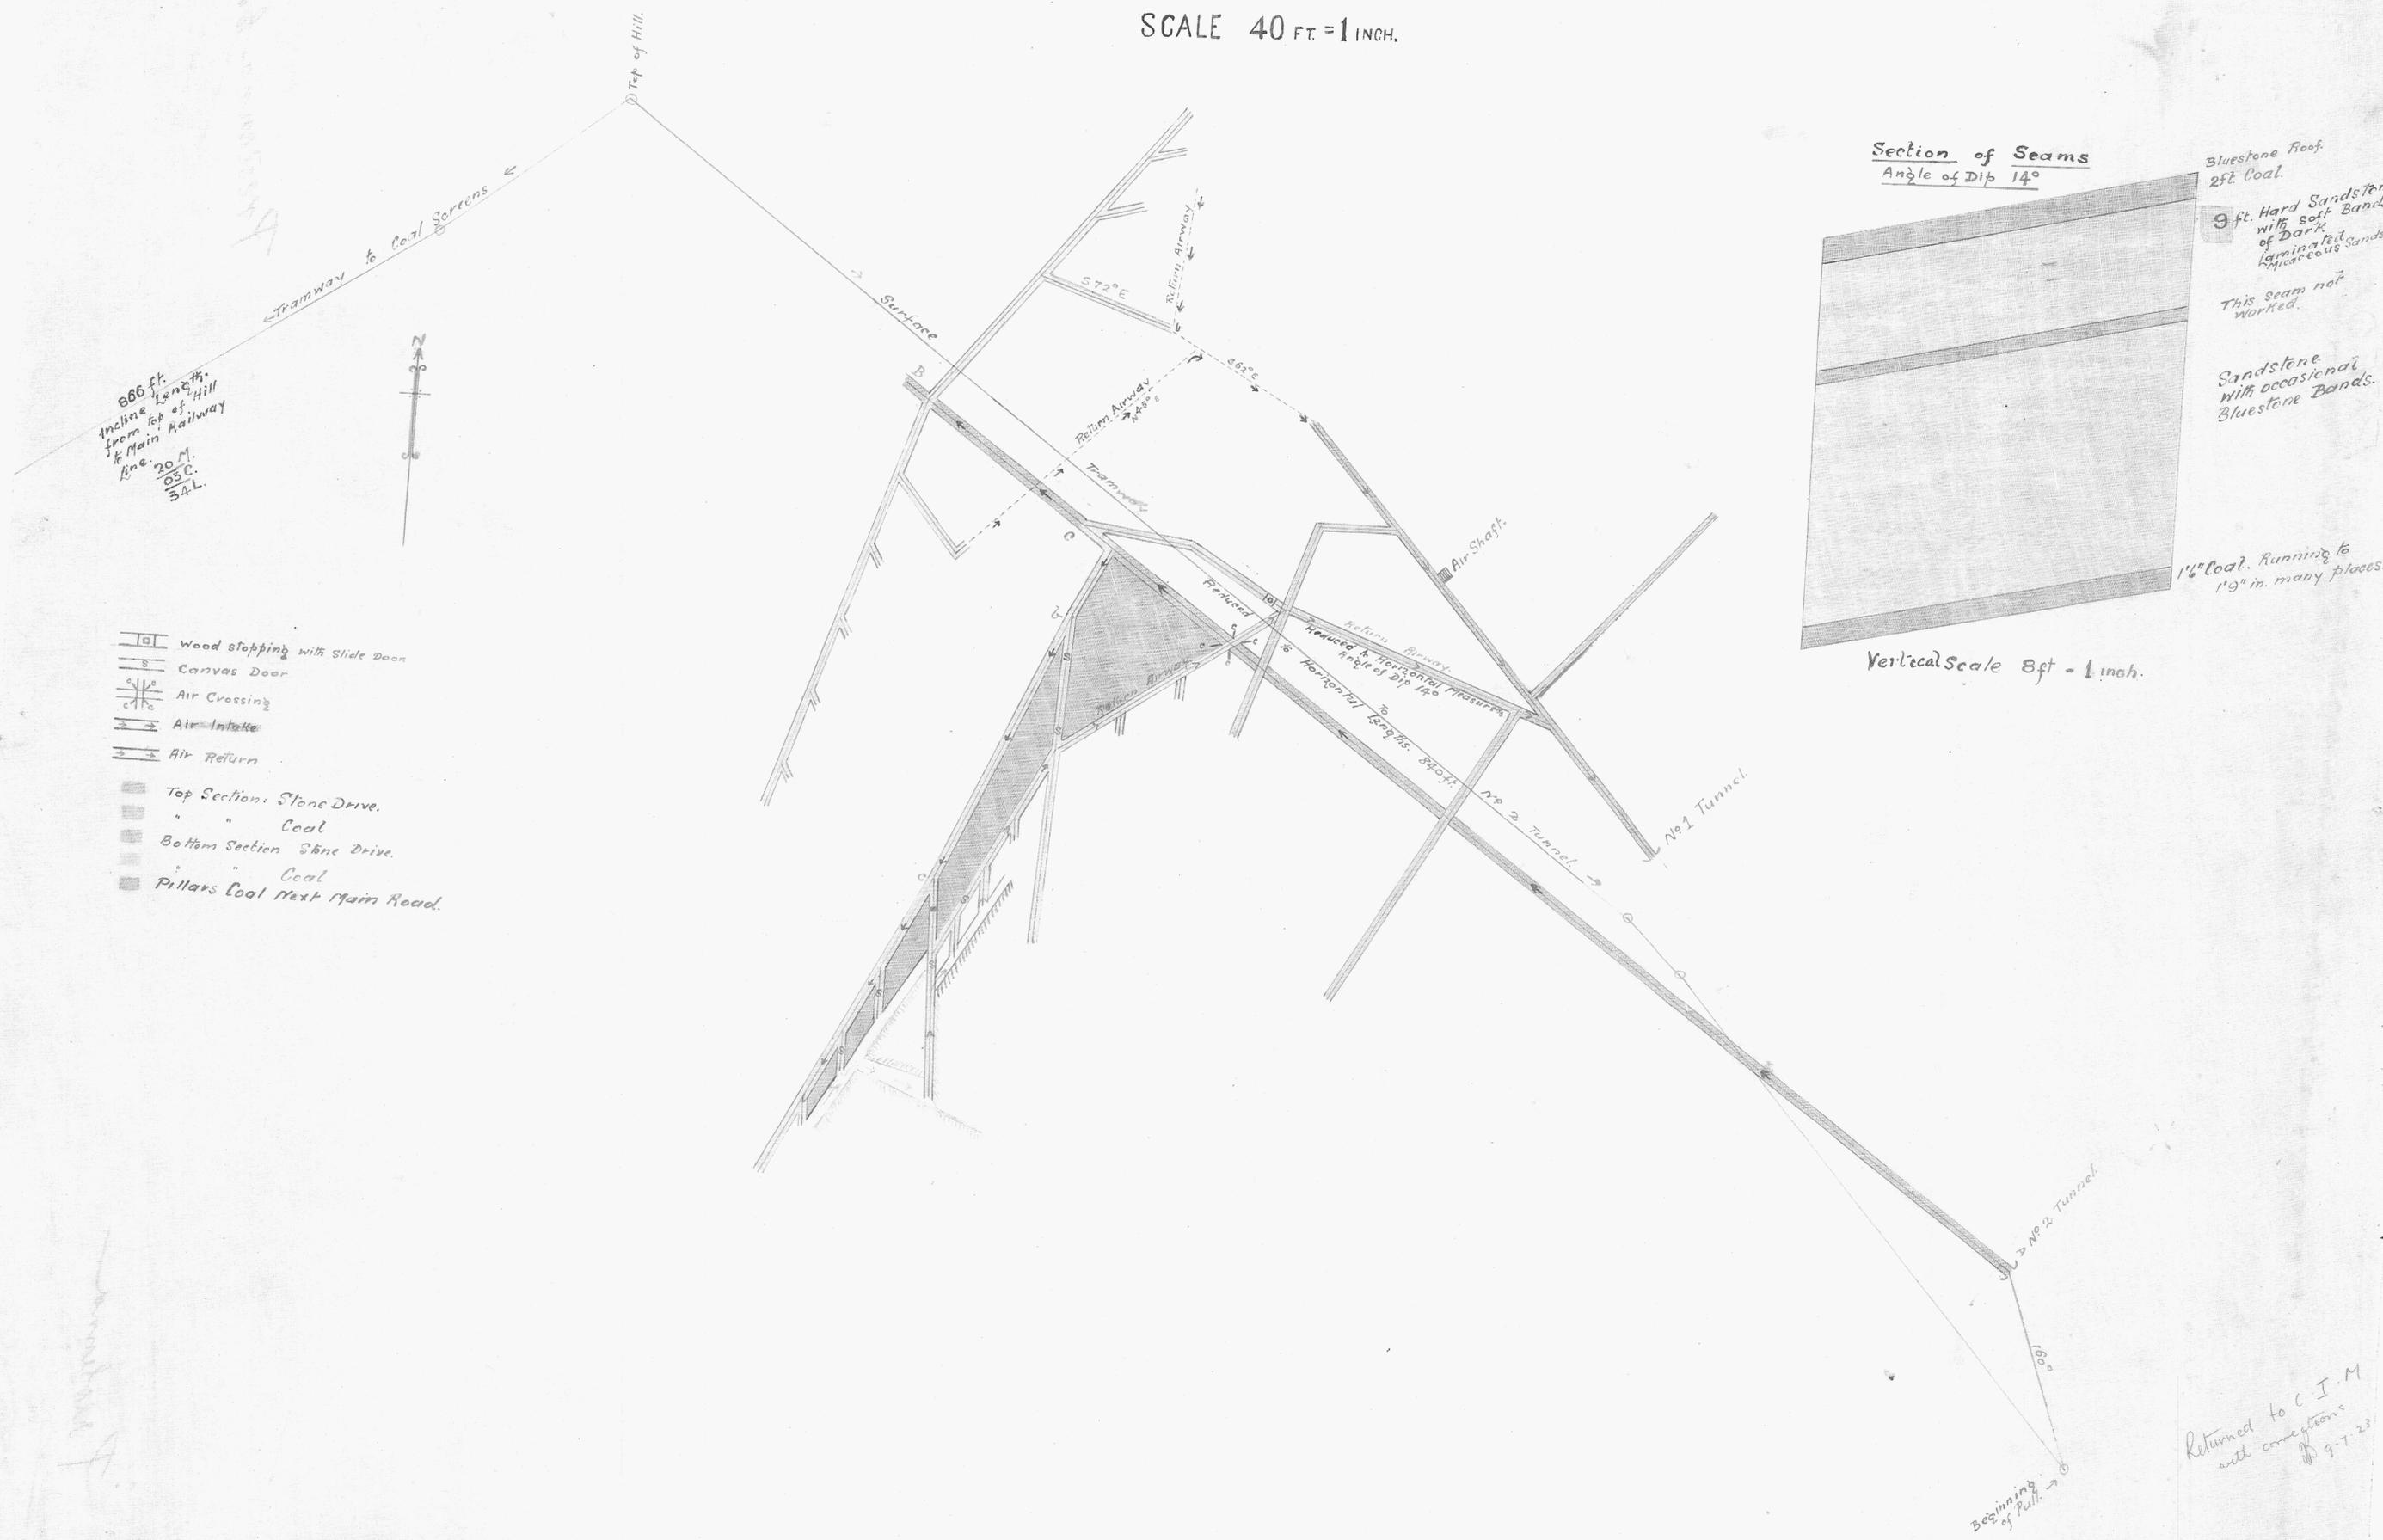


686 ft. length
 Incline top of Hill
 to Main Railway
 line. 20 M.
 05 C.
 3 A.L.



- Wood stopping with slide door
- Canvas door
- Air crossing
- Air intake
- Air return
- Top Section: Stone Drive.
- Coal
- Bottom Section: Stone Drive.
- Coal
- Pillars Coal Next Main Road.

Section of Seams
 Angle of Dip 14°

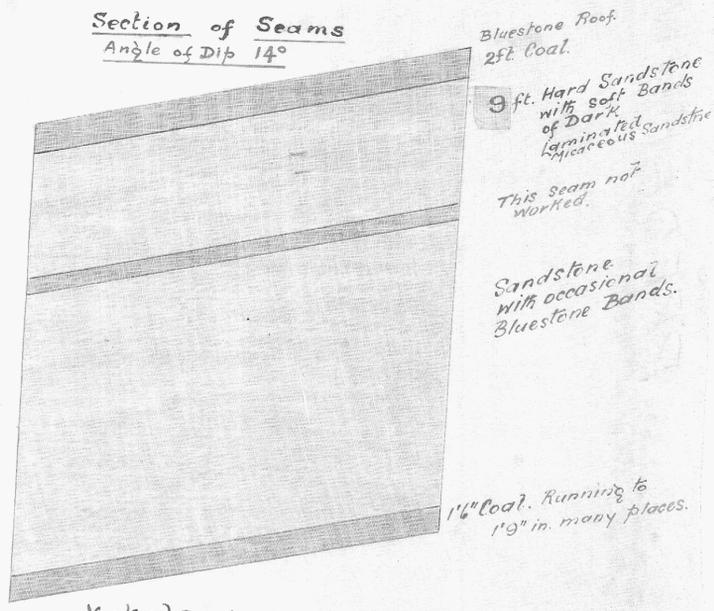

Vertical Scale 8ft = 1 inch.

Beginning of Pull. →

Returned to C.I.M.
 with corrections
 9.7.23

19-05

The Bottoms
 Mine Manager
 16.6.23