





PREOLENNA COAL AND SHALE MINING CO.

Survey of Tramway Reserve & Underground Workings

Survey commenced 1. 4. 12.
" finished 2. 4. 12.

Math. E. Windsor
Mining Surveyor
May 1912.

21-01

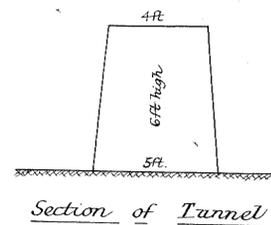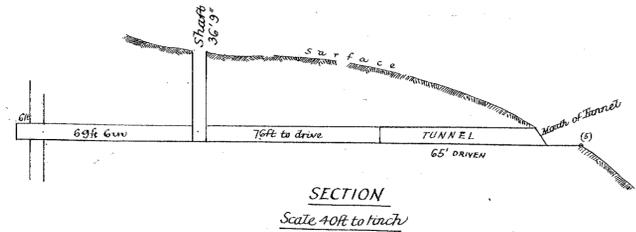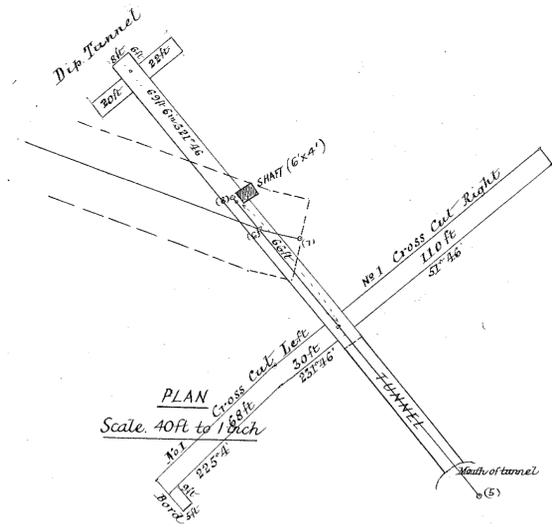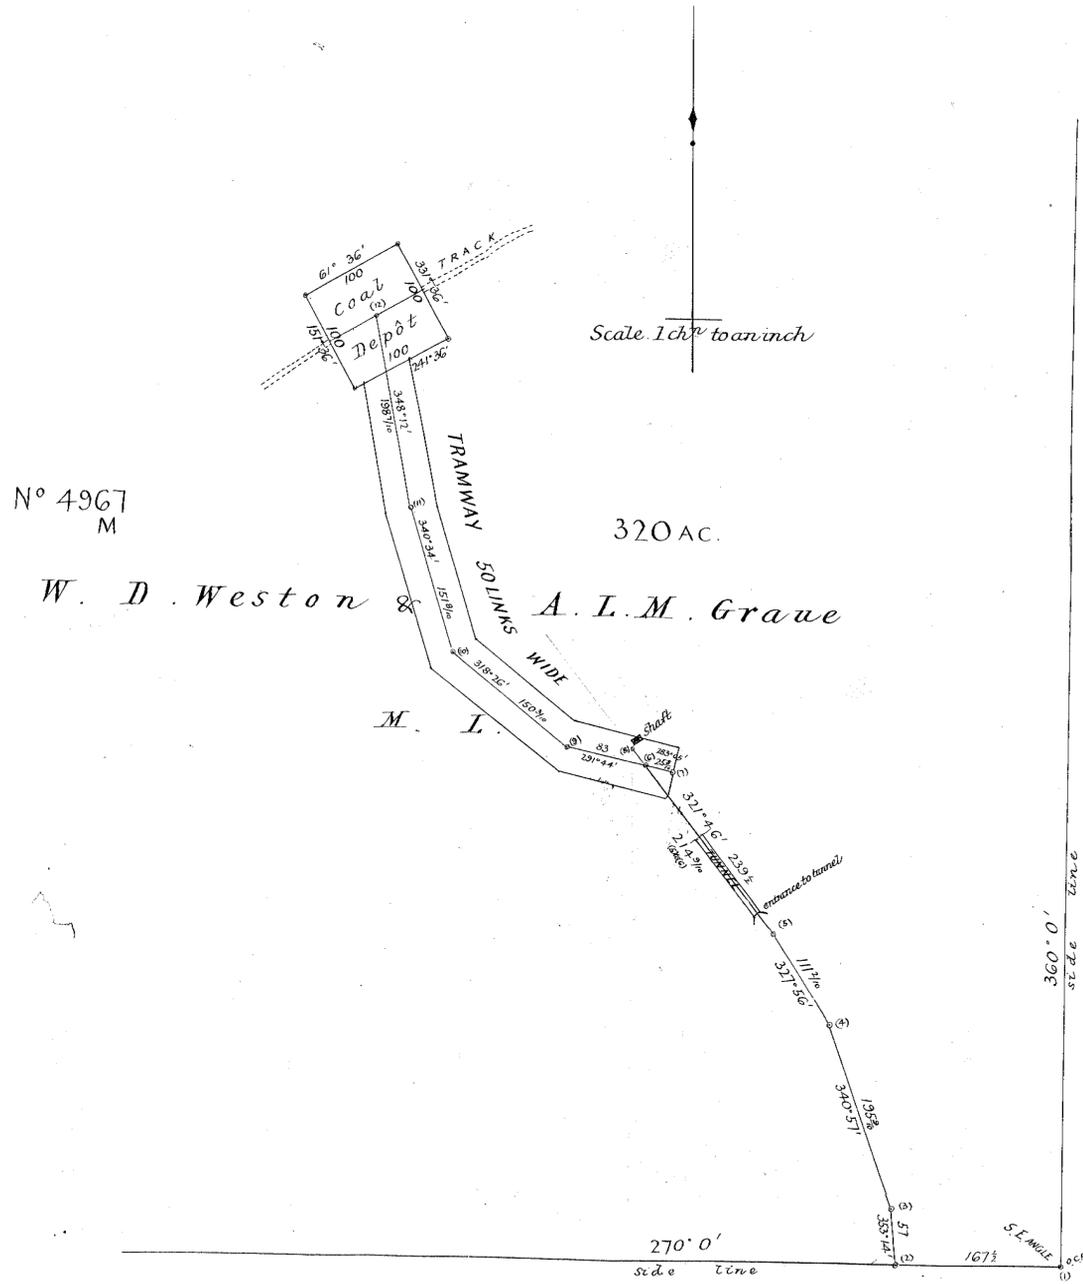

5 cm