


— THE NORTH TASMANIAN COPPER COMPANY N.L. —

— Longitudinal Section —

— Scale 40' to 1 inch —
— Along average line of Lode - bearing = 370.6 —

George Barker
24. 7. 1911

— TAS. COPPER COMPANY LIMITED —

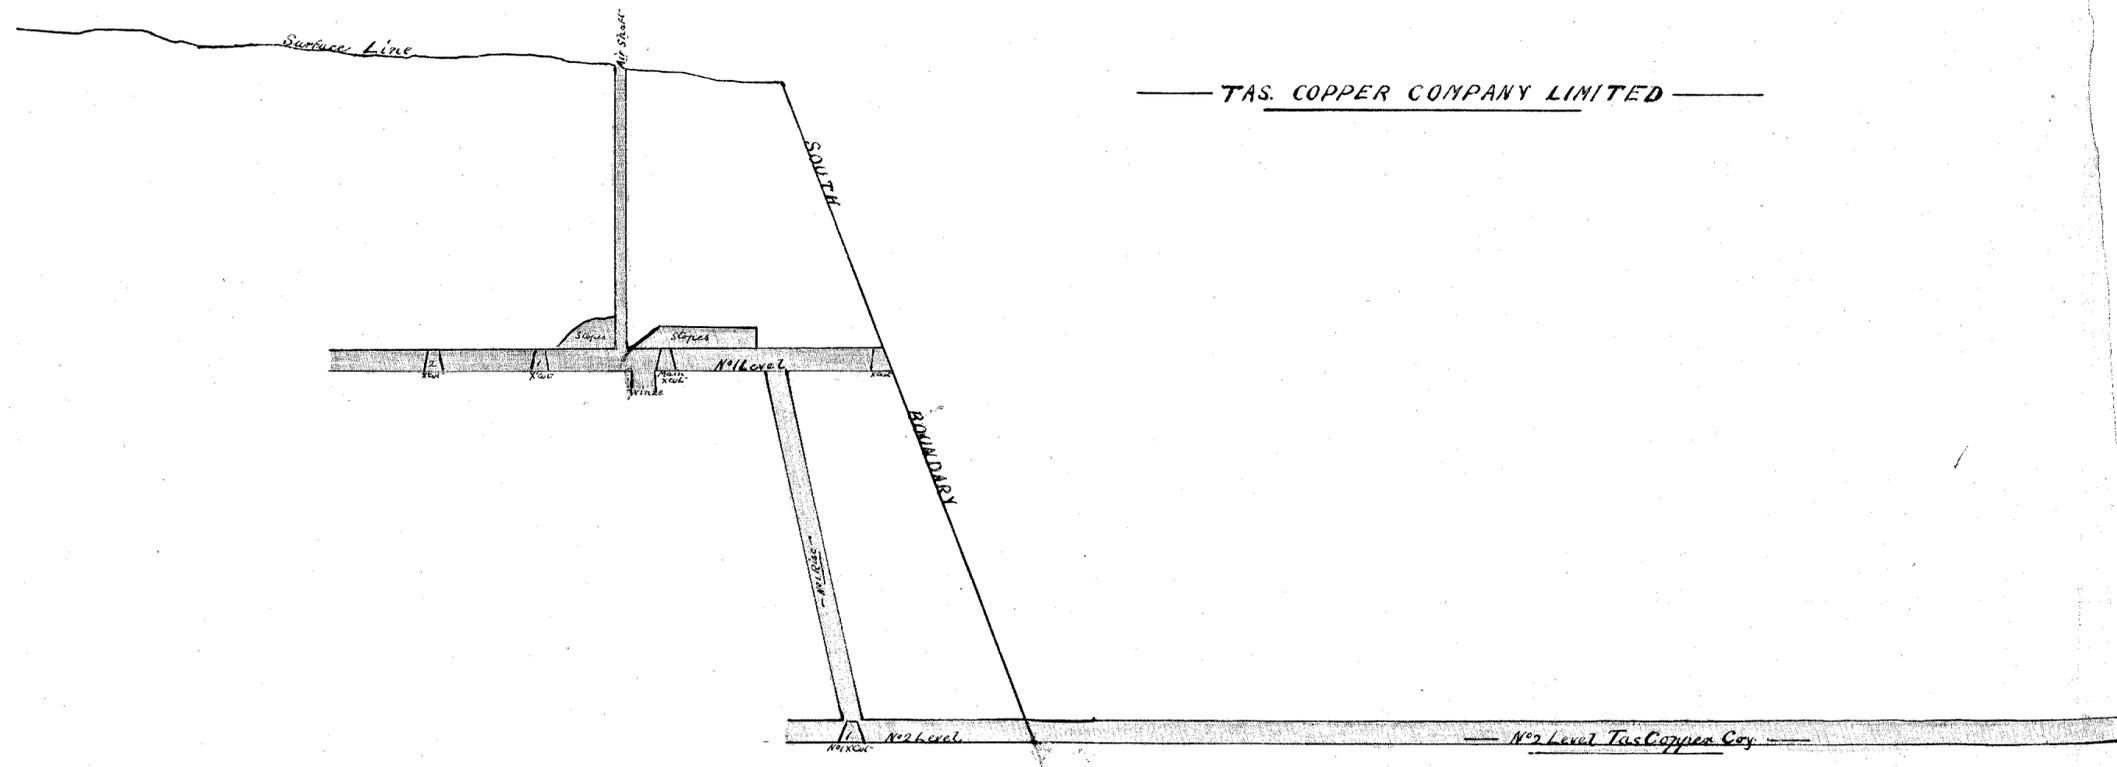

5 cm

184

22-02