



ABERFOYLE TIN N.L.

PLAN OF ALL LEVELS.

SCALE 30' = 1".

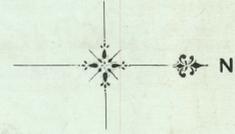

Handwritten note: 27/1/16

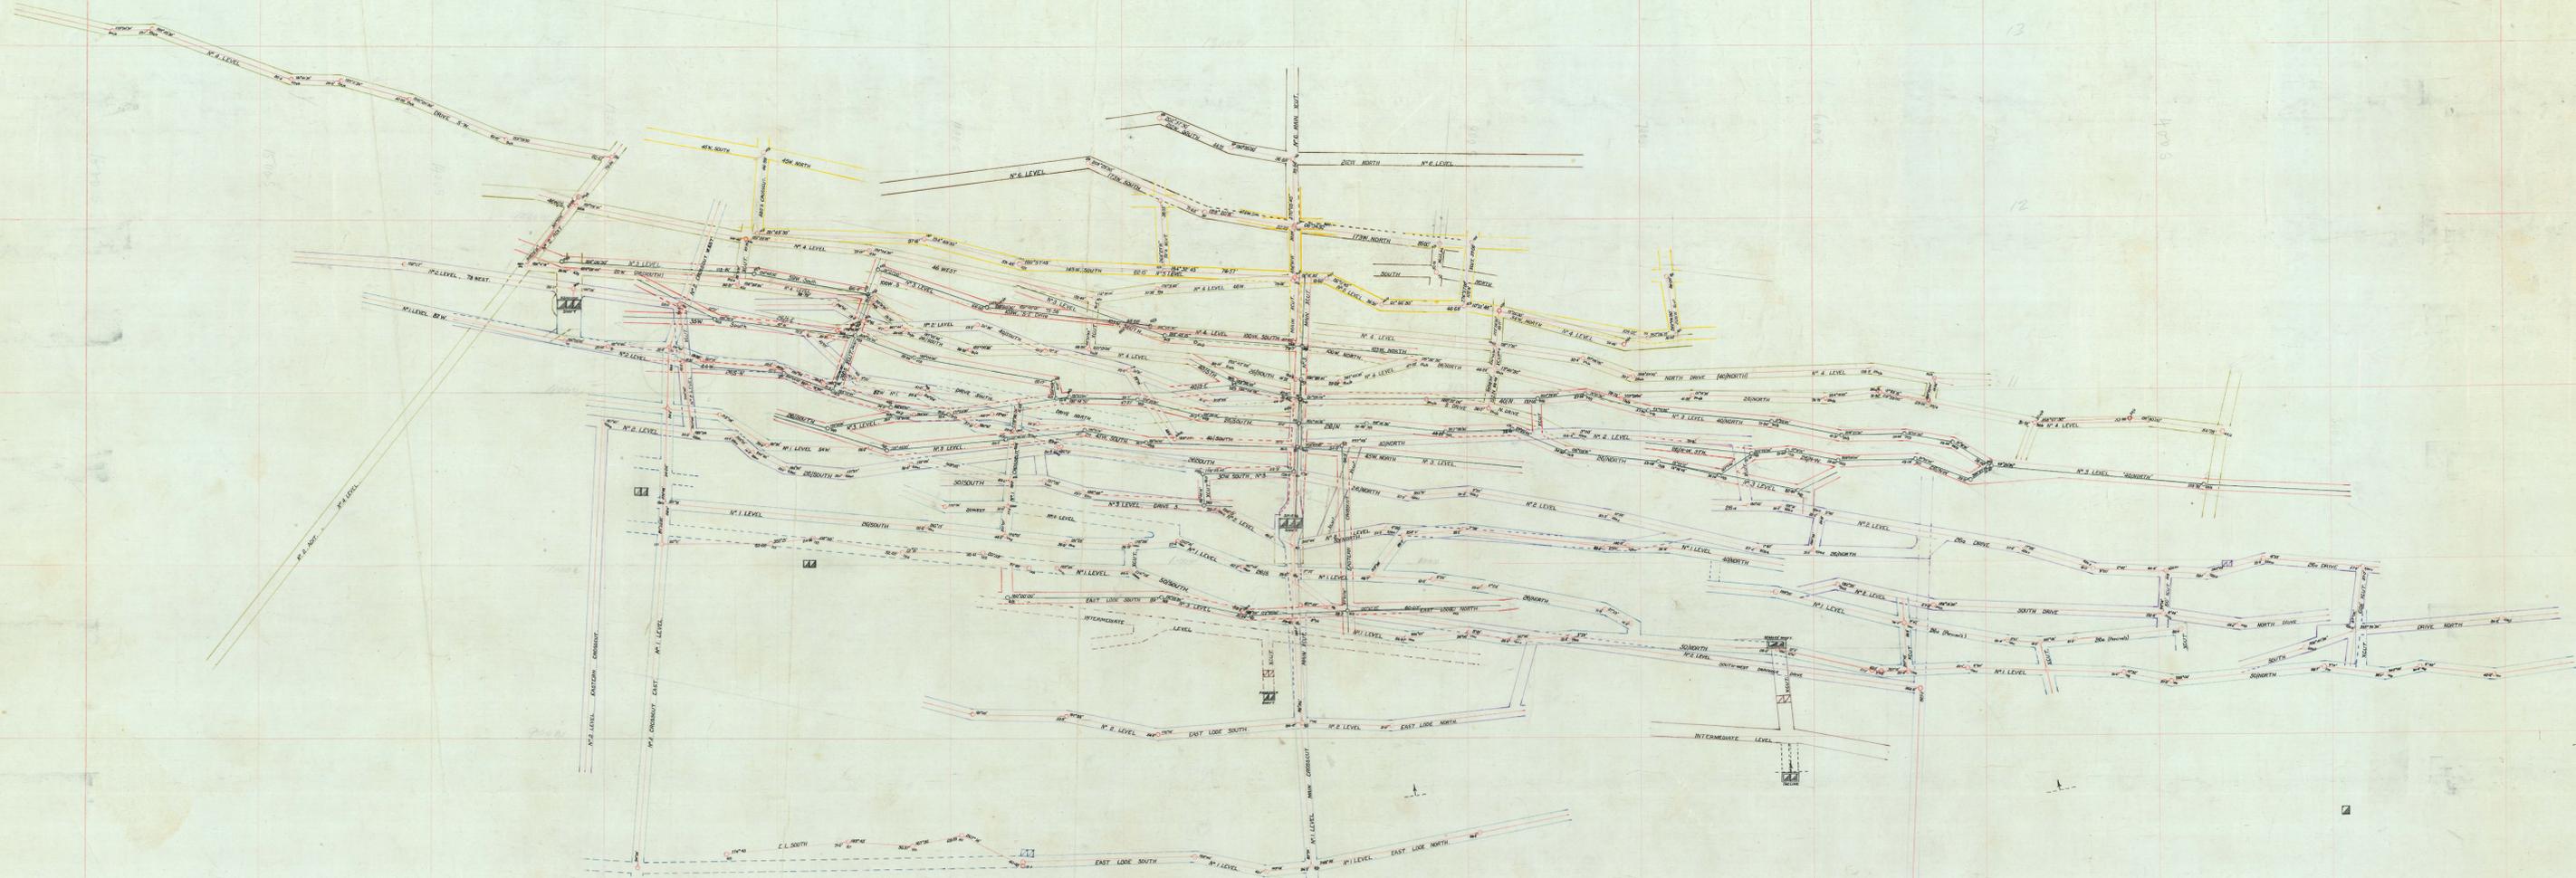

Coordinates relative to N-E Corner Peg of Consolidated Lease, N° 11013 M.