


ABERFOYLE TIN N.L.
ROSSARDEN, TAS.

— CROSS — SECTIONS —

Scale 30 ft = 1 inch

5 cm

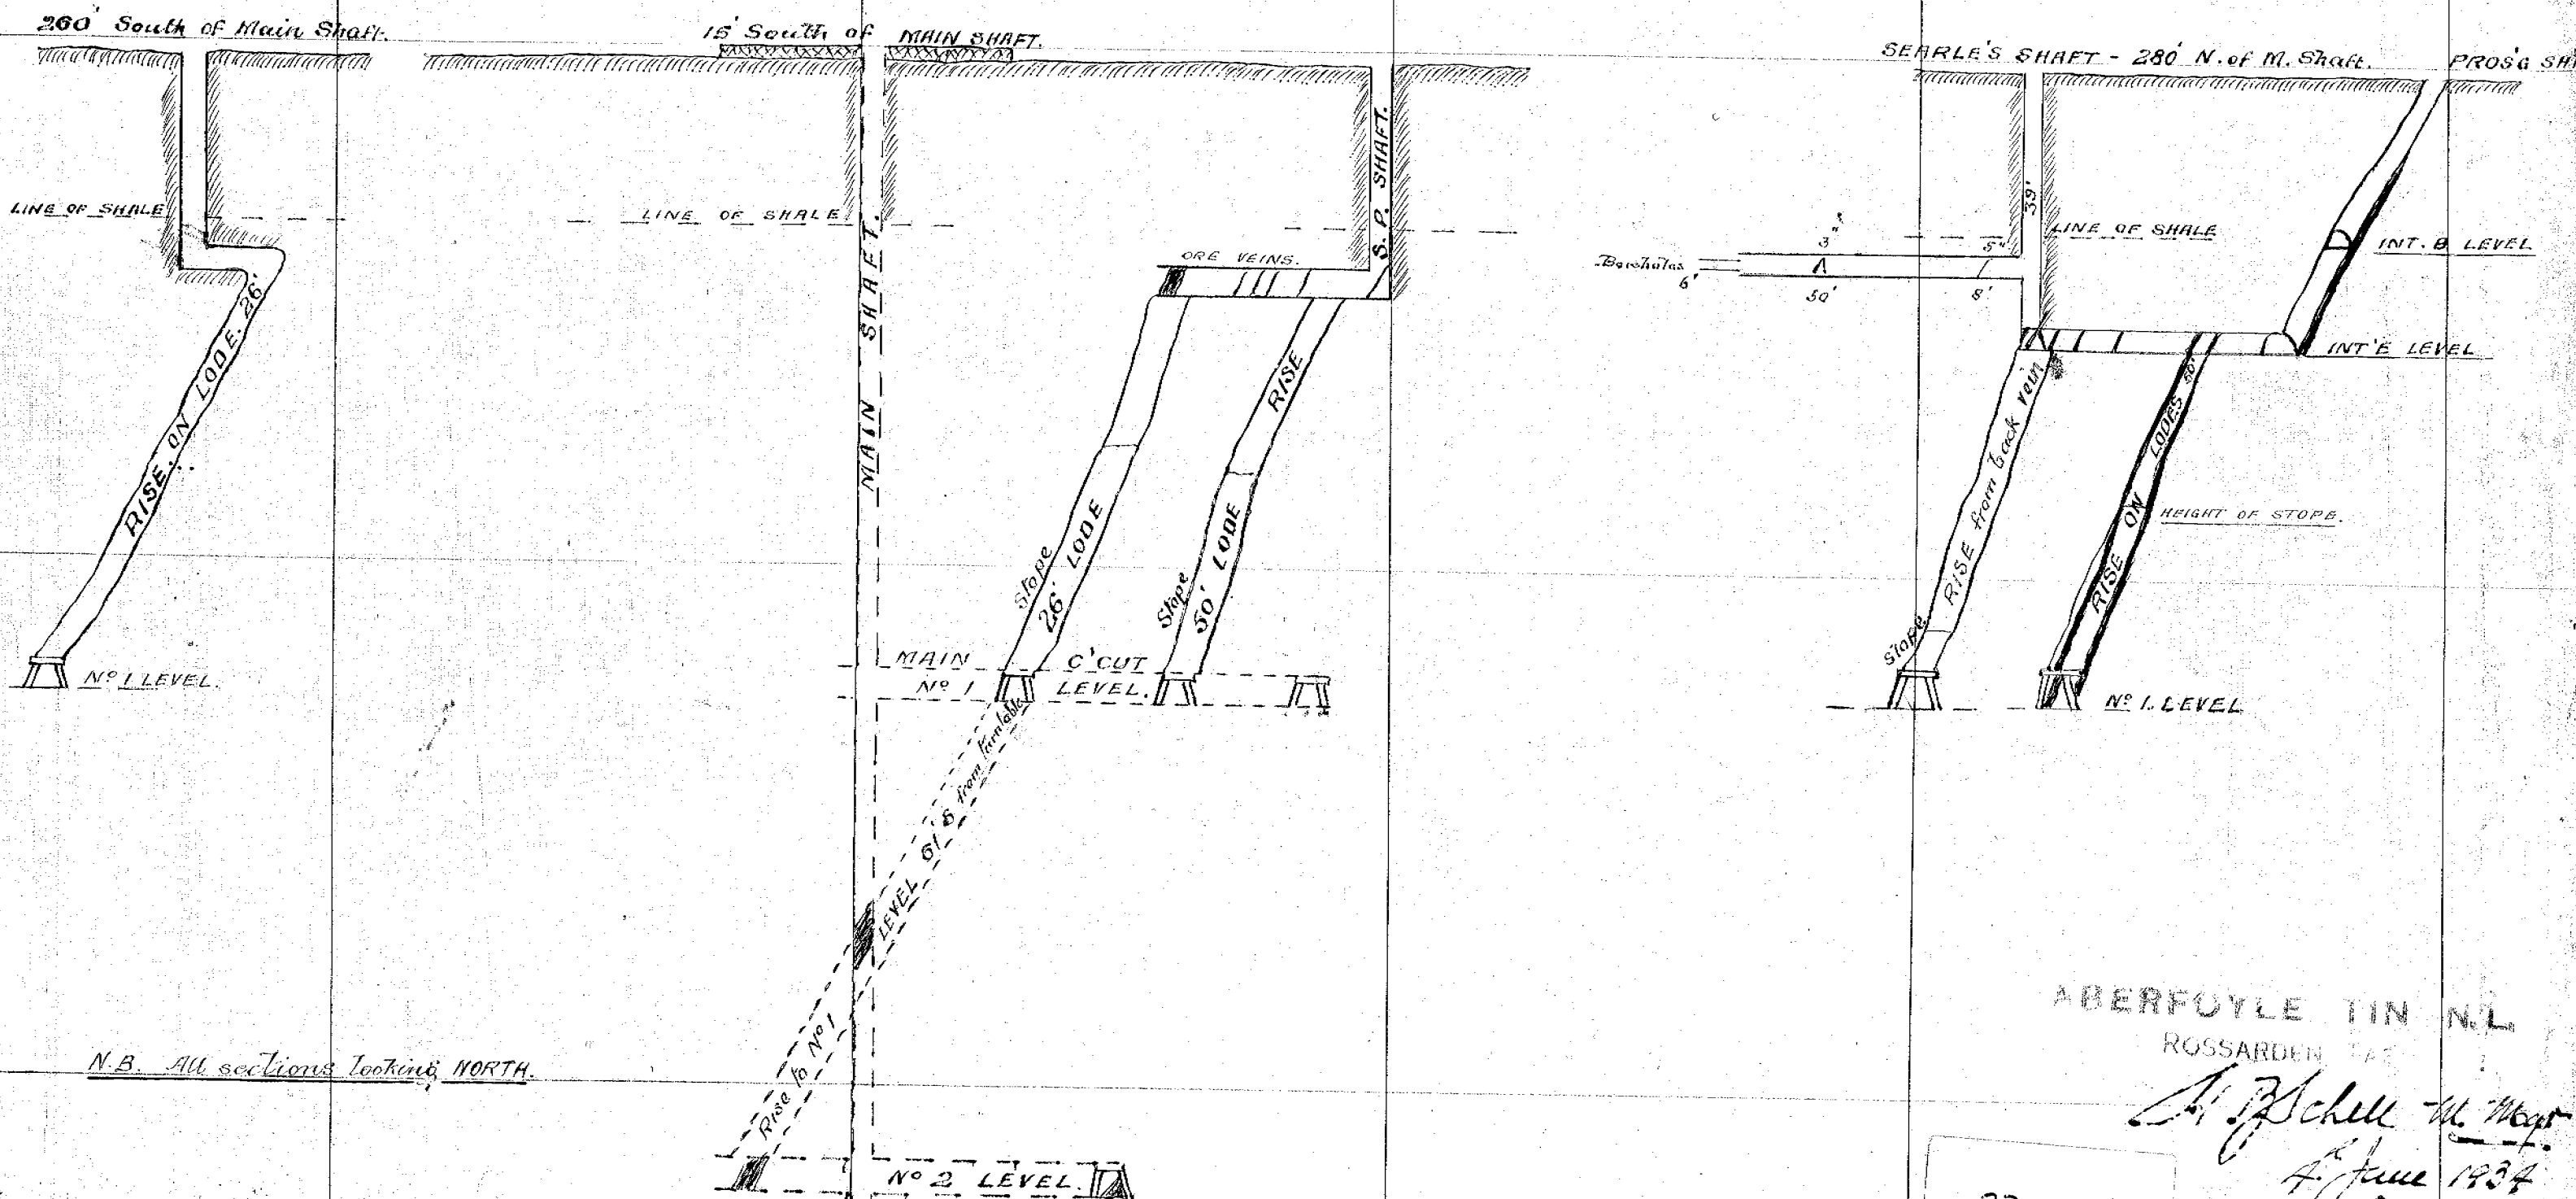

ABERFOYLE TIN N.L.
ROSSARDEN TAS.

A. J. Schell M. Magr.
4 June 1934

23-04

21.3.1935

47p

23-03
Too Large
23-04