


23-06

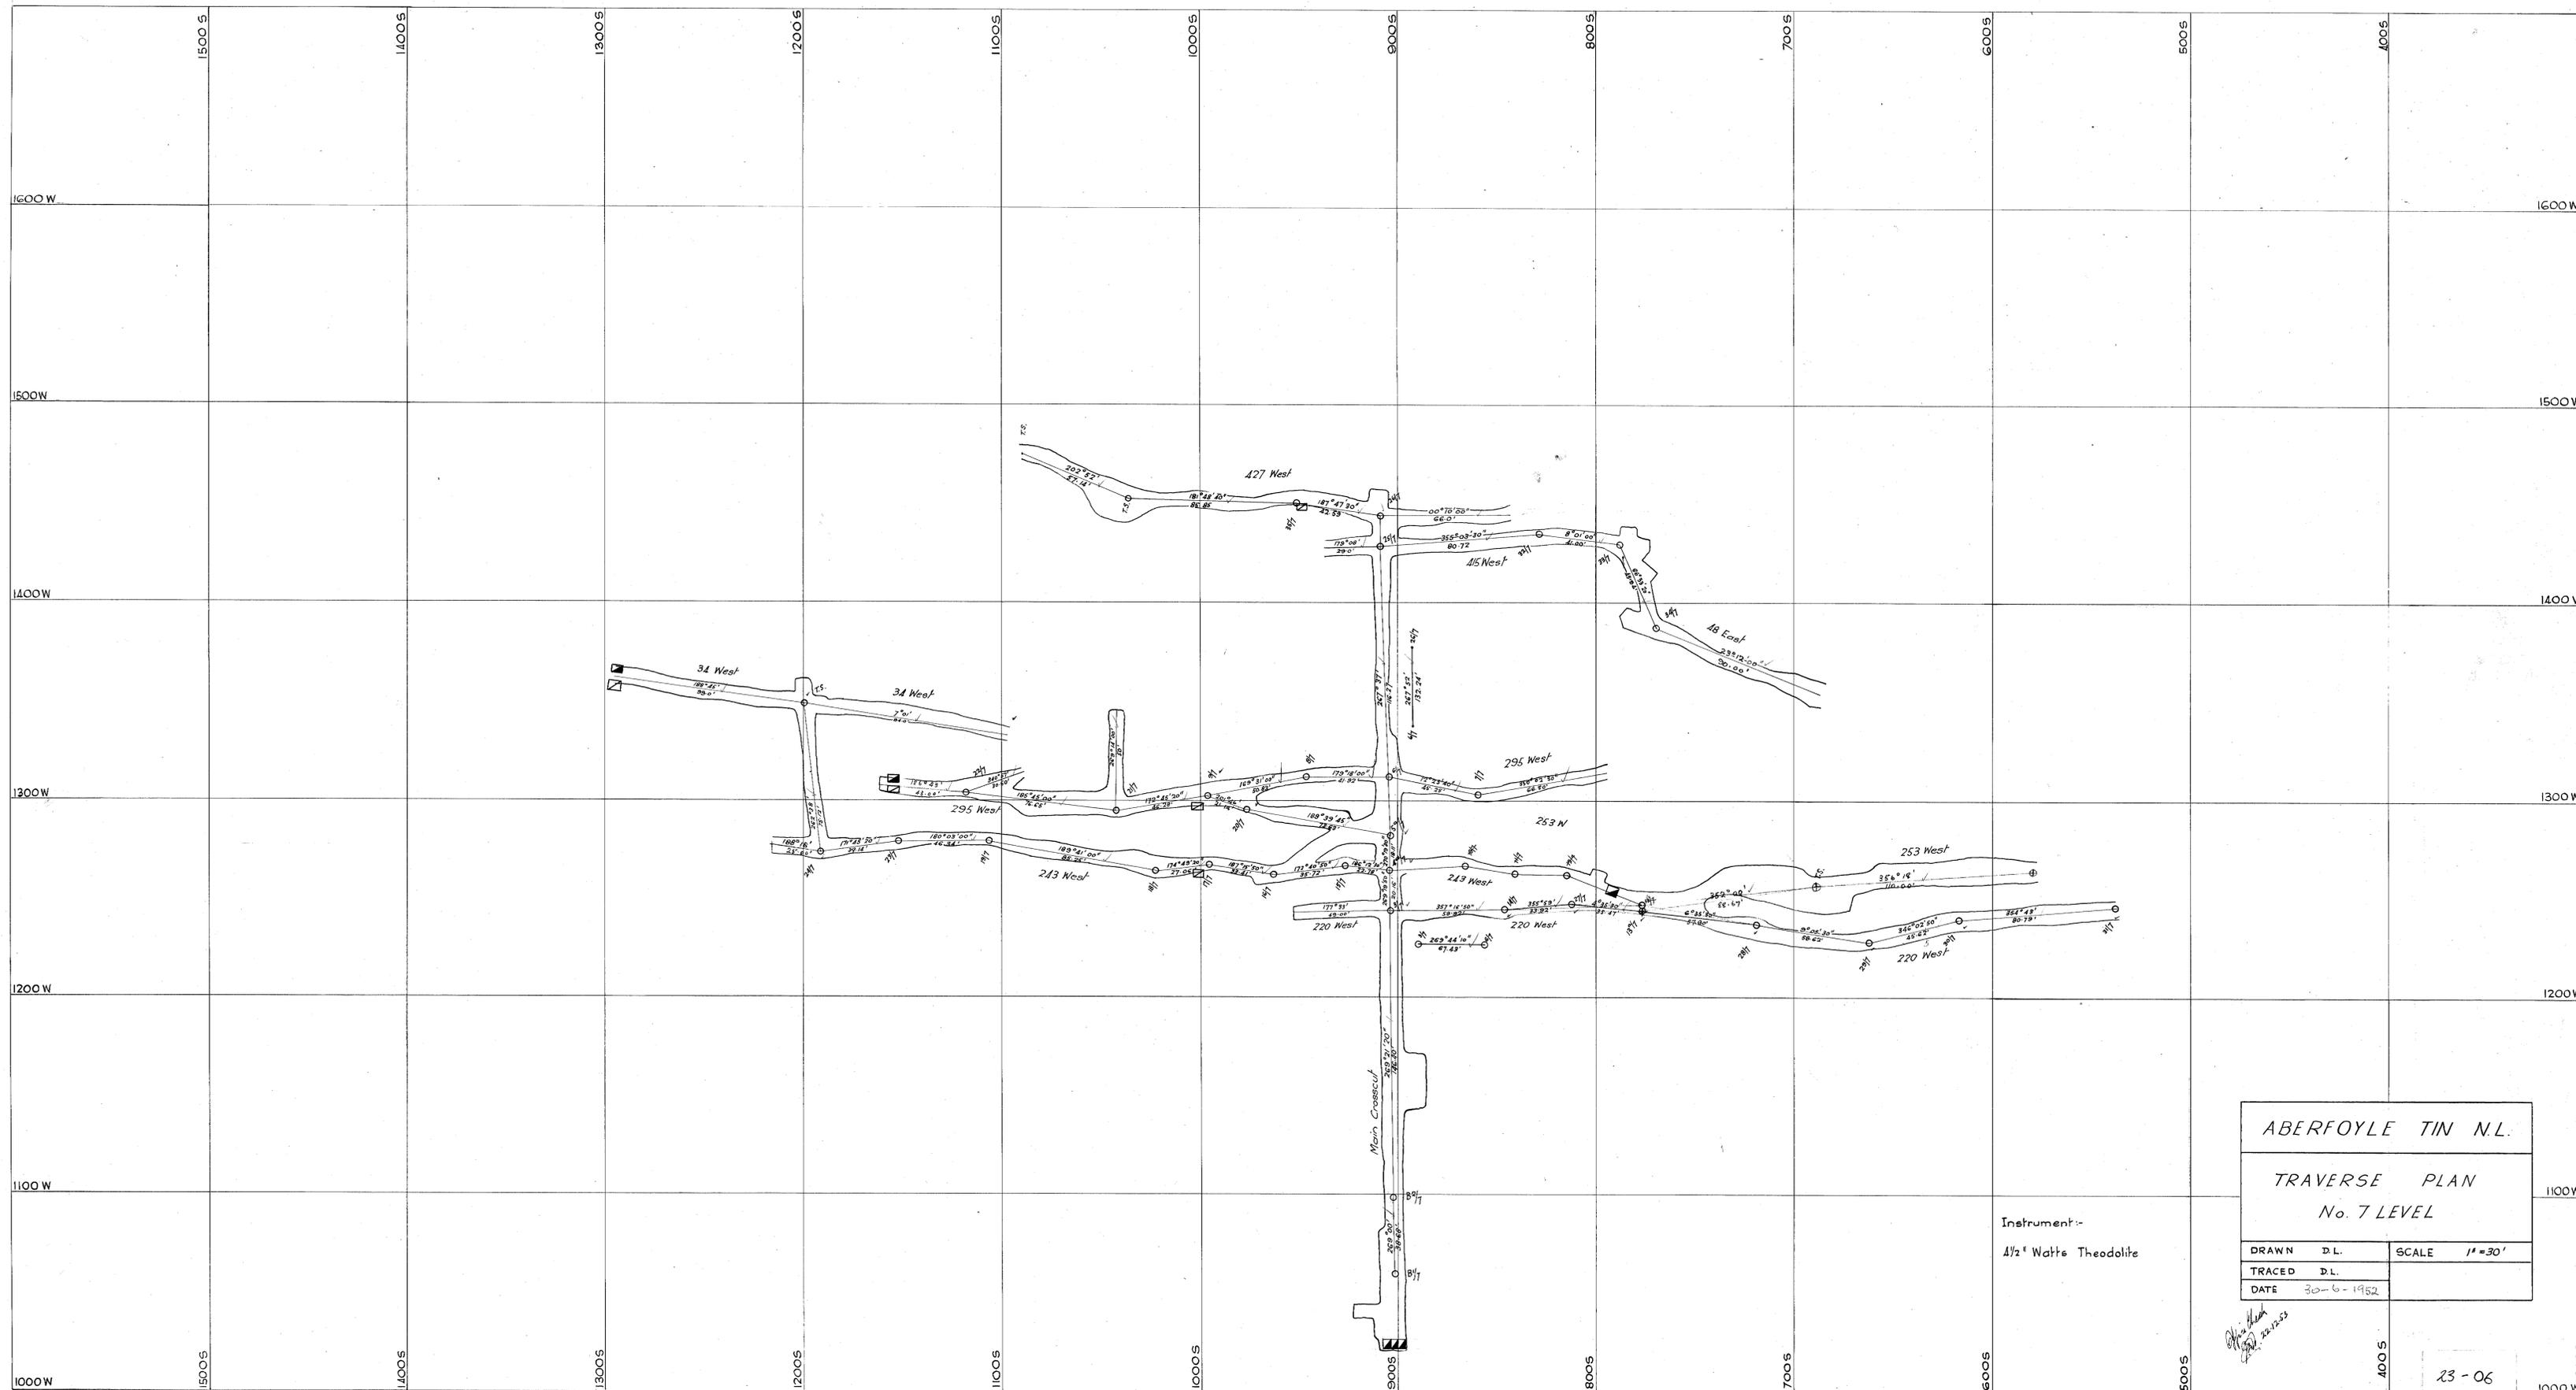

5 cm

ABERFOYLE TIN N.L.

TRAVERSE PLAN  
No. 7 LEVEL

DRAWN	D.L.	SCALE	1" = 30'
TRACED	D.L.		
DATE	30-6-1952		

Instrument:-  
4 1/2" Watta Theodolite

*[Handwritten signature]*  
30-6-1952