


23-07

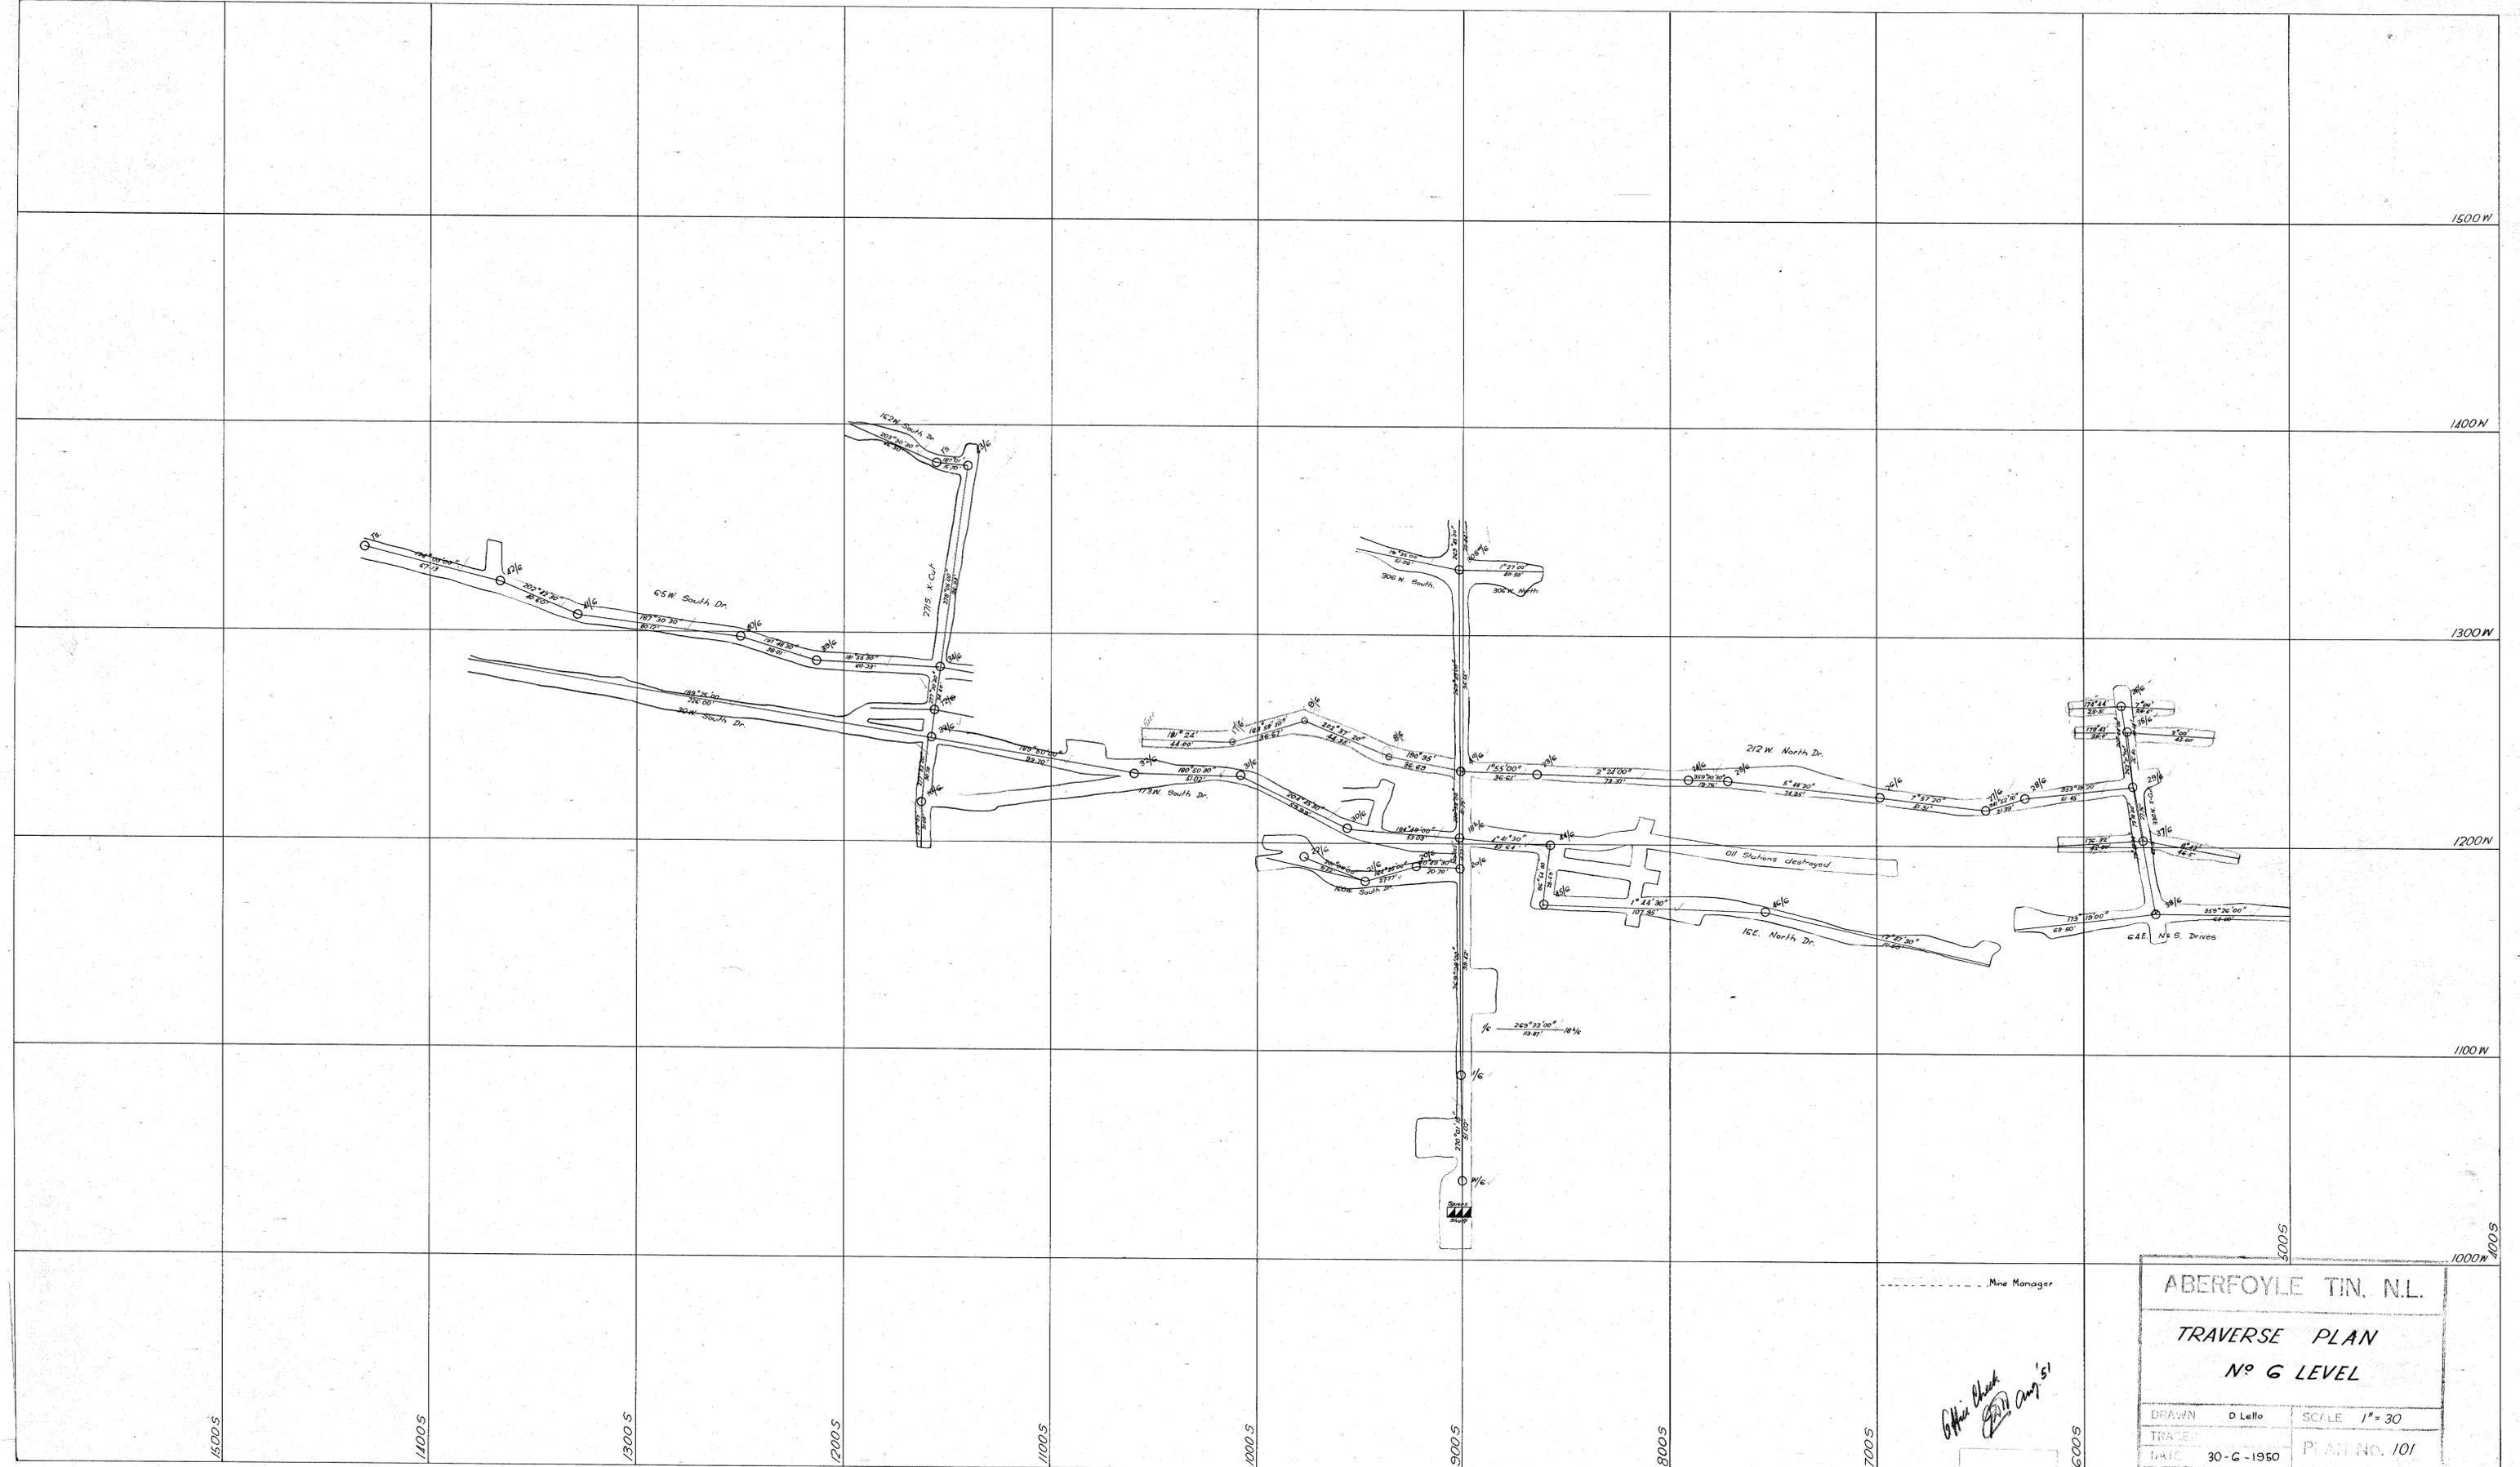

*John Black*  
23-07

ABERFOYLE TIN, N.L.	
TRAVERSE PLAN	
No 6 LEVEL	
DRAWN	D Lello
SCALE	1" = 30'
TRACE	
DATE	30-G-1950
PLAN NO.	101

23-07